FED. ROAD DIST. NO.	STATE	PROJ. NO.	FISCAL YEAR	SHEET NO.	TOTAL SHEETS
HAWAII	HAW.	HWY-0-02-76M	1976	1	11

INDEX TO DRAWINGS

SHEET NO.	DESCRIPTION
1	Title Sheet
2.	Repairs To Polipoli Bridge
3-4	Repair To Box Culvert
5-11	Standard Details

STATE OF HAWAII

DEPARTMENT OF TRANSPORTATION
HIGHWAYS DIVISION

HONOLULU, HAWAII

"AS-BUILT" PLANS FOR REPAIRS TO BOX CULVERT ON KAMEHAMEHA HIGHWAY DISTRICT OF KOOLAULOA

AND

POLIPOLI BRIDGE ON FARRINGTON HIGHWAY DISTRICT OF WAIALUA

PROJECT No. HWY-0-02-76M

ISLAND OF OAHU

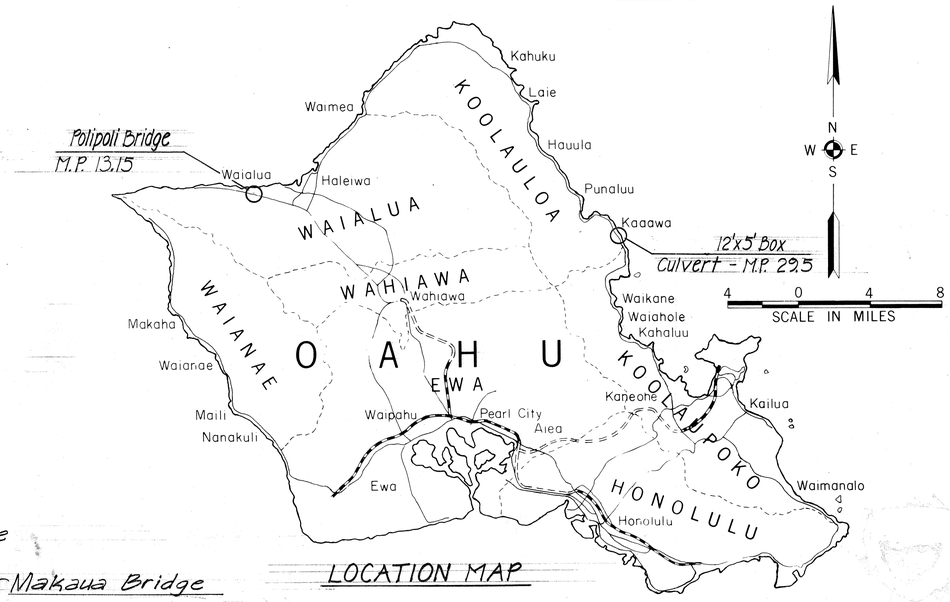

LOCATION MAP

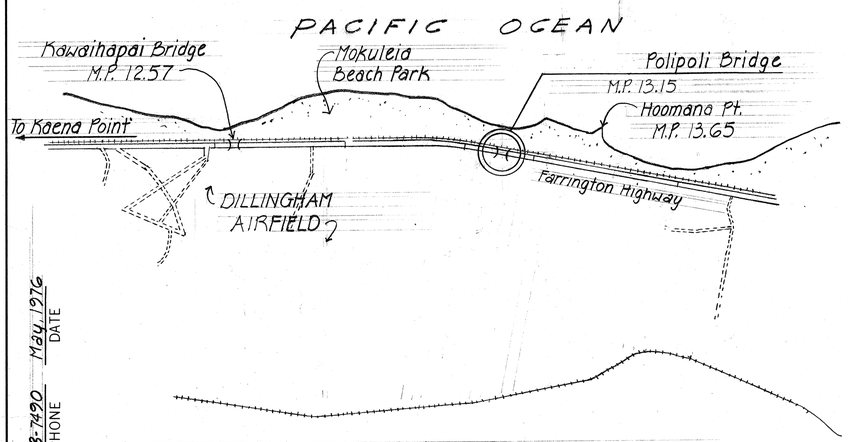

LOCATION PLAN

Not To Scale

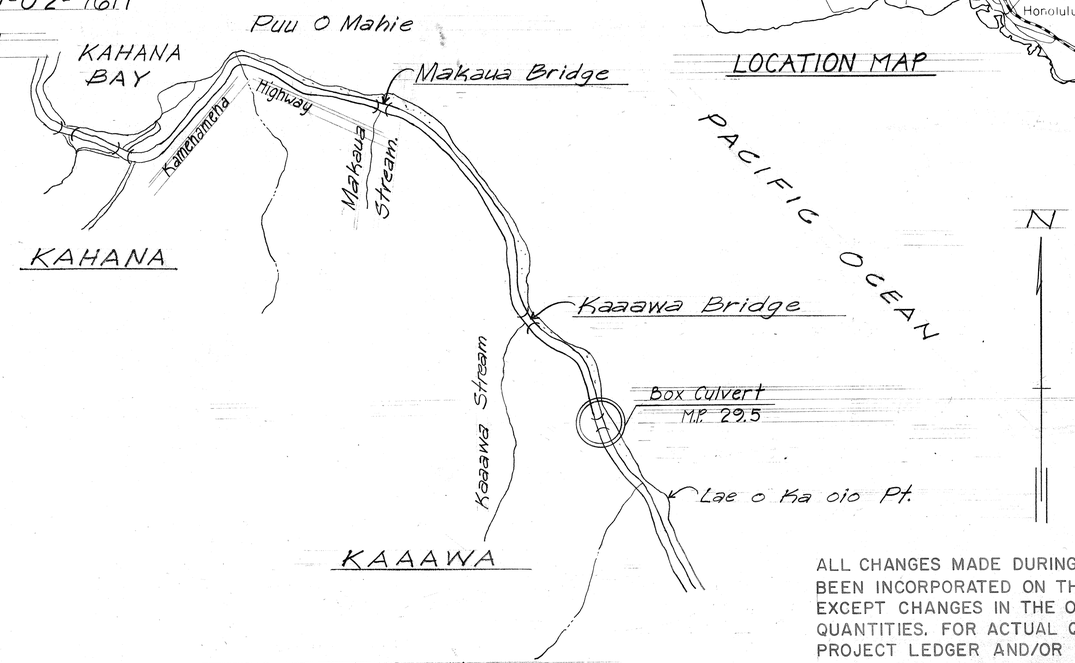

LOCATION PLAN

Not To Scale

ALL CHANGES MADE DURING CONSTRUCTION HAVE BEEN INCORPORATED ON THESE PLANS IN RED EXCEPT CHANGES IN THE ORIGINAL THEORETICAL QUANTITIES. FOR ACTUAL QUANTITIES, REFER TO PROJECT LEDGER AND/OR COMPUTATION BOOK.

David Samashwio — PROJECT ENGINEER — 3/8/78 DATE

DEPARTMENT OF TRANSPORTATION
STATE OF HAWAII

APPROVED:

for R. Higashionna — DIR. OF TRANSPORTATION — 6/9/76 DATE

DESIGNED BY	P. S. & E. BY	PHONE	DATE
HWY-DB	Mike Miura	548-7490	May 1976

Unit "C"