FED. ROAD DIST. NO.	STATE	FED. AID PROJ. NO.	FISCAL YEAR	SHEET NO.	TOTAL SHEETS
HAWAII	HAW.	PMS-0300 (9)	1979	1	3

INDEX TO DRAWINGS

SHEET NO.	DESCRIPTION
1	TITLE SHEET
2	TYPICAL DETAIL, DELINEATION AND PAVEMENT MARKING AT BRIDGES
3	STANDARD DETAILS

STATE OF HAWAII

DEPARTMENT OF TRANSPORTATION
HIGHWAYS DIVISION

"AS-BUILT" PLANS FOR

PAVEMENT MARKINGS AT VARIOUS BRIDGES ALONG ROUTE 83 AND ROUTE 99

FEDERAL AID PROJECT NO. PMS-0300 (9)

ISLAND OF OAHU

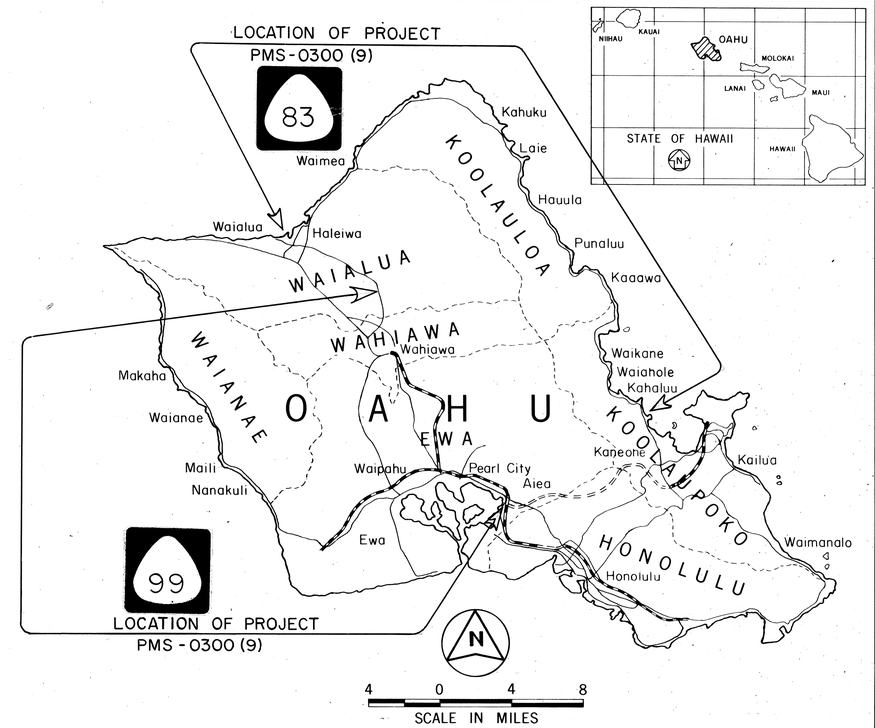

FEDERAL AID PROJECTS PREVIOUSLY CONSTRUCTED OR UNDER CONSTRUCTION.

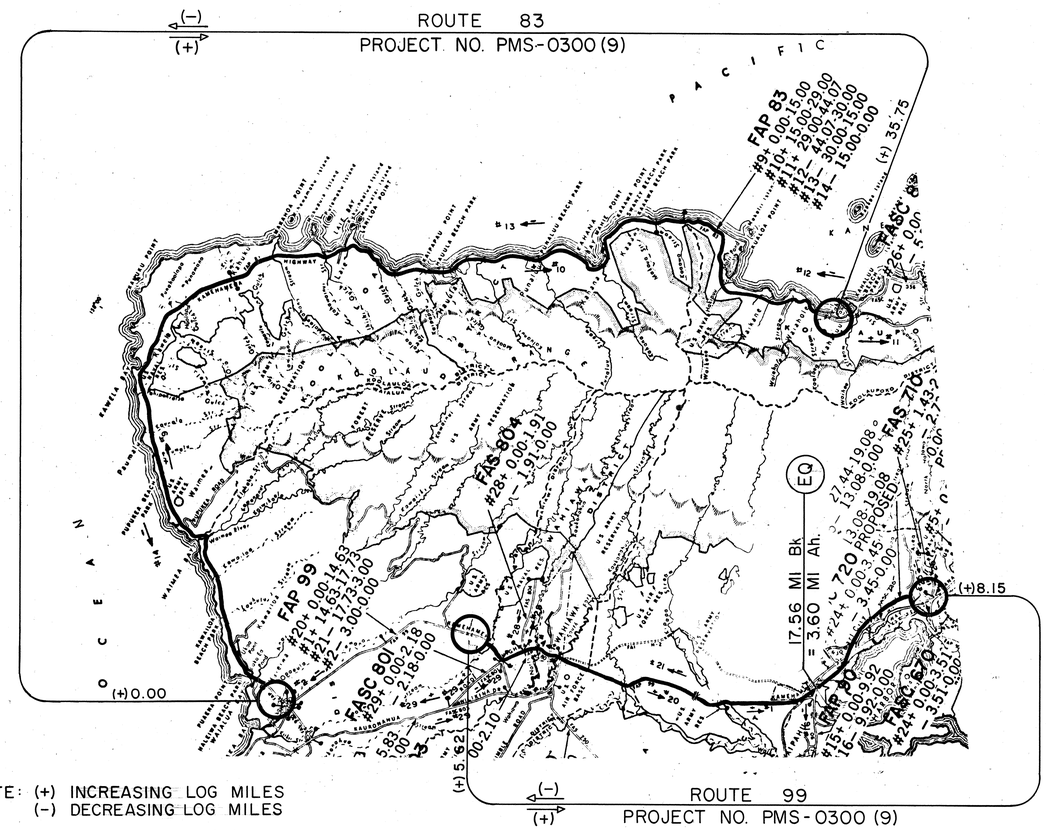

NOTE: (+) INCREASING LOG MILES
(-) DECREASING LOG MILES

LAYOUT PLAN

LENGTH OF PROJECT..... 56 MILES

ALL CHANGES MADE DURING CONSTRUCTION HAVE BEEN NOTED IN RED ON THESE TRACINGS AND CHECKED BY

RESIDENT ENGINEER — FEB. 4, 1980 DATE

DEPARTMENT OF TRANSPORTATION FEDERAL HIGHWAY ADMINISTRATION	
APPROVED: Cannon H. Jones for DIVISION ADMINISTRATOR	8-3-79 DATE

DEPARTMENT OF TRANSPORTATION STATE OF HAWAII	
APPROVED: James R. Carras for DIR. OF TRANSPORTATION	8/3/79 DATE

Traffic Design — DESIGNED BY
A. Nishimura — P. S. & E. BY
548-7537 — PHONE
July 1979 — DATE