FED.ROAD DIST.NO.	STATE	PROJ. NO.	FISCAL YEAR	SHEET NO.	TOTAL SHEETS
OAHU	HAW.	83G-01-10	2011	ADD38	38

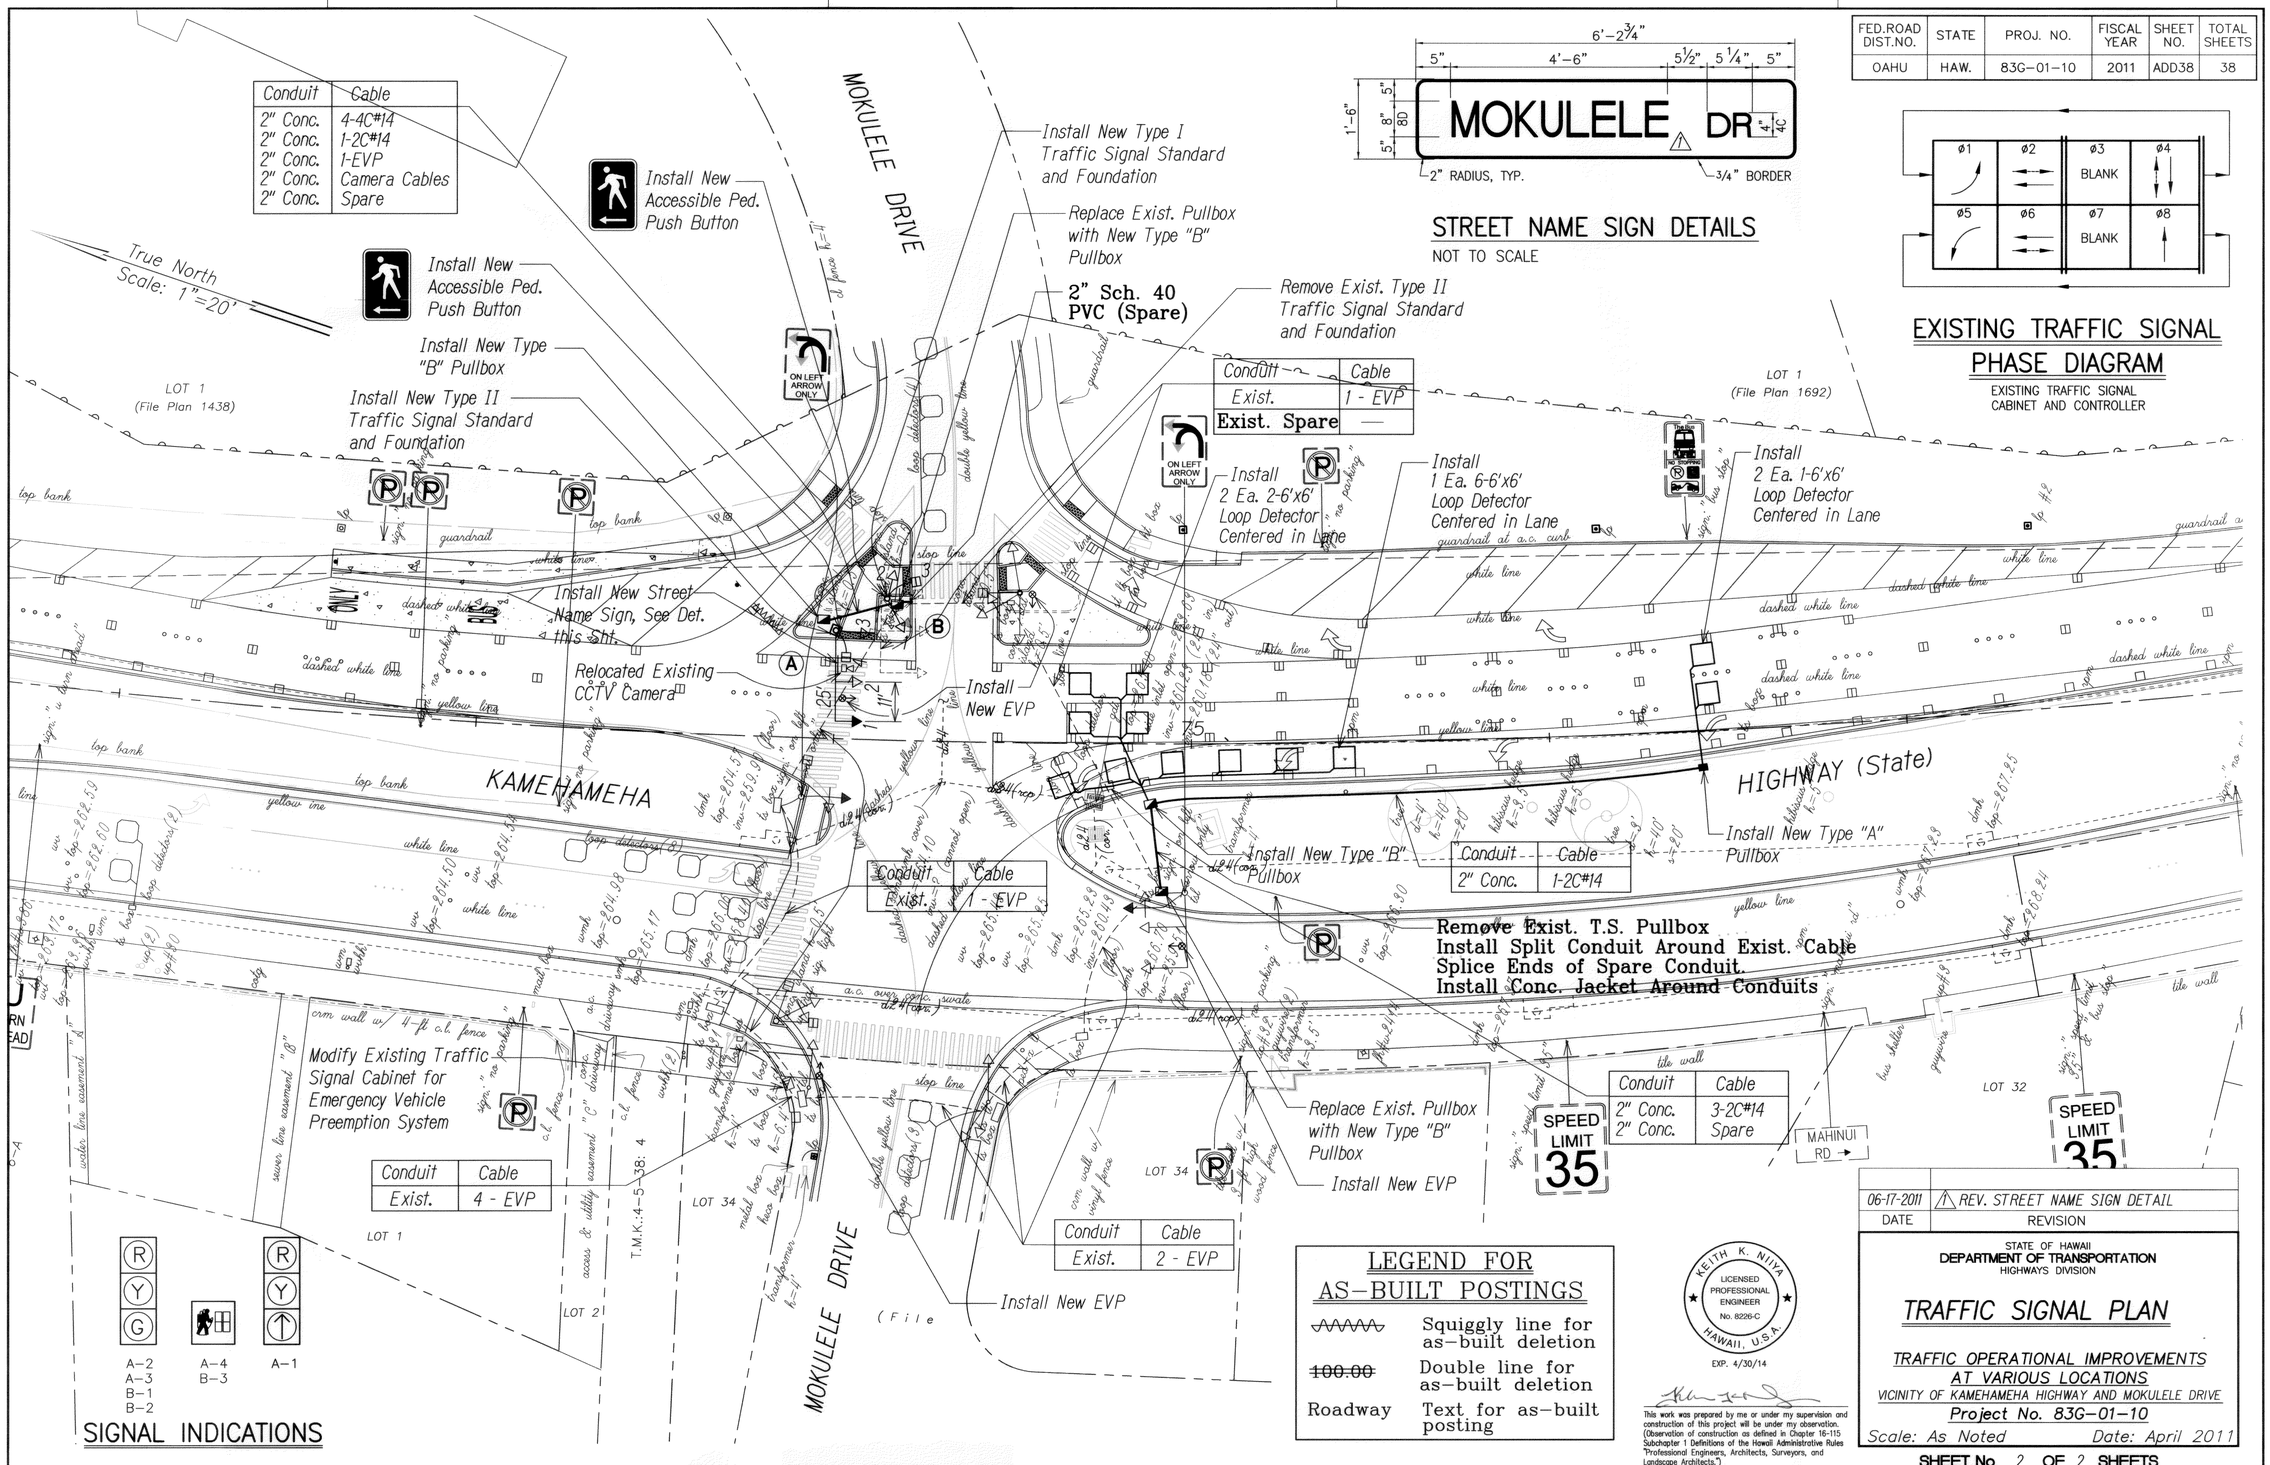

Conduit	Cable
2" Conc.	4-4C#14
2" Conc.	1-2C#14
2" Conc.	1-EVP
2" Conc.	Camera Cables
2" Conc.	Spare

Conduit	Cable
Exist.	1 - EVP
Exist. Spare	—

Conduit	Cable
Exist.	1 - EVP

Conduit	Cable
2" Conc.	1-2C#14

Conduit	Cable
2" Conc.	3-2C#14
2" Conc.	Spare

Conduit	Cable
Exist.	4 - EVP

Conduit	Cable
Exist.	2 - EVP

STREET NAME SIGN DETAILS

NOT TO SCALE

EXISTING TRAFFIC SIGNAL PHASE DIAGRAM

EXISTING TRAFFIC SIGNAL CABINET AND CONTROLLER

SIGNAL INDICATIONS

LEGEND FOR AS-BUILT POSTINGS

∧∧∧∧∧	Squiggly line for as-built deletion
~~100.00~~	Double line for as-built deletion
Roadway	Text for as-built posting

KEITH K. NIIYA
LICENSED PROFESSIONAL ENGINEER
No. 8226-C
HAWAII, U.S.A.
EXP. 4/30/14

This work was prepared by me or under my supervision and construction of this project will be under my observation. (Observation of construction as defined in Chapter 16-115 Subchapter 1 Definitions of the Hawaii Administrative Rules "Professional Engineers, Architects, Surveyors, and Landscape Architects.")

DATE	REVISION
06-17-2011	REV. STREET NAME SIGN DETAIL

STATE OF HAWAII
DEPARTMENT OF TRANSPORTATION
HIGHWAYS DIVISION

TRAFFIC SIGNAL PLAN

TRAFFIC OPERATIONAL IMPROVEMENTS AT VARIOUS LOCATIONS
VICINITY OF KAMEHAMEHA HIGHWAY AND MOKULELE DRIVE
Project No. 83G-01-10

Scale: As Noted Date: April 2011

SHEET No. 2 OF 2 SHEETS

"AS-BUILT"

ADD 38

ORIGINAL PLAN	SURVEY PLOTTED BY	DATE
	DRAWN BY	
	TRACED BY	
NOTE BOOK	DESIGNED BY	
	QUANTITIES BY	
No.	CHECKED BY	