FED. ROAD DIST. NO.	STATE	PROJ. NO.	FISCAL YEAR	SHEET NO.	TOTAL SHEETS
HAWAII	HAW.	83C-01-81M	1981	1	14

INDEX TO DRAWINGS

SHEET NO.	DESCRIPTION
1	TITLE SHEET
2	TYPICAL DETAILS
3	GENERAL NOTES, TYPICAL SECTIONS AND PLAN
3 - 7	PLANS
8 - 12	PAVEMENT MARKINGS
13 - 14	STANDARD DETAILS
COADD.7S-1	DRAINAGE PLAN

NEW TOTAL SHEET COUNT = 15 SHEETS

STATE OF HAWAII

DEPARTMENT OF TRANSPORTATION

HIGHWAYS DIVISION

HONOLULU, HAWAII

"AS-BUILT"

PLANS FOR

RESURFACING A PORTION OF

KAMEHAMEHA HIGHWAY

HAUULA HOMESTEAD ROAD TOWARDS PAKELO LANE

PROJECT NO. 83C-01-81M

DISTRICT OF KOOLAULOA

ISLAND OF OAHU

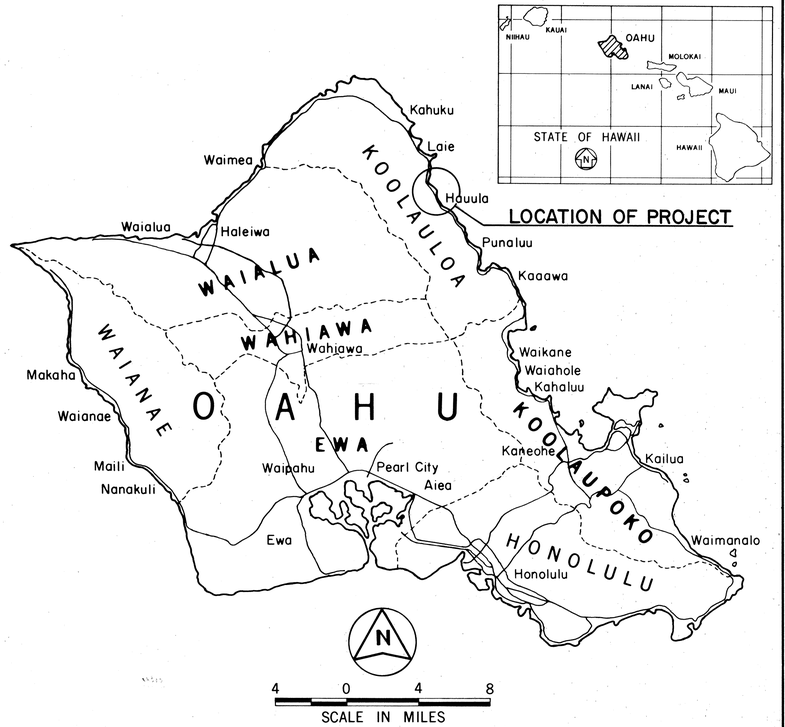

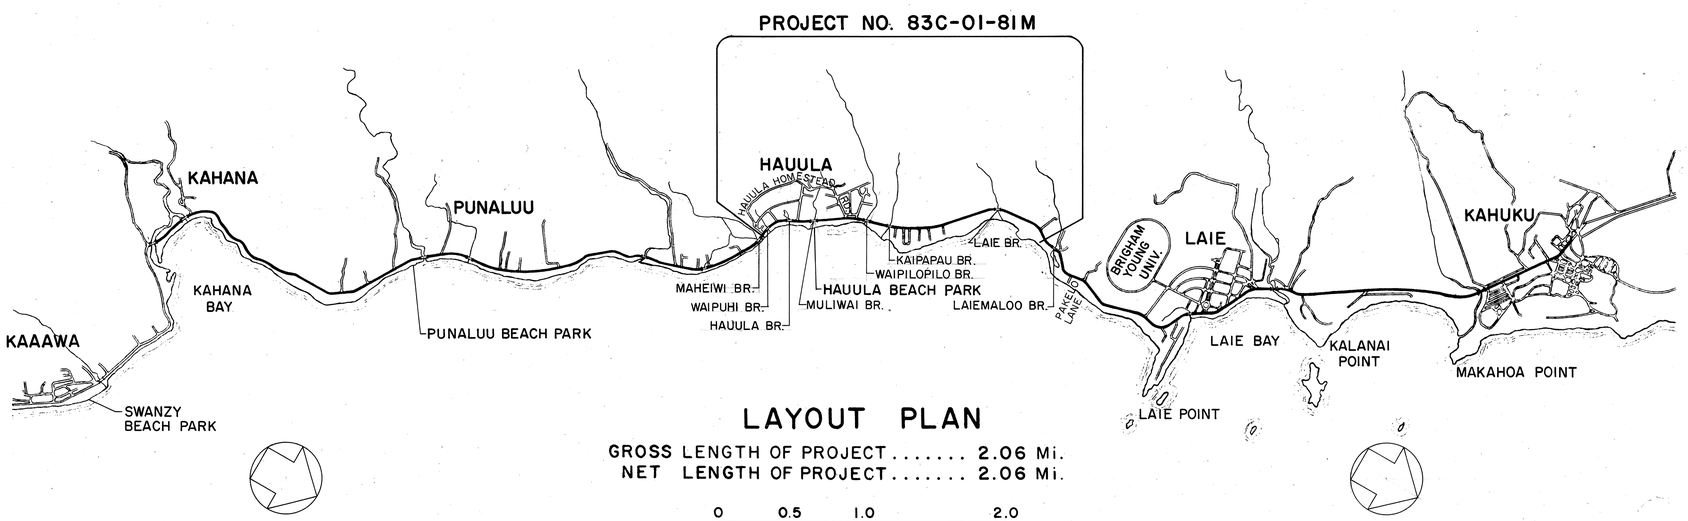

LAYOUT PLAN

GROSS LENGTH OF PROJECT ..... 2.06 Mi.
NET LENGTH OF PROJECT ..... 2.06 Mi.

0 0.5 1.0 2.0
SCALE IN MILES

ALL CHANGES MADE DURING CONSTRUCTION HAVE BEEN INCORPORATED ON THESE PLANS IN RED EXCEPT CHANGES IN THE ORIGINAL THEORETICAL QUANTITIES. FOR ACTUAL QUANTITIES, REFER TO PROJECT LEDGER AND/OR COMPUTATION BOOK.

RESIDENT ENGINEER — DATE: 9-16-81

R. TSUZUKI	R. TSUZUKI	548-2456
DESIGNED BY	P. S. & E. BY	PHONE

Oct. 1980
DATE

DEPARTMENT OF TRANSPORTATION
STATE OF HAWAII
APPROVED:
DIR. OF TRANSPORTATION — DATE 10/10/80

5-4-81