FED. ROAD DIST. NO.	STATE	PROJ. NO.	FISCAL YEAR	SHEET NO.	TOTAL SHEETS
HAWAII	HAW.	BR-083-1(48)	2021	32	161

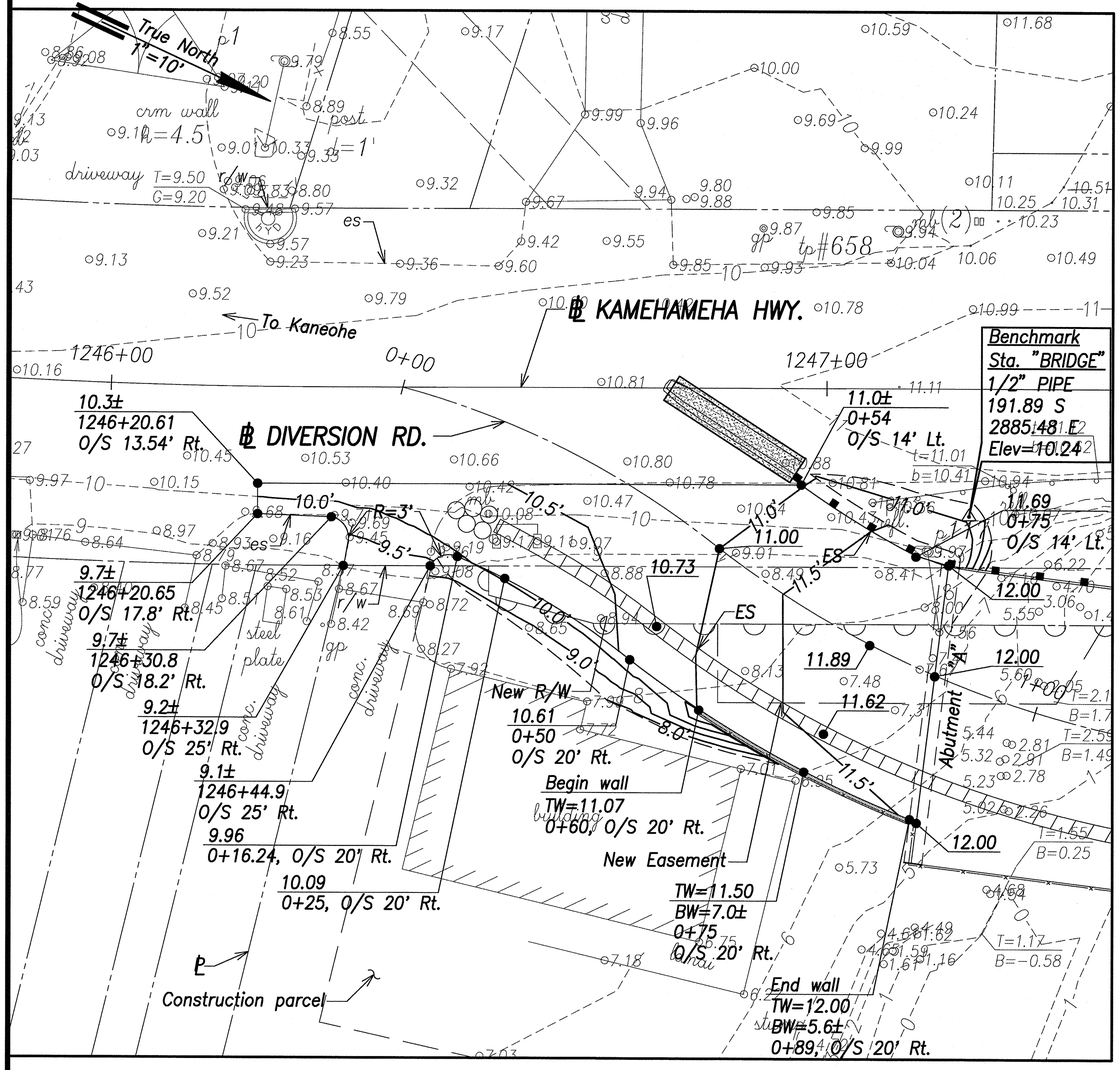

DIVERSION ROAD ENLARGED SITE & ELEVATION PLAN (KANEOHE SIDE)

Scale: 1"=10'

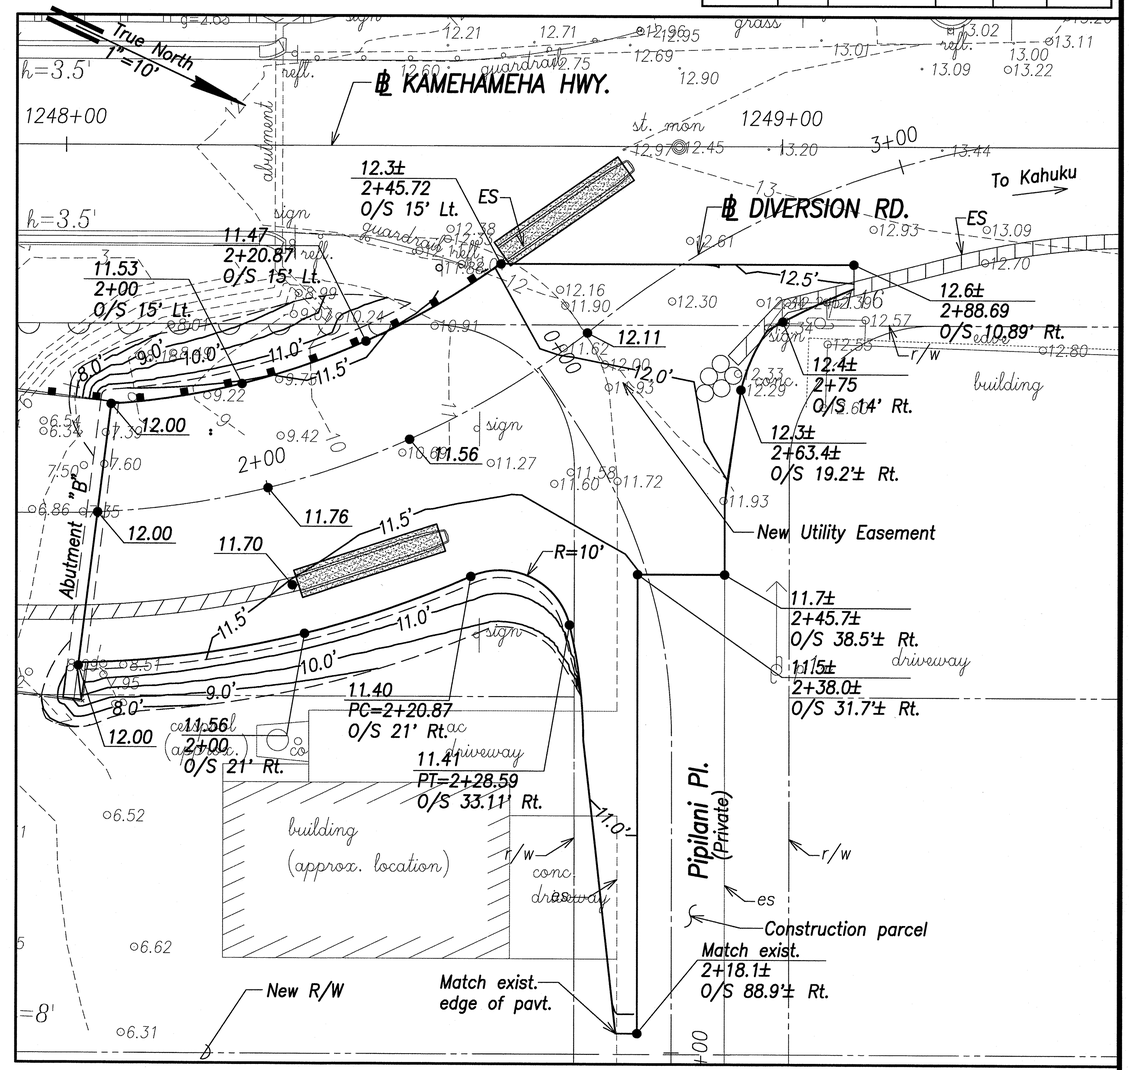

DIVERSION ROAD ENLARGED SITE & ELEVATION PLAN (KAHUKU SIDE)

Scale: 1"=10'

Legend:

---------10---------	Exist. Ground Contour
———10.0'———	Finished Grade Contour
10.00	Finished Grade Elevation
2+37.40	℄ Station
O/S 31.3' Rt.	℄ Offset

Graphic Scale:

1" = 10' 10' 5' 0 10' 20'

Scale in Feet

WALTER G. C. CHONG
LICENSED PROFESSIONAL ENGINEERS
No. 8882-C
HAWAII, U.S.A.

THIS WORK WAS PREPARED BY ME OR UNDER MY SUPERVISION AND CONSTRUCTION OF THIS PROJECT WILL BE UNDER MY OBSERVATION. "OBSERVATION OF CONSTRUCTION" IS DEFINED IN CHAPTER 16-115, HAWAII ADMINISTRATIVE RULES, ENTITLED "PROFESSIONAL ENGINEERS, ARCHITECTS, SURVEYORS AND LANDSCAPE ARCHITECTS."

4/30/22
SIGNATURE LIC. EXPIRATION
R. M. TOWILL CORPORATION

STATE OF HAWAII
DEPARTMENT OF TRANSPORTATION
HIGHWAYS DIVISION

DIVERSION ROAD ENLARGED SITE & ELEVATION PLAN

Kamehameha Highway
Kaipapau Stream Bridge Replacement
Federal Aid Project No. BR-083-1(48)

Scale: As Noted Date: February 2021

SHEET No. C-30 OF SHEETS

ORIGINAL PLAN
SURVEY PLOTTED BY DATE
TRACED BY
DESIGNED BY
NOTE BOOK
QUANTITIES BY
CHECKED BY
No.

RMTC JOB NO. : 1-19548-0E