FED. ROAD DIST. NO.	STATE	PROJ. NO.	FISCAL YEAR	SHEET NO.	TOTAL SHEETS
HAWAII	HAW.	BR-083-1(48)	2021	37	161

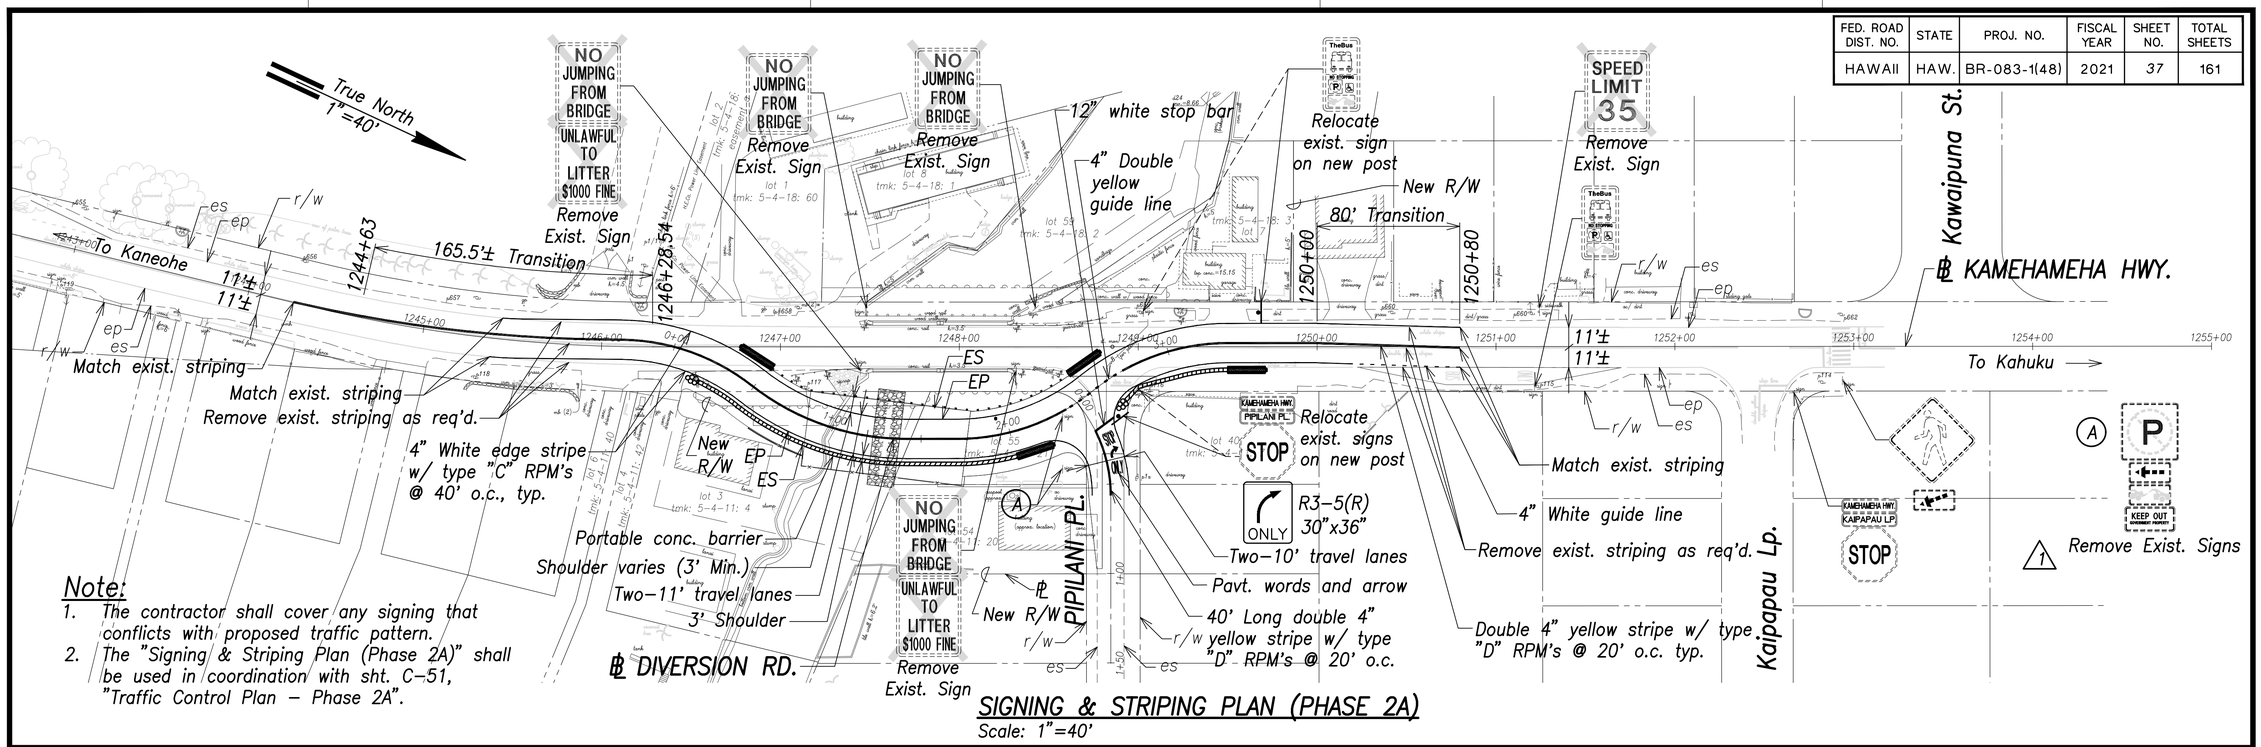

Note:

1. The contractor shall cover any signing that conflicts with proposed traffic pattern.
2. The "Signing & Striping Plan (Phase 2A)" shall be used in coordination with sht. C-51, "Traffic Control Plan – Phase 2A".

SIGNING & STRIPING PLAN (PHASE 2A)

Scale: 1"=40'

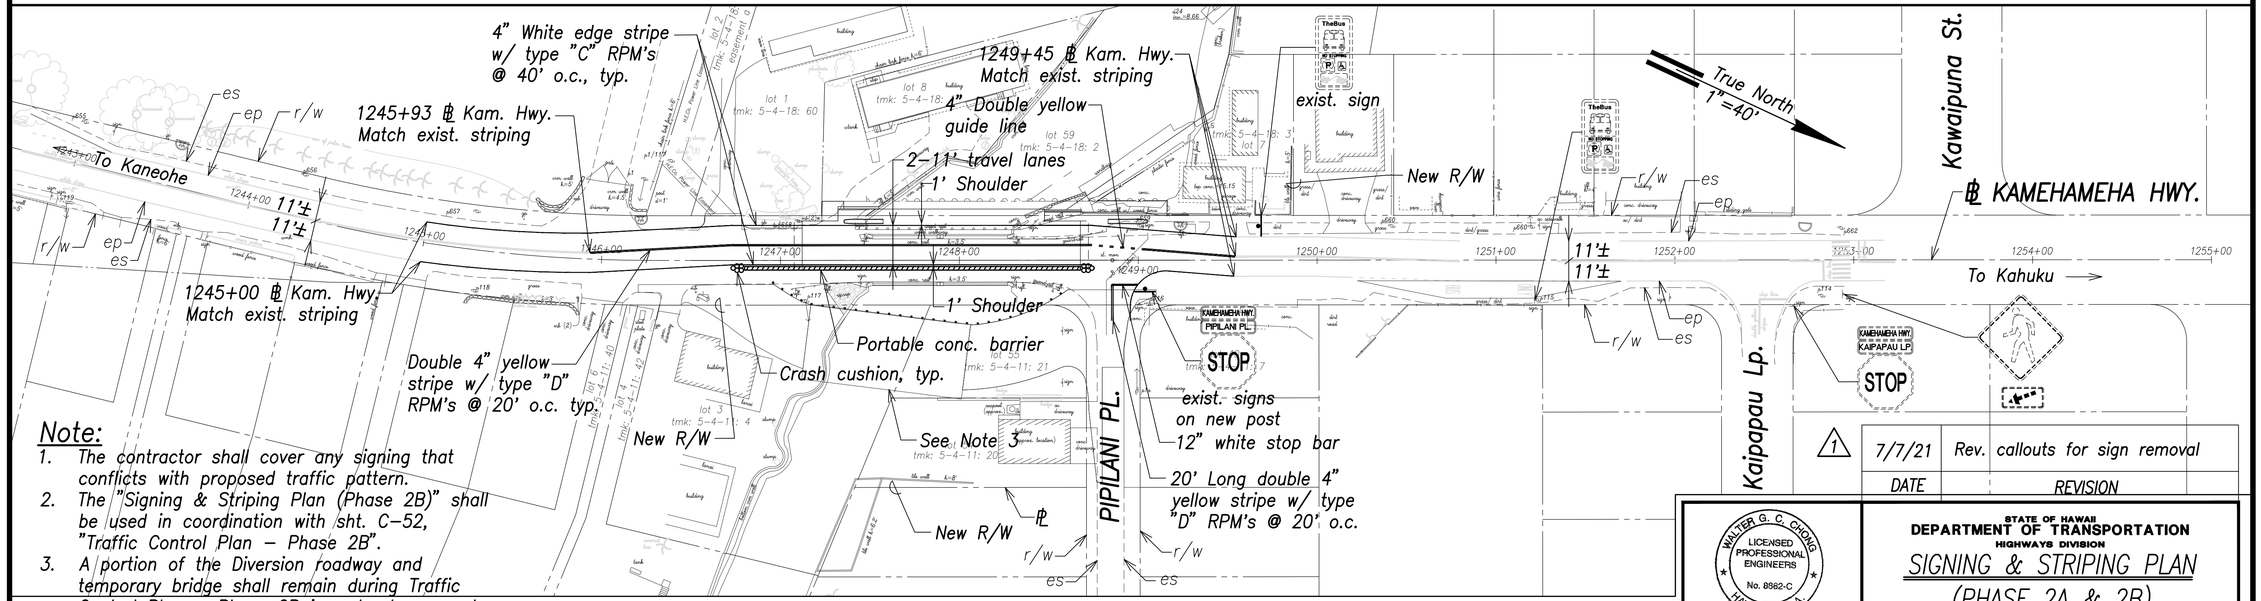

Note:

1. The contractor shall cover any signing that conflicts with proposed traffic pattern.
2. The "Signing & Striping Plan (Phase 2B)" shall be used in coordination with sht. C-52, "Traffic Control Plan – Phase 2B".
3. A portion of the Diversion roadway and temporary bridge shall remain during Traffic Control Plan – Phase 2B in order to support the temporary waterline. No vehicle or pedestrian traffic shall be allowed on Diversion roadway.

SIGNING & STRIPING PLAN (PHASE 2B)

Scale: 1"=40'

Graphic Scale:

1" = 40' 40' 20' 0 40' 80'

Scale in Feet

1	7/7/21	Rev. callouts for sign removal
	DATE	REVISION

SURVEY PLOTTED BY	DATE
DRAWN BY	BSY
TRACED BY	
REVIEWED BY	WC
QUANTITIES BY	
CHECKED BY	
ORIGINAL PLAN	
NOTE BOOK	
No.	

WALTER G. C. CHONG
LICENSED PROFESSIONAL ENGINEERS
No. 8982-C
HAWAII, U.S.A.

THIS WORK WAS PREPARED BY ME OR UNDER MY SUPERVISION AND CONSTRUCTION OF THIS PROJECT WILL BE UNDER MY OBSERVATION. "OBSERVATION OF CONSTRUCTION" IS DEFINED IN CHAPTER 16-115, HAWAII ADMINISTRATIVE RULES, ENTITLED "PROFESSIONAL ENGINEERS, ARCHITECTS, SURVEYORS AND LANDSCAPE ARCHITECTS."

SIGNATURE 4/30/22 LIC. EXPIRATION

R. M. TOWILL CORPORATION

STATE OF HAWAII
DEPARTMENT OF TRANSPORTATION
HIGHWAYS DIVISION

SIGNING & STRIPING PLAN (PHASE 2A & 2B)

Kamehameha Highway
Kaipapau Stream Bridge Replacement
Federal Aid Project No. BR-083-1(48)

Scale: As Noted Date: February 2021

SHEET No. C-35 OF SHEETS

RMTC JOB NO. : 1-19548-0E