FED. ROAD DIST. NO.	STATE	FED. AID PROJ. NO.	FISCAL YEAR	SHEET NO.	TOTAL SHEETS
HAWAII	HAW.	FR-083-1(14) HES-083-1(16)	1981	1	30

INDEX TO DRAWINGS

SHEET NO.	DESCRIPTION
1	TITLE SHEET
2-3	GENERAL NOTES, TYPICAL SECTIONS & MISC. DETAILS
4-7	PLANS
8	INTERSECTION DETAIL
9-14	SPECIAL, TYPICAL & STANDARD ROADWAY DETAILS
15-17	SIGNING & PAVEMENT MARKING PLANS
18-25	SIGNING & PAVEMENT MARKING STANDARD DETAILS
26	TRAFFIC SIGNAL PLAN
27-30	TRAFFIC SIGNAL STANDARD DETAILS

STATE OF HAWAII

DEPARTMENT OF TRANSPORTATION

HIGHWAYS DIVISION

"AS-BUILT"

PLANS FOR

KAHEKILI HIGHWAY RESURFACING

VALLEY OF THE TEMPLES TO AHUIMANU STREAM BRIDGE

FED. AID PROJ. NO. FR-083-1(14)

AND

KAHEKILI HIGHWAY INTERSECTION IMPROVEMENTS AT HUI IWA STREET

FED. AID PROJ. NO. HES-083-1(16)

DISTRICT OF KOOLAUPOKO

ISLAND OF OAHU

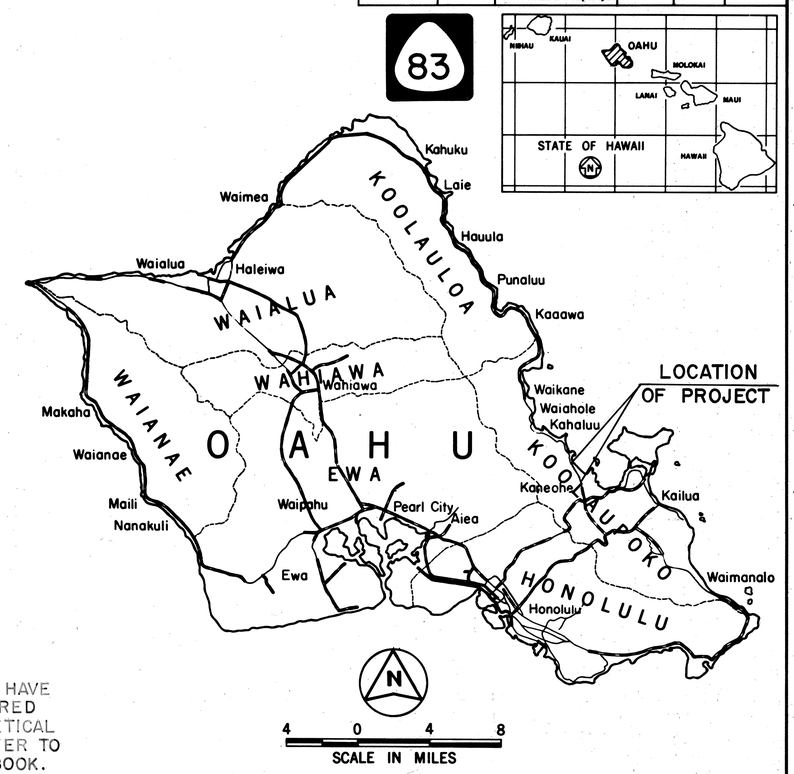

ALL CHANGES MADE DURING CONSTRUCTION HAVE BEEN INCORPORATED ON THESE PLANS IN RED EXCEPT CHANGES IN THE ORIGINAL THEORETICAL QUANTITIES. FOR ACTUAL QUANTITIES, REFER TO PROJECT LEDGER AND/OR COMPUTATION BOOK.

Robert Y. Muronaka — RESIDENT ENGINEER

4-5-82 — DATE

FEDERAL AID PROJECTS PREVIOUSLY CONSTRUCTED OR UNDER CONSTRUCTION

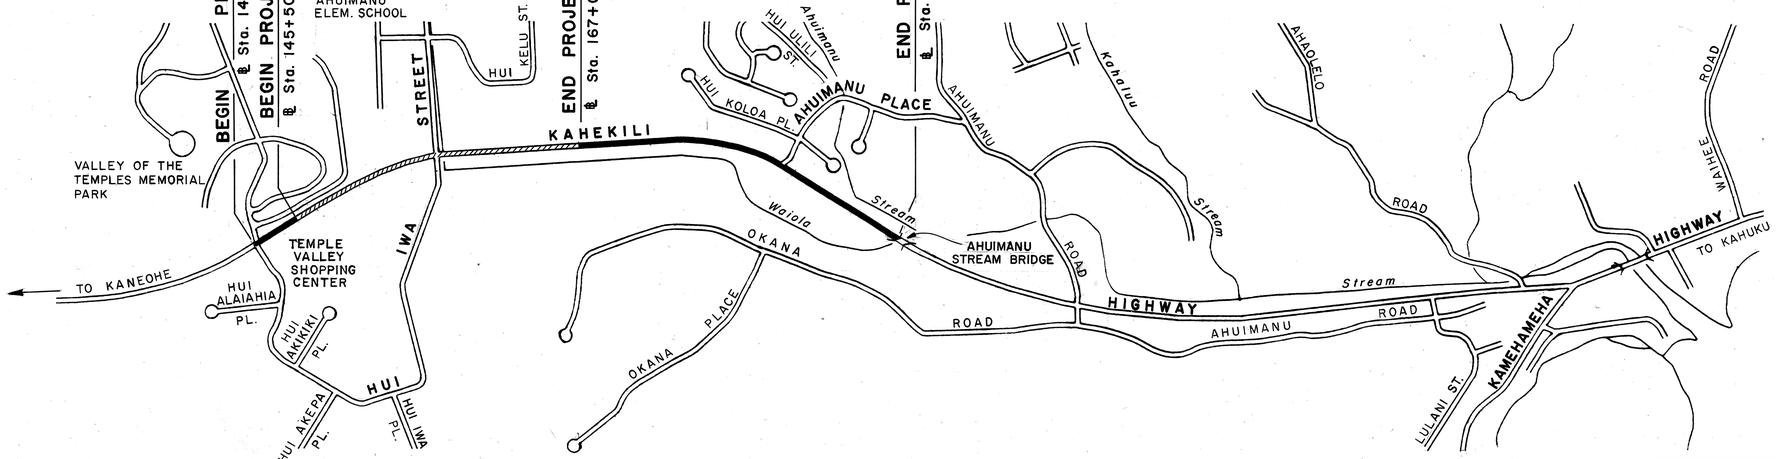

LAYOUT PLAN

DESIGN DESIGNATION

DESIGN ADT (2000)	25,700
DHV	3,200
D	80/20
T	45 %
V	60 MPH

PROJ. NO. FR-083-1(14)

Gross Length of Project ..... 0.928 Miles
Exception ..... 0.407 Miles
Net Length of Project ..... 0.521 Miles

PROJ. NO. HES-083-1(16)

Gross Length of Project ..... 0.407 Miles
Net Length of Project ..... 0.407 Miles

DEPARTMENT OF TRANSPORTATION
FEDERAL HIGHWAY ADMINISTRATION
APPROVED:
Cannon H. Jones — 6-1-81
for DIVISION ADMINISTRATOR — DATE

DEPARTMENT OF TRANSPORTATION
STATE OF HAWAII
APPROVED:
James R. Carras — 5/20/81
DIR. OF TRANSPORTATION — DATE

A. Nishimura — DESIGNED BY
A. Nishimura — P. S. & E. BY
548-7537 — PHONE
May, 1981 — DATE