


FED. ROAD DIST. NO.	STATE	PROJ. NO.	FISCAL YEAR	SHEET NO.	TOTAL SHEETS
HAWAII	HAW.	83B-01-09	2023	24	231

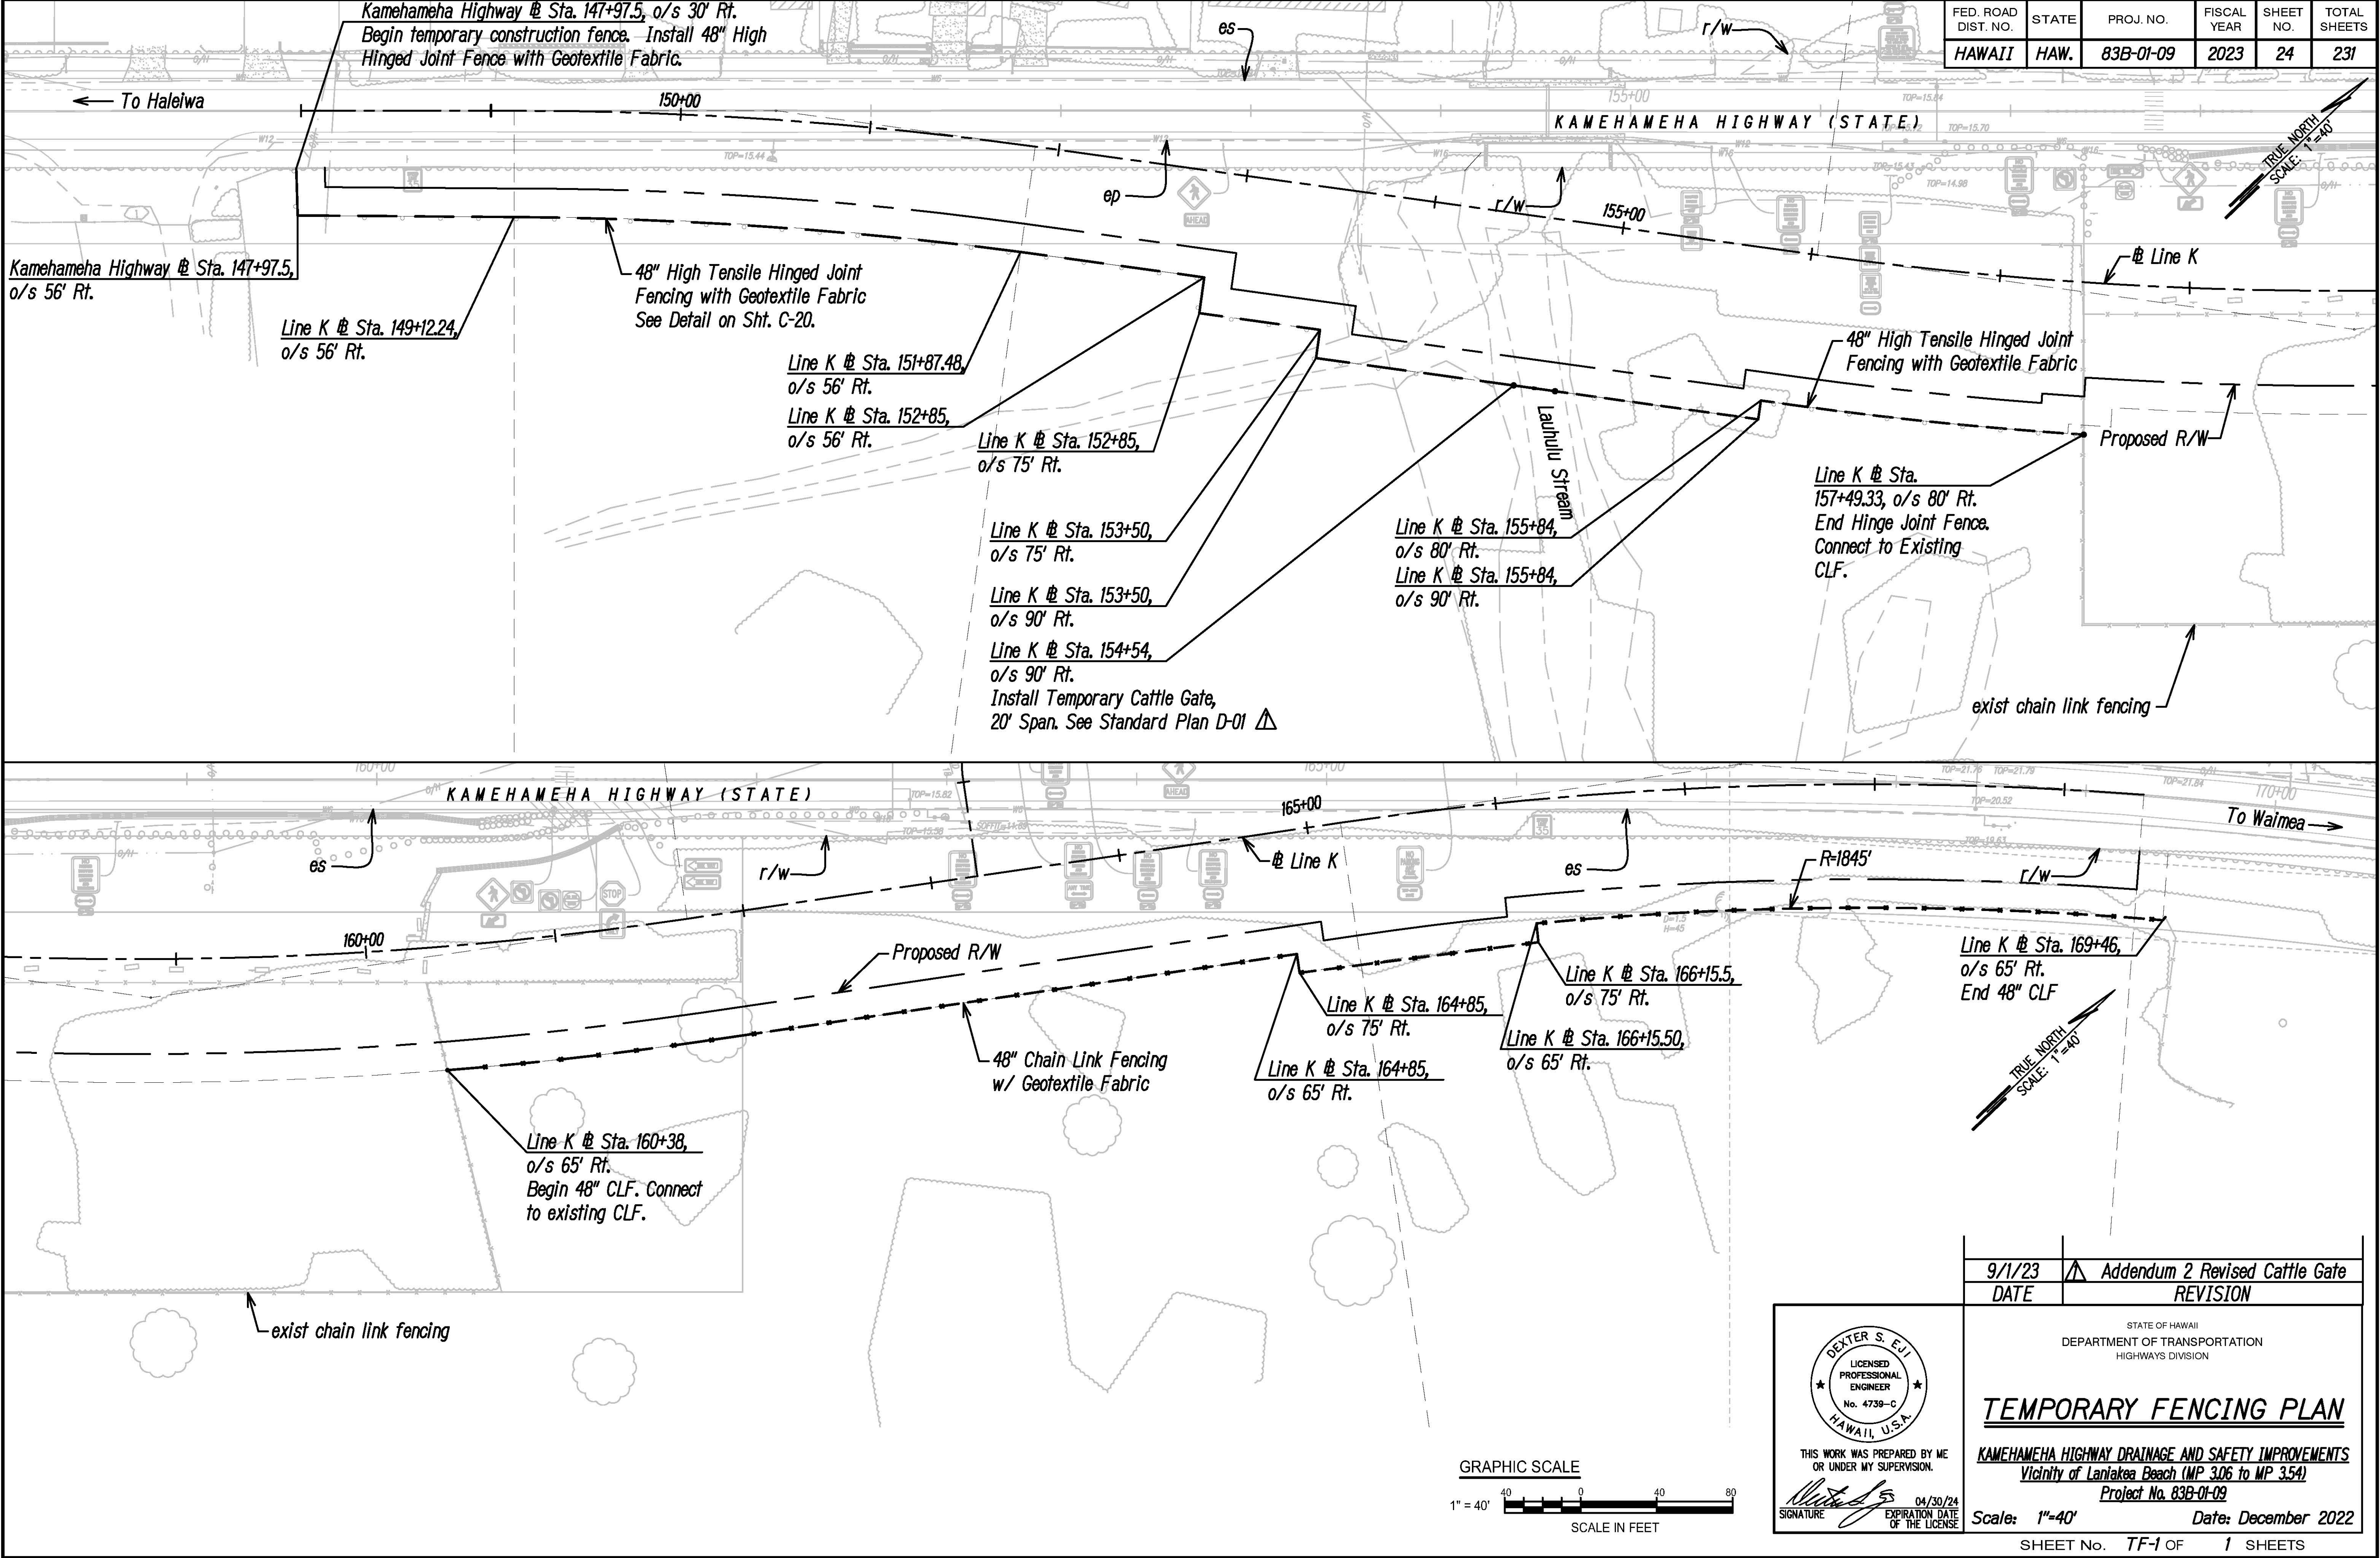

DESIGNED BY	DATE
DRAWN BY	*****
CHECKED BY	
NOTED BY	
QUANTITIES BY	
CHECKED BY	
ORIGINAL PLAN	
NO.	

THIS WORK WAS PREPARED BY ME OR UNDER MY SUPERVISION.

SIGNATURE: *[Signature]* 04/30/24

EXPIRATION DATE OF THE LICENSE

9/1/23	ADDENDUM 2 REVISED CATTLE GATE
DATE	REVISION
STATE OF HAWAII DEPARTMENT OF TRANSPORTATION HIGHWAYS DIVISION	
TEMPORARY FENCING PLAN	
KAMEHAMEHA HIGHWAY DRAINAGE AND SAFETY IMPROVEMENTS Vicinity of Lanikaea Beach (MP 3.06 to MP 3.54) Project No. 83B-01-09	
Scale: 1"=40'	Date: December 2022
SHEET No. TF-1 OF 1 SHEETS	