FED. ROAD DIST. NO.	STATE	PROJ. NO.	FISCAL YEAR	SHEET NO.	TOTAL SHEETS
HAWAII	HAW.	83B-01-81	1988	1	16

INDEX TO DRAWINGS

SHEET NO.	DESCRIPTION
1	TITLE SHEET
2	STANDARD PLANS SUMMARY
3	GENERAL NOTES & SCHEDULES
4	PLAN & TYPICAL SECTION
5 - 6	ROCKFALL PROTECTION DETAILS
7	DRAINAGE DETAILS
8	PAVEMENT MARKING & STRIPING
9 - 16	CROSS SECTIONS

STATE OF HAWAII

DEPARTMENT OF TRANSPORTATION
HIGHWAYS DIVISION

HONOLULU, HAWAII

PLANS FOR

KAMEHAMEHA HIGHWAY
REALIGNMENT AT WAIMEA BAY

PROJECT NO. 83B-01-81

DISTRICT OF KOOLAULOA
ISLAND OF OAHU

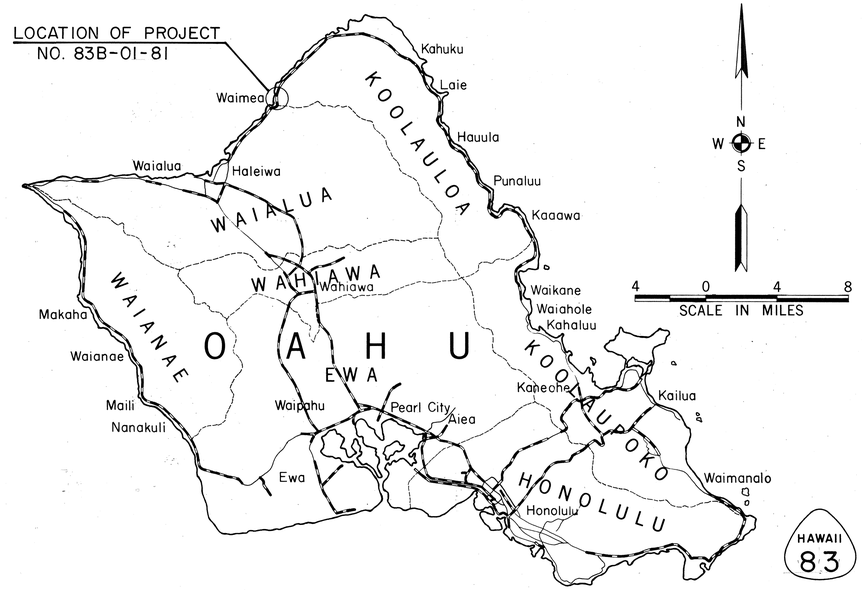

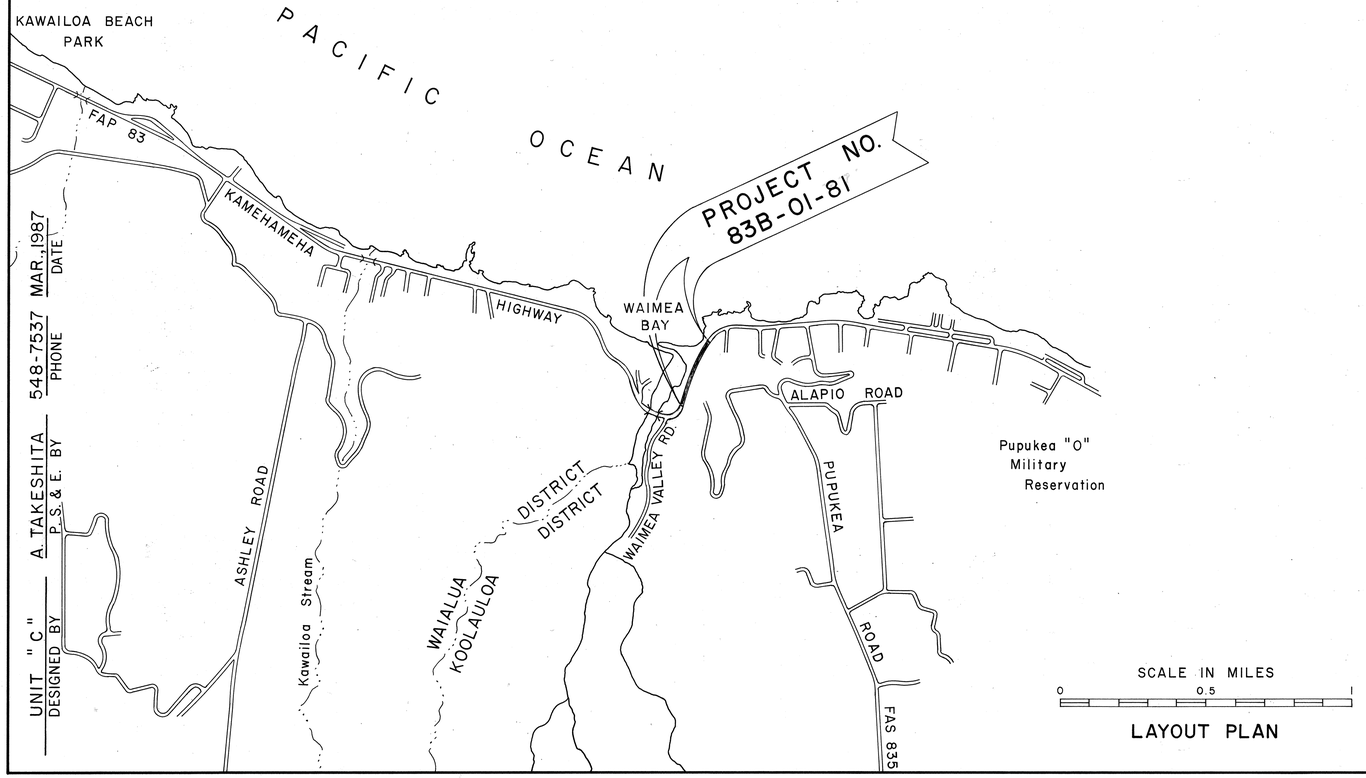

SCALE IN MILES
0 0.5 1

LAYOUT PLAN

DEPARTMENT OF TRANSPORTATION
STATE OF HAWAII

APPROVED:

DIR. OF TRANSPORTATION — DATE 5/22/87