FED. ROAD DIST. NO.	STATE	PROJ. NO.	FISCAL YEAR	SHEET NO.	TOTAL SHEETS
HAWAII	HAW.	83DEF-01-82M	1982	1	17

INDEX TO DRAWINGS

SHEET NO.	DESCRIPTION
1R	TITLE SHEET
2R	TYPICAL SECTIONS AND GENERAL NOTES
3R-8	ROADWAY PLANS
9R-14	PAVEMENT MARKINGS PLAN
15-17	STANDARD DETAILS

STATE OF HAWAII

DEPARTMENT OF TRANSPORTATION

HIGHWAYS DIVISION

HONOLULU, HAWAII

PLANS FOR

KAMEHAMEHA HIGHWAY RESURFACING

KAHANA BAY TO HAUULA HOMESTEAD ROAD

PROJECT NO. 83DEF-01-82M

DISTRICT OF KOOLAULOA

ISLAND OF OAHU

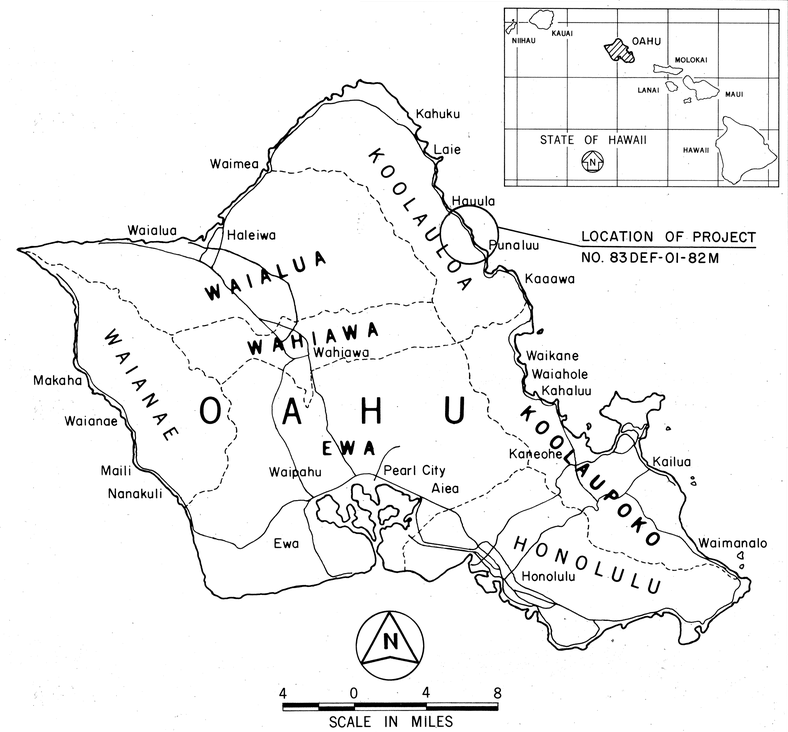

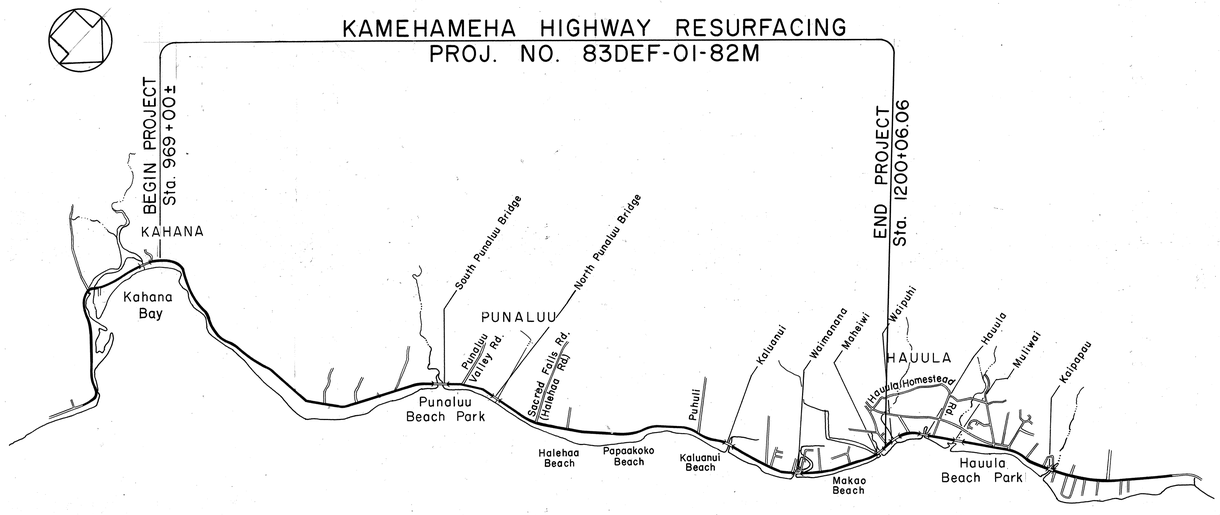

LAYOUT PLAN

0 0.5 1.0 2.0

SCALE IN MILES

Length of Project . . . . . 4.4 Miles

Unit "C"	R. Siarot	548-7537	Mar., 1982
DESIGNED BY	P. S. & E. BY	PHONE	DATE

DATE	REVISION
7/28/82	Increased Project Limits

DEPARTMENT OF TRANSPORTATION
STATE OF HAWAII

APPROVED:

James R. Carras 5/26/82

for DIR. OF TRANSPORTATION DATE

62162-2/82

D-8-2

1R