FED. ROAD DIST. NO.	STATE	PROJ. NO.	FISCAL YEAR	SHEET NO.	TOTAL SHEETS
HAWAII	HAW.	83C-01-86M	1986	1	40

83

INDEX TO DRAWINGS

SHEET NO.	DESCRIPTION
1	TITLE SHEET
2	GENERAL NOTES AND LEGEND
3	UTILITY GENERAL NOTES
4	TYPICAL SECTIONS
5	MISCELLANEOUS DETAILS
6 - 15	ROADWAY PLANS
✳ 16 - 22	GUARDRAIL & END TREATMENT
23	MISCELLANEOUS STRIPING DETAILS
24	PAVEMENT MARKING FRONTING POLYNESIAN CULTURAL CENTER
25-26	SCHEDULES AND TRAFFIC NOTES
27 - 40	STANDARD DETAILS

✳ C.O.ADD.16S-1, IS SUPPLEMENT TO CONTRACT PLANS.
NEW TOTAL=41

STATE OF HAWAII

DEPARTMENT OF TRANSPORTATION

HIGHWAYS DIVISION

HONOLULU, HAWAII

"AS-BUILT"

PLANS FOR

KAMEHAMEHA HIGHWAY RESURFACING

LAIEMALOO BRIDGE TO PUULUANA STREET

PROJECT NO. 83C-01-86M

DISTRICT OF KOOLAULOA
ISLAND OF OAHU

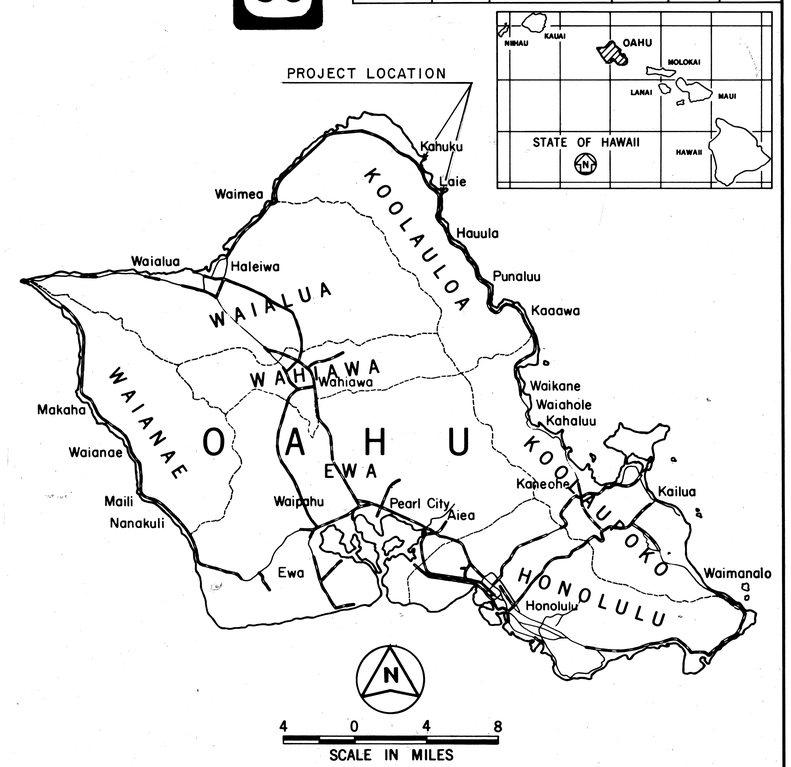

FEDERAL AID PROJECTS PREVIOUSLY CONSTRUCTED OR UNDER CONSTRUCTION

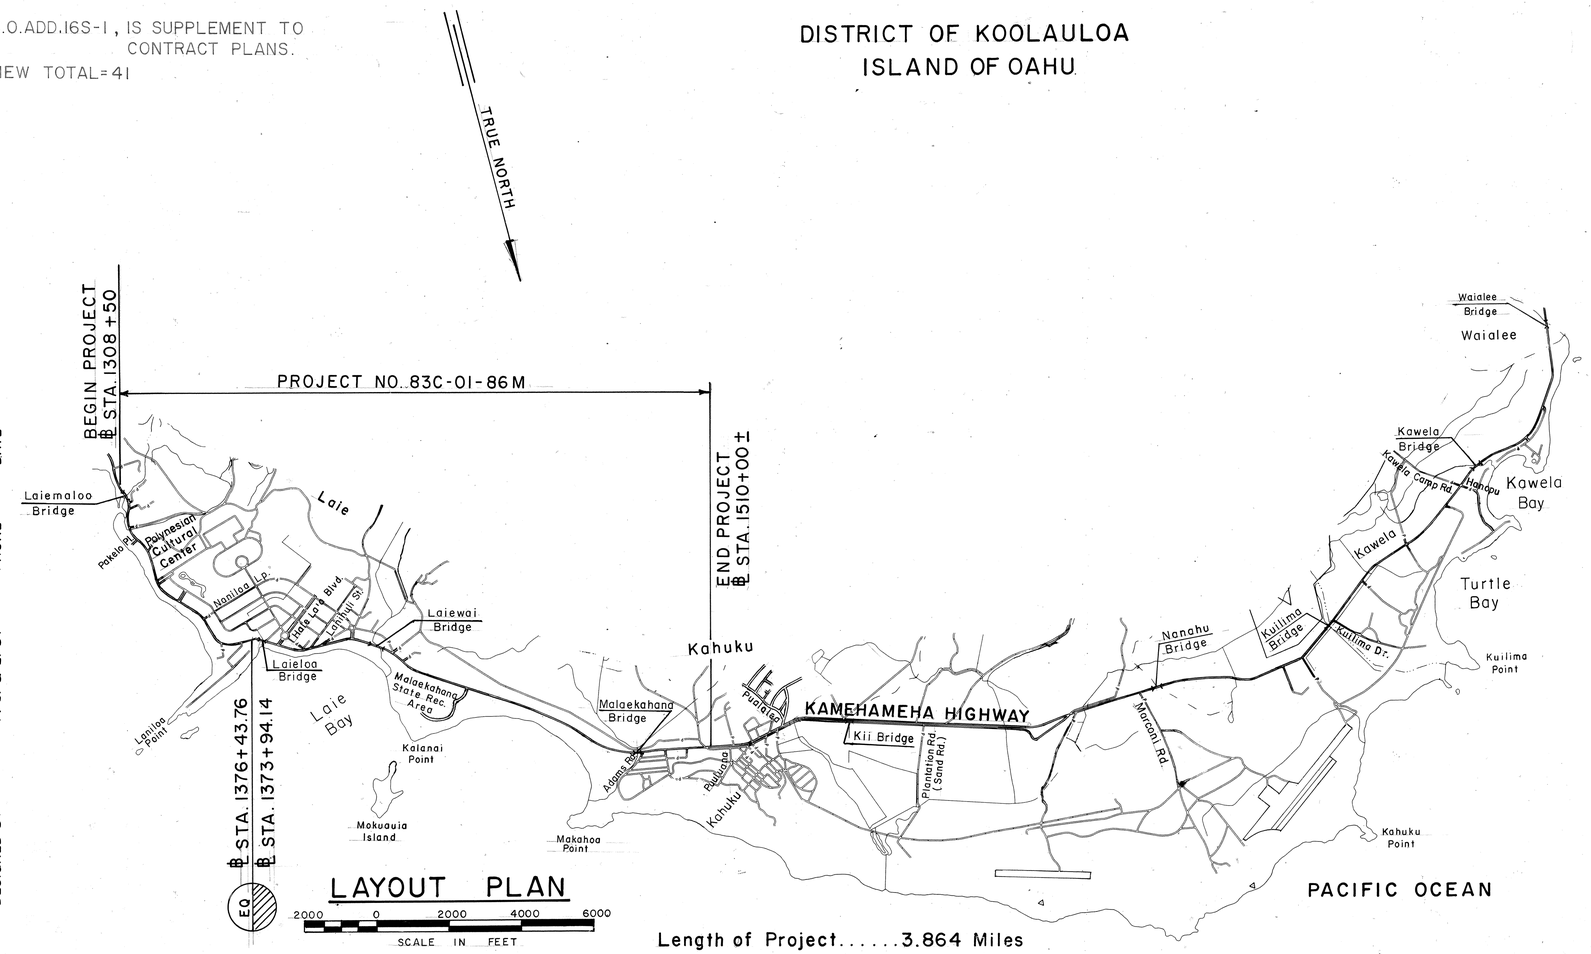

LAYOUT PLAN

Length of Project.....3.864 Miles

CHANGES MADE DURING CONSTRUCTION HAVE BEEN INCORPORATED ON THESE PLANS EXCEPT CHANGES IN THE ORIGINAL THEORETICAL QUANTITIES. FOR ACTUAL QUANTITIES, REFER TO PROJECT LEDGER AND/OR COMPUTATION BOOK.

RESIDENT ENGINEER — DATE 1/9/89

DESIGNED BY	PHONE	DATE
R. SIAROT	548-7537	OCT. 1985
R. SIAROT, P.S. & E. BY		

DEPARTMENT OF TRANSPORTATION
STATE OF HAWAII
APPROVED:
DIR. OF TRANSPORTATION — DATE 12/16/85