FED. ROAD DIST. NO.	STATE	PROJ. NO.	FISCAL YEAR	SHEET NO.	TOTAL SHEETS
HAWAII	HAW.	83D-01-86M	1986	1	57

83

INDEX TO DRAWINGS

SHEET NO.	DESCRIPTION
1	TITLE SHEET
2	GENERAL NOTES & LEGEND
3-4	TYPICAL SECTIONS & MISC. DETAILS
5	UTILITY GENERAL NOTES
6	PAVEMENT & ADJUSTMENT SCHEDULES
7-13	ROADWAY PLANS
* 14-24	DRAINAGE
25-30	GUARDRAIL CONNECTION & CULVERT REPAIR DETAILS
31-37	SIGNING & MARKING
38	TRAFFIC NOTES & SCHEDULES
39-57	STANDARD & TYPICAL DETAILS

* 17S-1, IS A SUPPLEMENTAL SHEET TO THE CONTRACT PLANS. NEW TOTAL=58 SHEETS.

STATE OF HAWAII

DEPARTMENT OF TRANSPORTATION

HIGHWAYS DIVISION

HONOLULU, HAWAII

"AS-BUILT"

PLANS FOR

KAMEHAMEHA HIGHWAY RESURFACING

KUALOA TO LAU PLACE

PROJECT NO. 83D-01-86M

DISTRICTS OF KOOLAUPOKO & KOOLAULOA

ISLAND OF OAHU

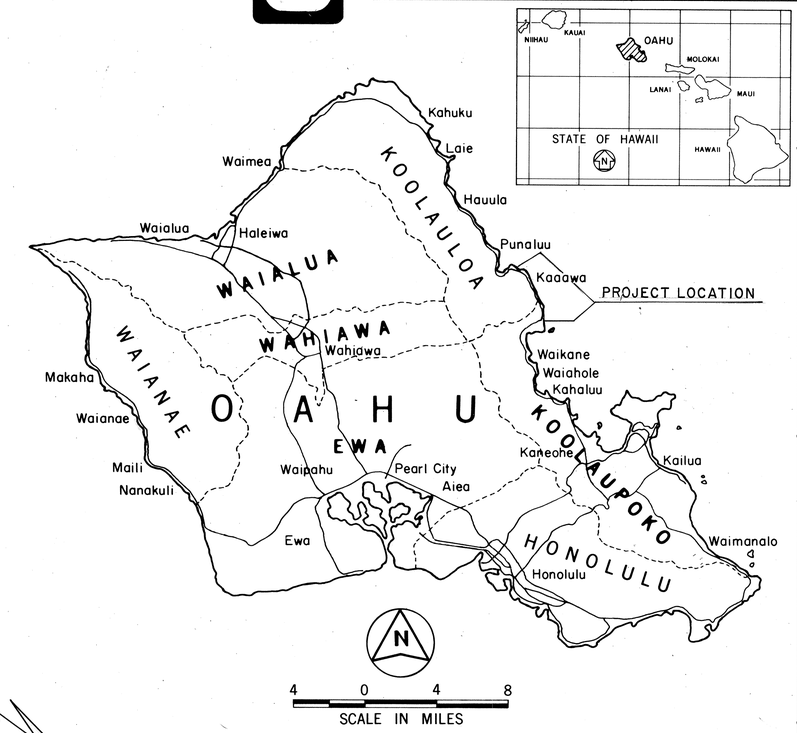

CULVERT REPAIR
SECTION 83E, 35.54 MILEPOINT
(included with Project No. 83D-01-86M)

PROJECT NO. 83D-01-86M
(see also Culvert Repair at left)

TRUE NORTH

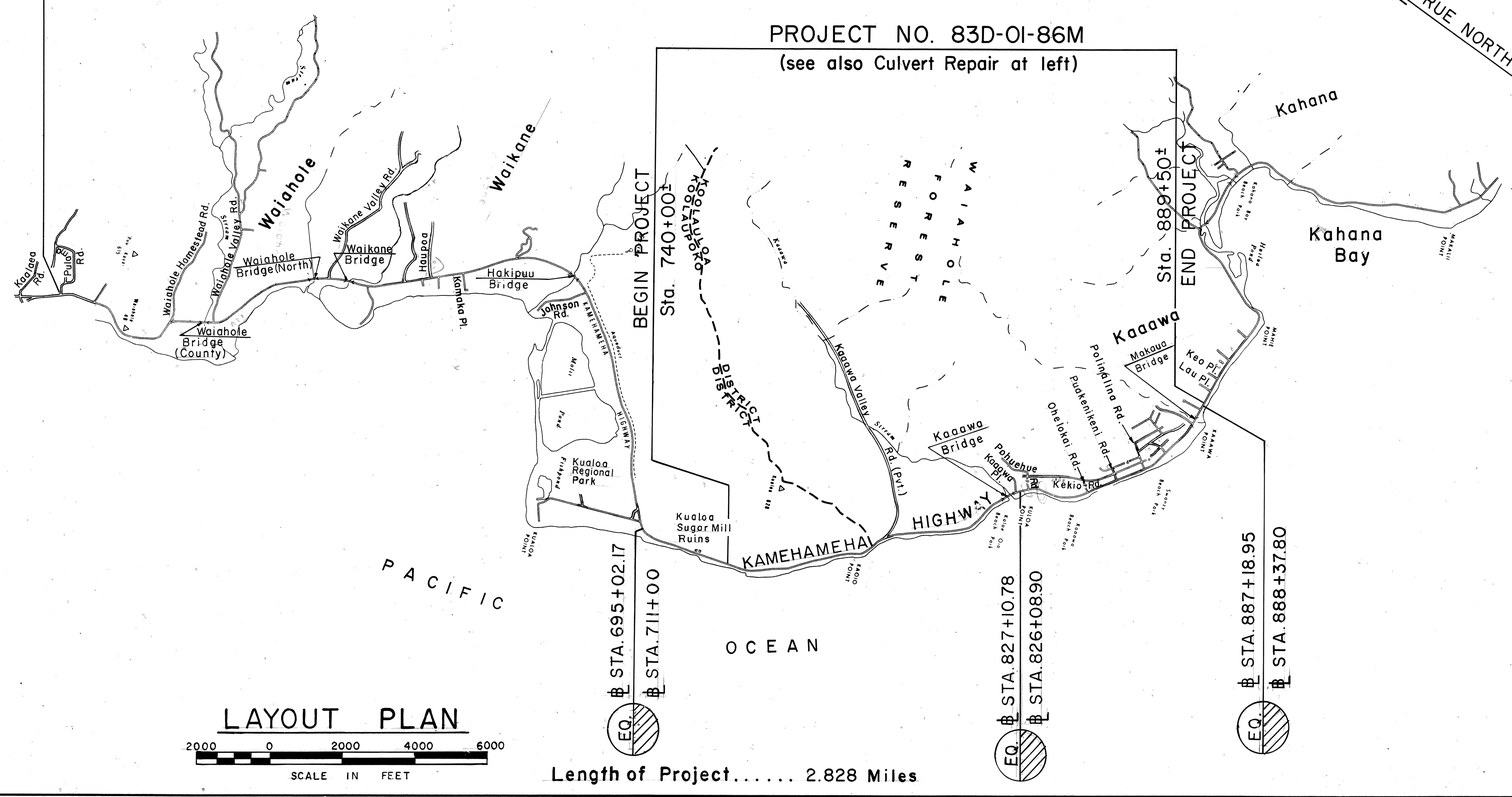

LAYOUT PLAN

2000 0 2000 4000 6000
SCALE IN FEET

Length of Project..... 2.828 Miles

UNIT "C" | J. PINIOL | 548-7537 | APRIL, 1986
DESIGNED BY | P. S. & E. BY | PHONE | DATE

CHANGES MADE DURING CONSTRUCTION HAVE BEEN INCORPORATED ON THESE PLANS EXCEPT CHANGES IN THE ORIGINAL THEORETICAL QUANTITIES. FOR ACTUAL QUANTITIES, REFER TO PROJECT LEDGER AND/OR COMPUTATION BOOK.

Dean T. Higa — 1/9/89
RESIDENT ENGINEER — DATE

DEPARTMENT OF TRANSPORTATION
STATE OF HAWAII

APPROVED:

for Chuck D. Poon — 5/29/86
DIR. OF TRANSPORTATION — DATE