FED.ROAD DIST.NO.	STATE	STATE PROJ.NO.	FISCAL YEAR	SHEET NO.	TOTAL SHEETS
HAWAII	HAW.	83A-01-90	1990	1	9

INDEX TO DRAWINGS

SHEET NO.	DESCRIPTION
1	TITLE SHEET
2	BASELINE DATA SHEET
3	GRADING NOTES/STANDARD PLANS SUMMARY
4	GRADING PLAN
5	DETAILS
6-7	CROSS SECTIONS
8-9	BORING LOGS

STATE OF HAWAII

DEPARTMENT OF TRANSPORTATION

HIGHWAYS DIVISION

HONOLULU, HAWAII

"AS-BUILT"

PLANS FOR

CONSTRUCTION OF

KAMEHAMEHA HIGHWAY REALIGNMENT HELEMANO/WAIALUA JUNCTION TO HALEIWA BEACH PARK (SOILS STABILIZATION) PROJECT NO. 83A-01-90

DISTRICT OF WAIALUA

ISLAND OF OAHU

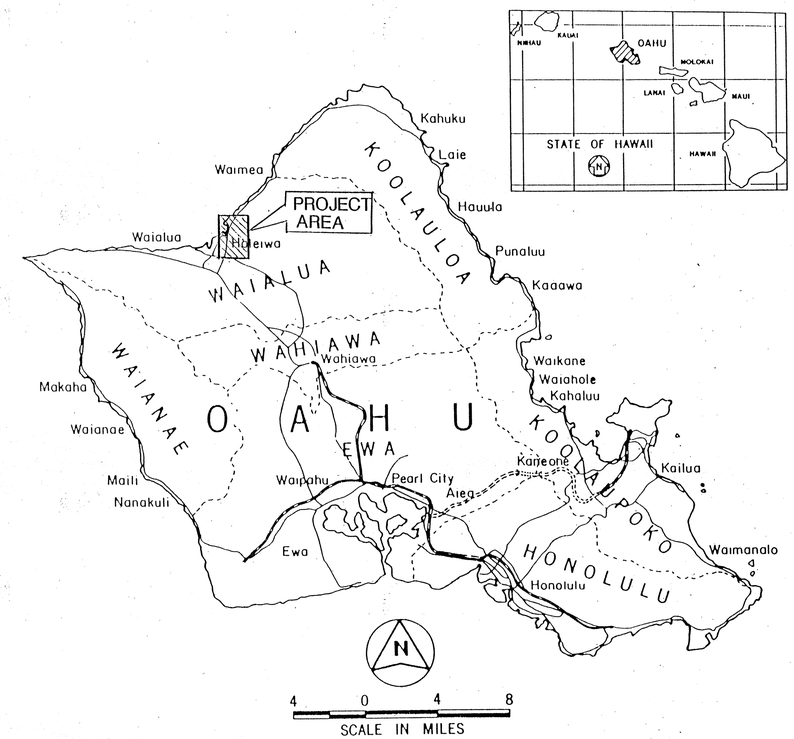

VICINITY MAP

TMK'S: 6-2-01 THRU 07, 12 AND 6-4-01

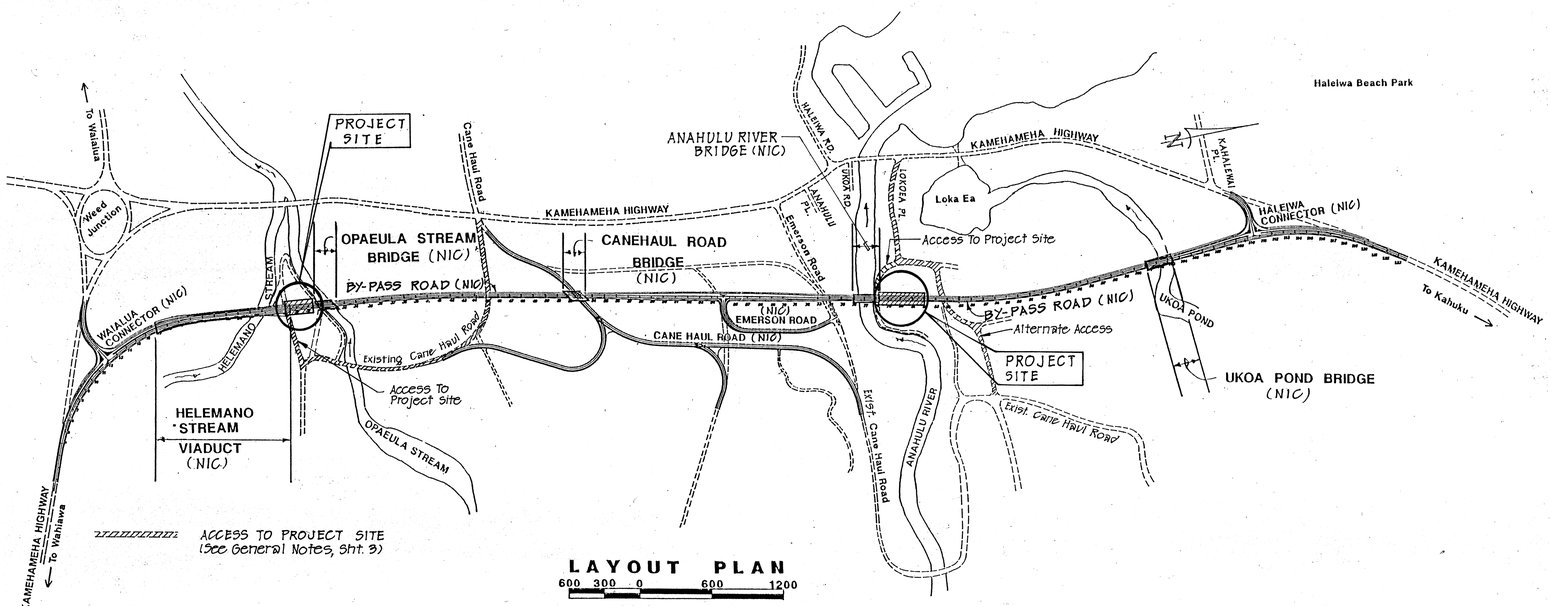

CHANGES MADE DURING CONSTRUCTION HAVE BEEN INCORPORATED ON THESE PLANS EXCEPT CHANGES IN THE ORIGINAL THEORETICAL QUANTITIES. FOR ACTUAL QUANTITIES, REFER TO PROJECT LEDGER AND/OR COMPUTATION BOOK.

Michael Amiga — RESIDENT ENGINEER

1/21/92 — DATE

DEPARTMENT OF TRANSPORTATION
STATE OF HAWAII

APPROVED:

Edward Sakai — DIR. OF TRANSPORTATION

1/21/90 — DATE

ENGINEERS
SURVEYORS HAWAII

DESIGNED BY:	P.S. & E BY	H. TAO	10/30/89
	PHONE	548-6932	
	DATE	NOVEMBER 1989	

DBA:HALEIWA BYPASS File:788-68

00-0-8-6