| FED. ROAD DIST. NO. | STATE | PROJ. NO. | FISCAL YEAR | SHEET NO. | TOTAL SHEETS |
|---|---|---|---|---|---|
| HAWAII | HAW. | HWY-0-02-89 | 1989 | 1 | 23 |

INDEX TO DRAWINGS


| SHEET NO. | DESCRIPTION |
|---|---|
| 1 | TITLE SHEET |
| 2-3 | LAYOUT & REFERENCE PLANS |
| 4 | STANDARD PLANS SUMMARY |
| 5 | GENERAL NOTES & DETAILS |
| 6-15 | PLANS |
| 16 | BRIDGE LOCATION PLAN, GENERAL NOTES & ESTIMATED QUANTITIES |
| ①17-19 | END POST CONNECTION DETAILS |
| 20-22 | CULVERT EXTENSION DETAILS |
| 23 | GUARDRAIL TYPE 3 THRIE BEAM DET. |


Plan Sht. Nos. ① C.O. 19S-2 and C.O. 19S-3 are Supplementary Sheets to this Project.
TOTAL SHEET COUNT after "AS-BUILT" postings 25 Sheets.

STATE OF HAWAII

DEPARTMENT OF TRANSPORTATION
HIGHWAYS DIVISION
HONOLULU, HAWAII

"AS-BUILT"

PLANS FOR

# GUARDRAIL AND SHOULDER IMPROVEMENTS AT VARIOUS LOCATIONS ON OAHU

ROUTE NOS. 83 & 930

## PROJECT NO. HWY-0-02-89

DISTRICTS OF WAIALUA & KOOLAULOA
ISLAND OF OAHU

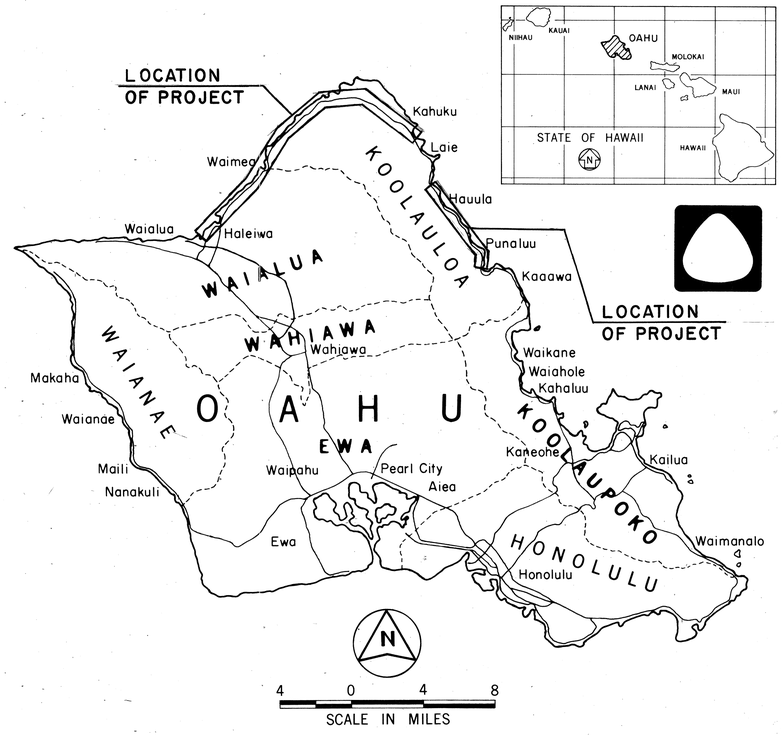


MILE POST _____ TO MILE POST _____

ALL CHANGES MADE DURING CONSTRUCTION HAVE BEEN NOTED IN RED ON THESE TRACINGS AND CHECKED BY

Michael Dinuga 11/13/96
RESIDENT ENGINEER DATE

DEPARTMENT OF TRANSPORTATION
STATE OF HAWAII
APPROVED:
Edward J. Inaw 4/9/90
DIR. OF TRANSPORTATION DATE

ALLAN T. NISHIMURA 548-7490 JAN. 1990
DESIGNED BY P. S. & E. BY PHONE DATE

B-8-9