FED. ROAD DIST. NO.	STATE	FED. AID PROJ. NO.	FISCAL YEAR	SHEET NO.	TOTAL SHEETS
HAWAII	HAW.	F-083-1(24)	1990	21	125

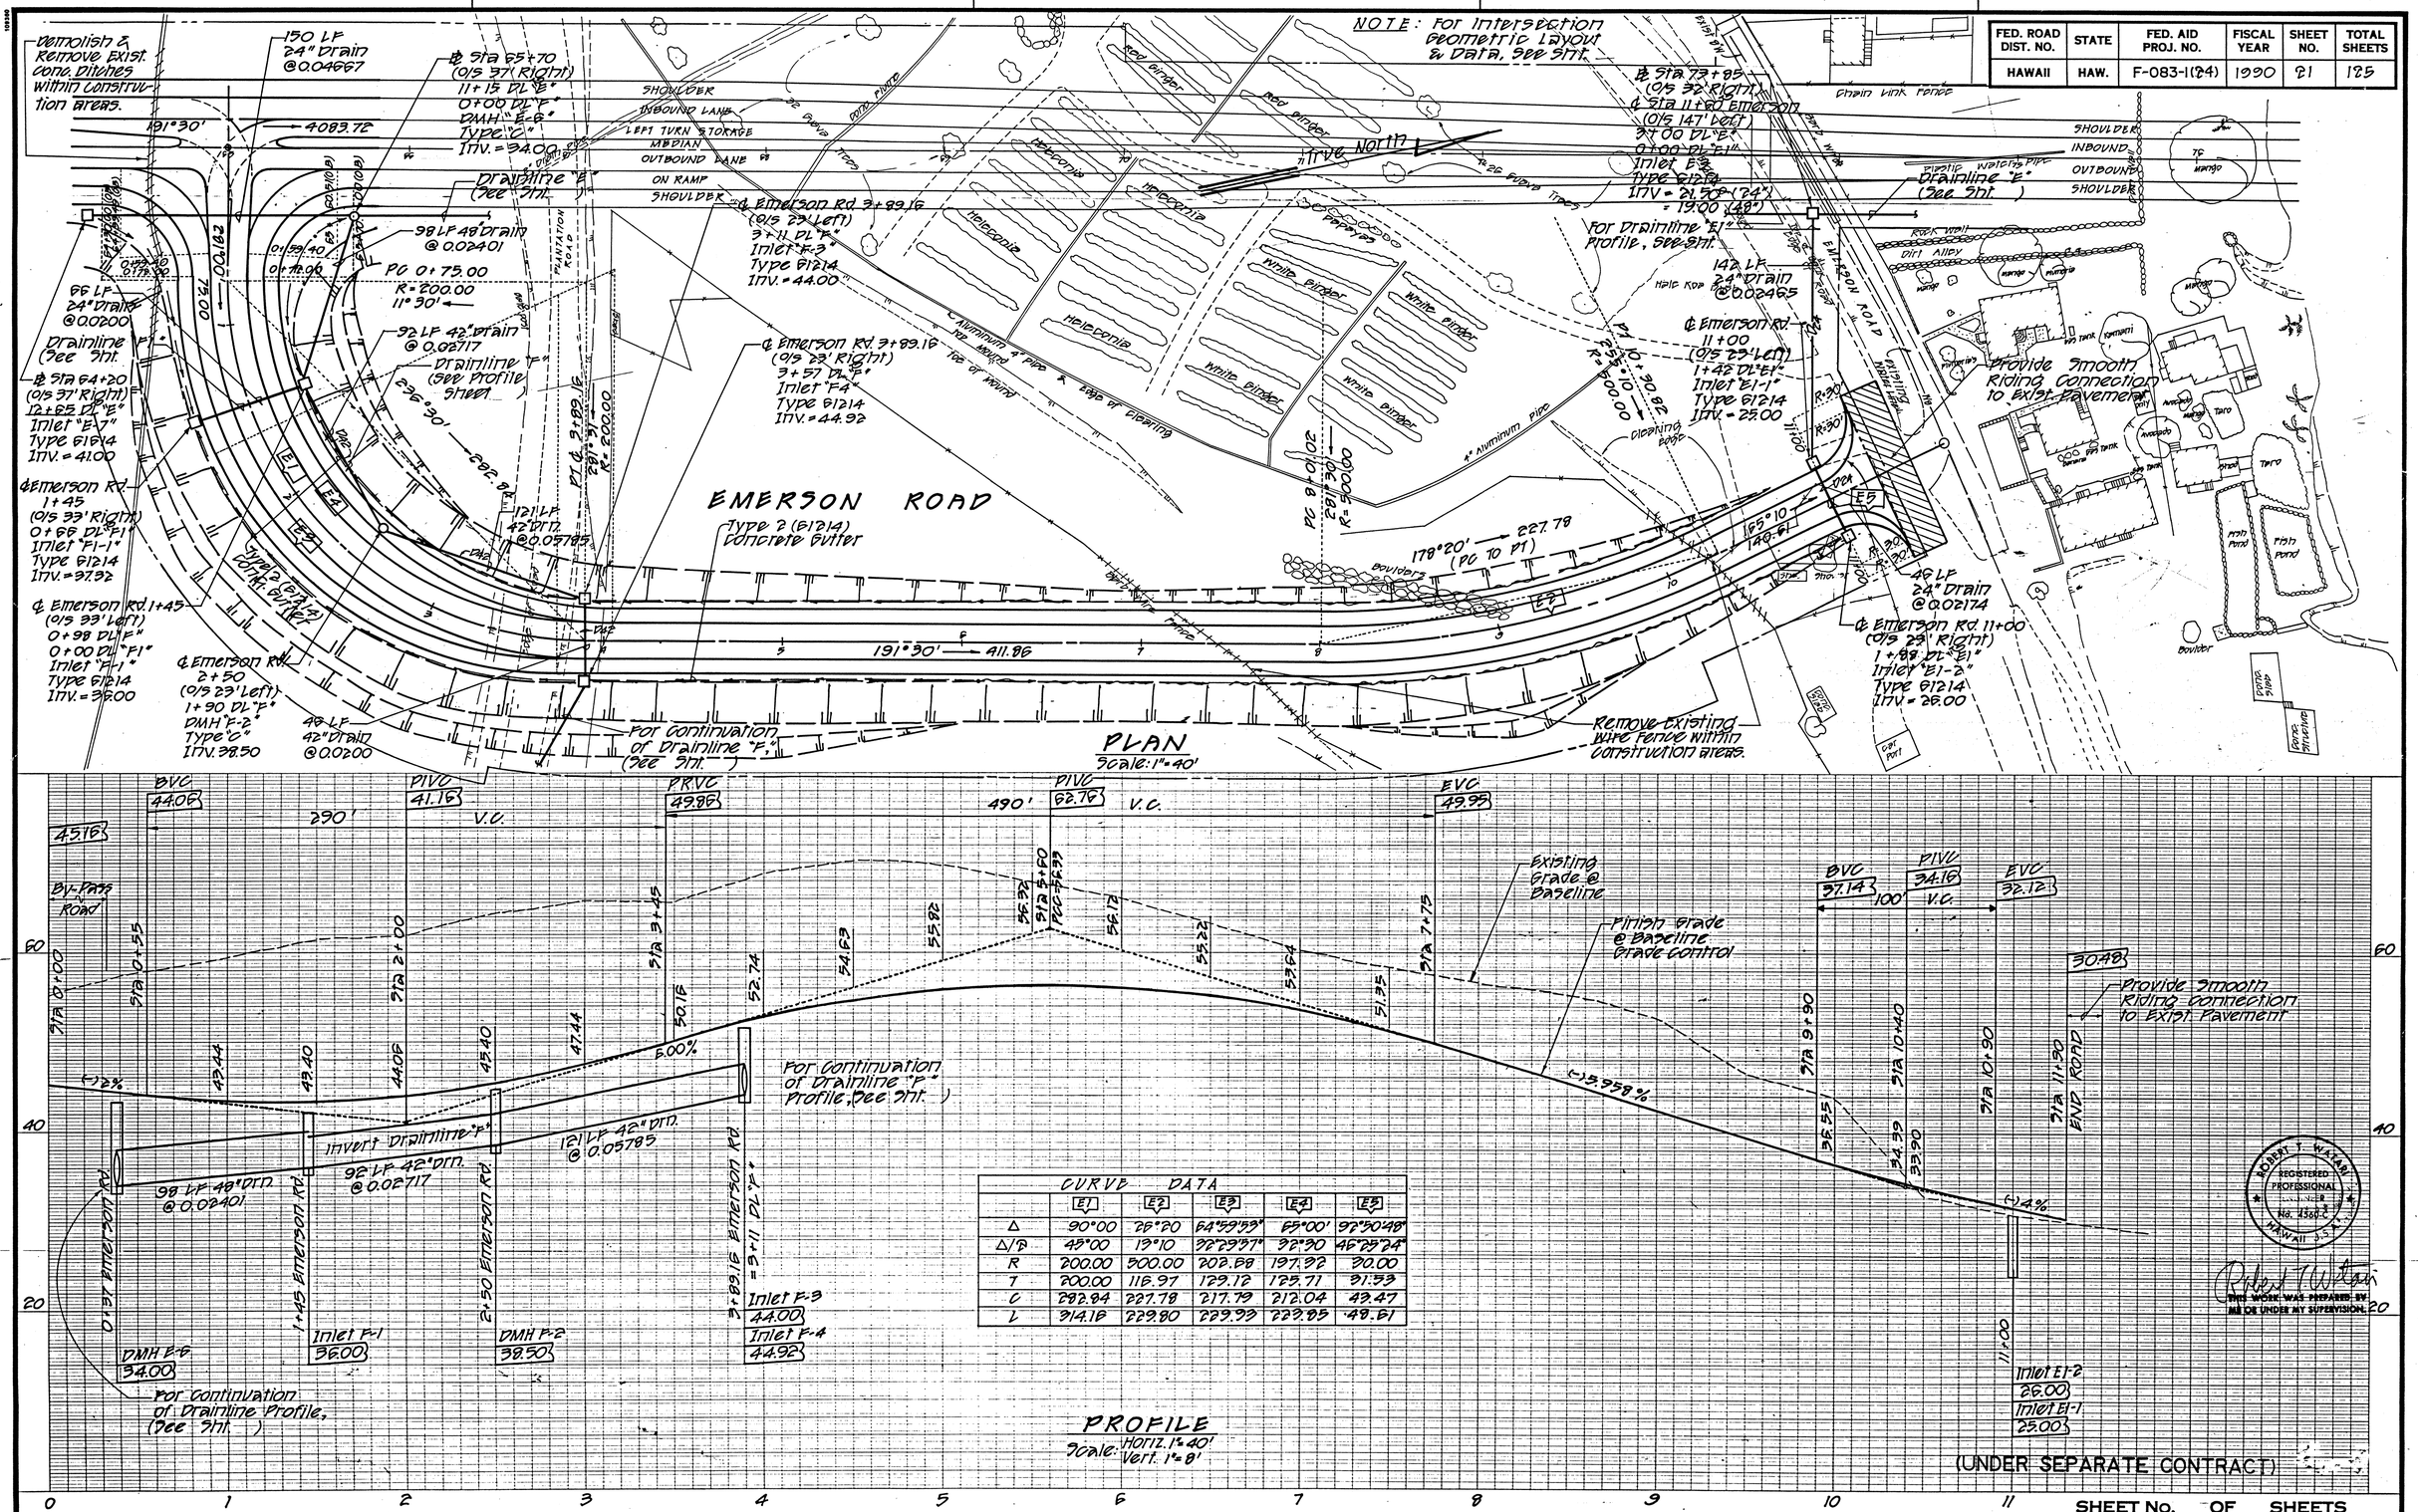

CURVE DATA					
	E1	E2	E3	E4	E5
Δ	90°00	26°20	64°59'59"	65°00'	97°30'48"
Δ/2	45°00	13°10	32°29'57"	32°30	48°29'24"
R	200.00	500.00	202.88	197.32	30.00
T	200.00	116.97	129.12	125.71	31.33
C	282.84	227.78	217.79	212.04	43.47
L	314.16	229.80	229.93	223.85	49.61

ORIGINAL PLAN	
SURVEY PLOTTED BY	
DRAWN BY	
TRACED BY	
DESIGNED BY	
QUANTITIES BY	
CHECKED BY	
DATE	
NOTE BOOK	
No.	

SHEET No. OF SHEETS

21