INDEX TO DRAWINGS	
SHEET NO.	DESCRIPTION
1	TITLE SHEET
2	STANDARD PLANS SUMMARY
3 – 6	WALKWAY DETAILS

FED. ROAD DIST. NO.	STATE	PROJ. NO.	FISCAL YEAR	SHEET NO.	TOTAL SHEETS
HAWAII	HAW.	83E-01-91	1992	1	6

STATE OF HAWAII

DEPARTMENT OF TRANSPORTATION

HIGHWAYS DIVISION

HONOLULU, HAWAII

"AS BUILT"

PLANS FOR

KAMEHAMEHA HIGHWAY

KAALAEA STREAM WALKWAY

PROJECT NO. 83E-01-91

DISTRICT OF KOOLAUPOKO

ISLAND OF OAHU

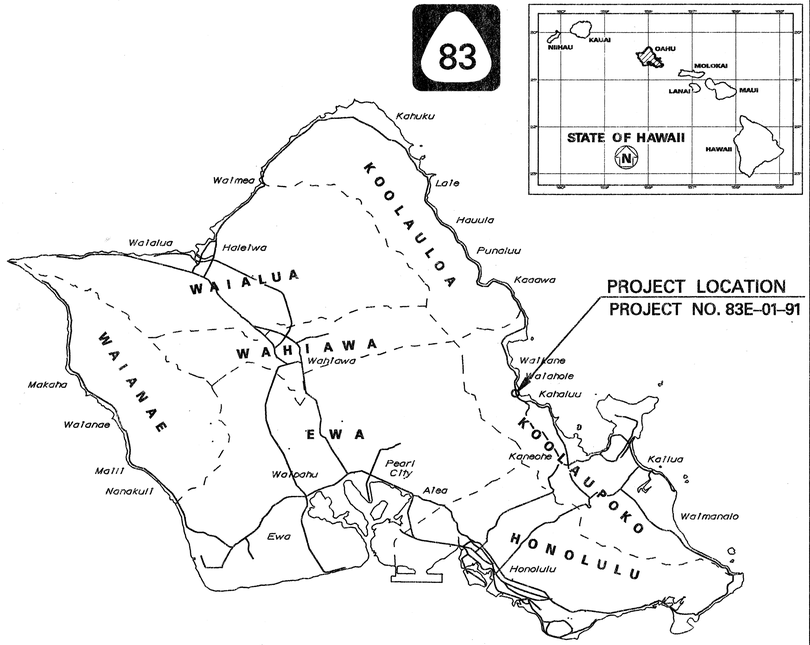

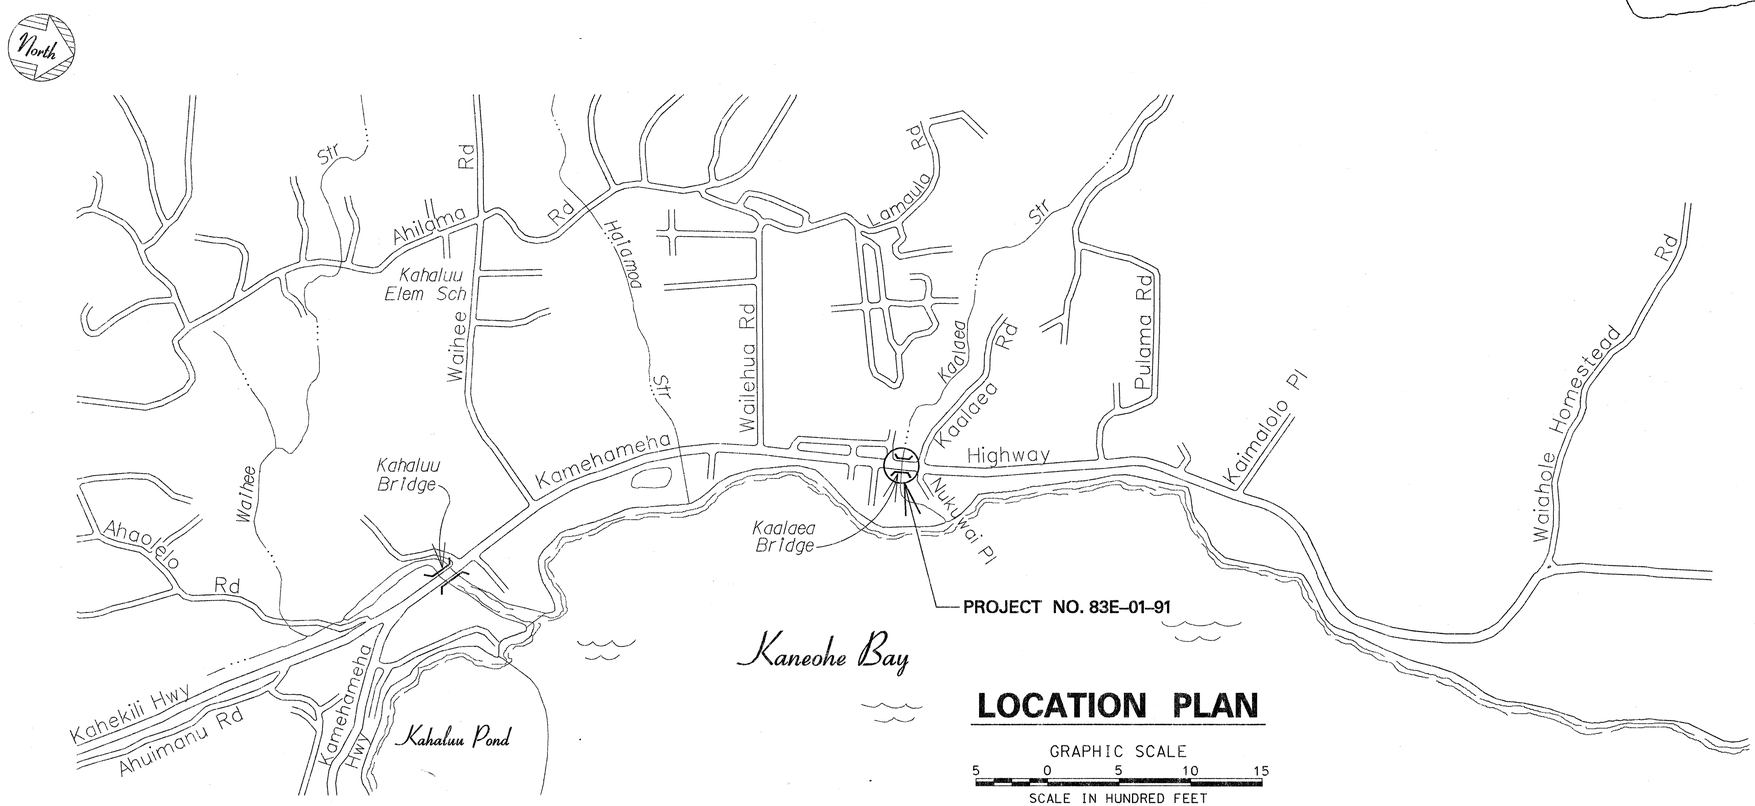

LOCATION PLAN

GRAPHIC SCALE

5 0 5 10 15

SCALE IN HUNDRED FEET

N

4 0 4 8

SCALE IN MILES

MILE POST 35.75 TO MILE POST –

CHANGES MADE DURING CONSTRUCTION HAVE BEEN INCORPORATED ON THESE PLANS EXCEPT CHANGES IN THE ORIGINAL THEORETICAL QUANTITIES. FOR ACTUAL QUANTITIES, REFER TO PROJECT LEDGER AND/OR COMPUTATION BOOK.

for RESIDENT ENGINEER — 11/20/01 DATE

DEPARTMENT OF TRANSPORTATION STATE OF HAWAII	
APPROVED:	
for DIR. OF TRANSPORTATION	12/12/91 DATE

HWY-DB	J. KASAMOTO	587-2250	NOV., 1991
DESIGNED BY	P. S. & E. BY	PHONE	DATE

DD-D-85

12/9/91 4kamdtsht.dgn