FED. ROAD DIST. NO.	STATE	FED. AID PROJ. NO.	FISCAL YEAR	SHEET NO.	TOTAL SHEETS
HAWAII	HAW.	STP-083-1(28)	1994	1	21

INDEX TO DRAWINGS

SHEET NO.	DESCRIPTION
1	TITLE SHEET
2	STANDARD PLANS SUMMARY
3	GENERAL NOTES & LEGEND
4	TYPICAL SECTIONS & DRAINAGE NOTES
5	MISC. DETAILS
6	UTILITY & MONUMENT ADJUSTMENT SCHEDULES
7-11	ROADWAY PLANS
12	DRAINAGE DETAILS
13-14	SAFETY IMP. AT CULVERTS
15-21	PAVEMENT MARKING & SIGNING PLANS, DETAILS & SCHEDULES

STATE OF HAWAII

DEPARTMENT OF TRANSPORTATION

HIGHWAYS DIVISION

HONOLULU, HAWAII

"AS-BUILT"

PLANS FOR

KAMEHAMEHA HIGHWAY RESURFACING

KAHALUU STREAM TO WAIAHOLE VALLEY ROAD

FEDERAL AID PROJ. NO. STP-083-1(28)

DISTRICT OF KOOLAUPOKO

ISLAND OF OAHU

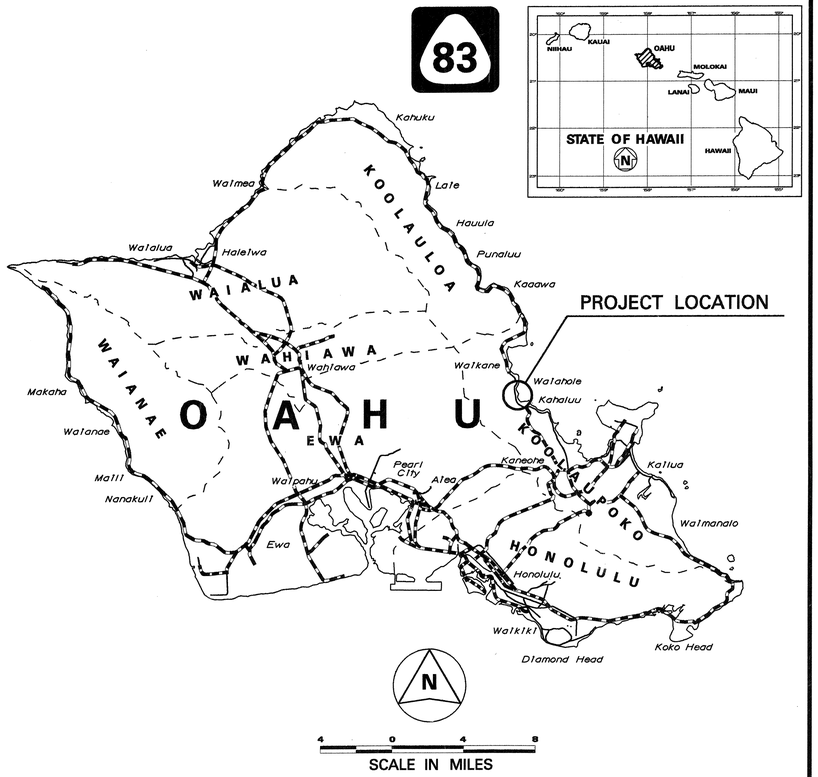

FEDERAL AID PROJECTS PREVIOUSLY CONSTRUCTED OR UNDER CONSTRUCTION

MILE POST 36.46 TO MILE POST 34.55

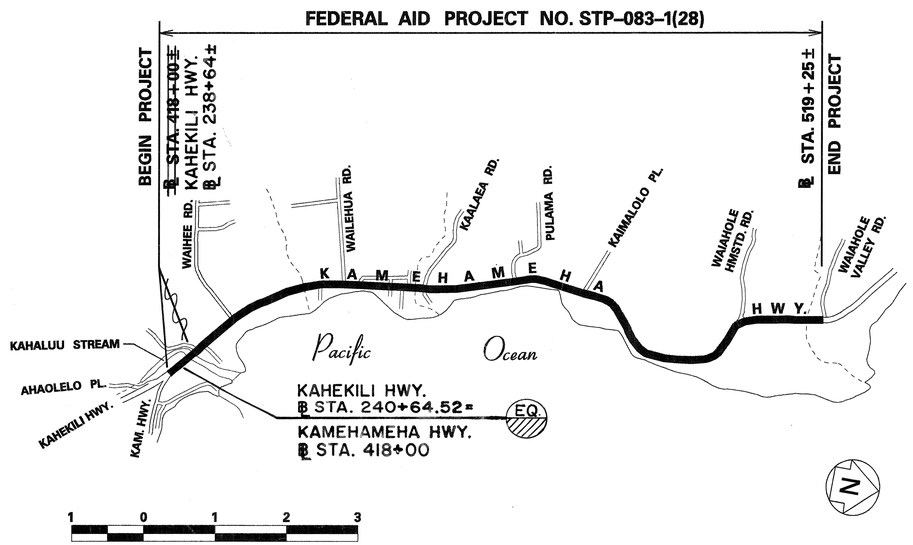

LAYOUT PLAN

Scale: 1" = 1000'

Length of Project ..... 1.91 Mi.

DESIGN DESIGNATION

ADT (1994) 17,115
ADT (2004) 21,569
V ..... 40 M.P.H.

CHANGES MADE DURING CONSTRUCTION HAVE BEEN NOTED ON THESE PLANS AND CHECKED BY:

Gerald Pang — RESIDENT ENGINEER — 8/18/97 DATE

DEPARTMENT OF TRANSPORTATION
STATE OF HAWAII

APPROVED:

A. Harano — 5/17/94
for DIR. OF TRANSPORTATION — DATE

UNIT "D" — DESIGNED BY — ALLAN NISHIMURA — P. S. & E. BY — 587-2244 — PHONE — MAY, 1994 — DATE