



FED. ROAD DIST. NO.	STATE	PROJ. NO.	FISCAL YEAR	SHEET NO.	TOTAL SHEETS
HAWAII	HAW.	83A-01-92	1992	26	168

NOTE: FOR INTERSECTION GEOMETRIC LAYOUT & DATA, SEE SHEET 12

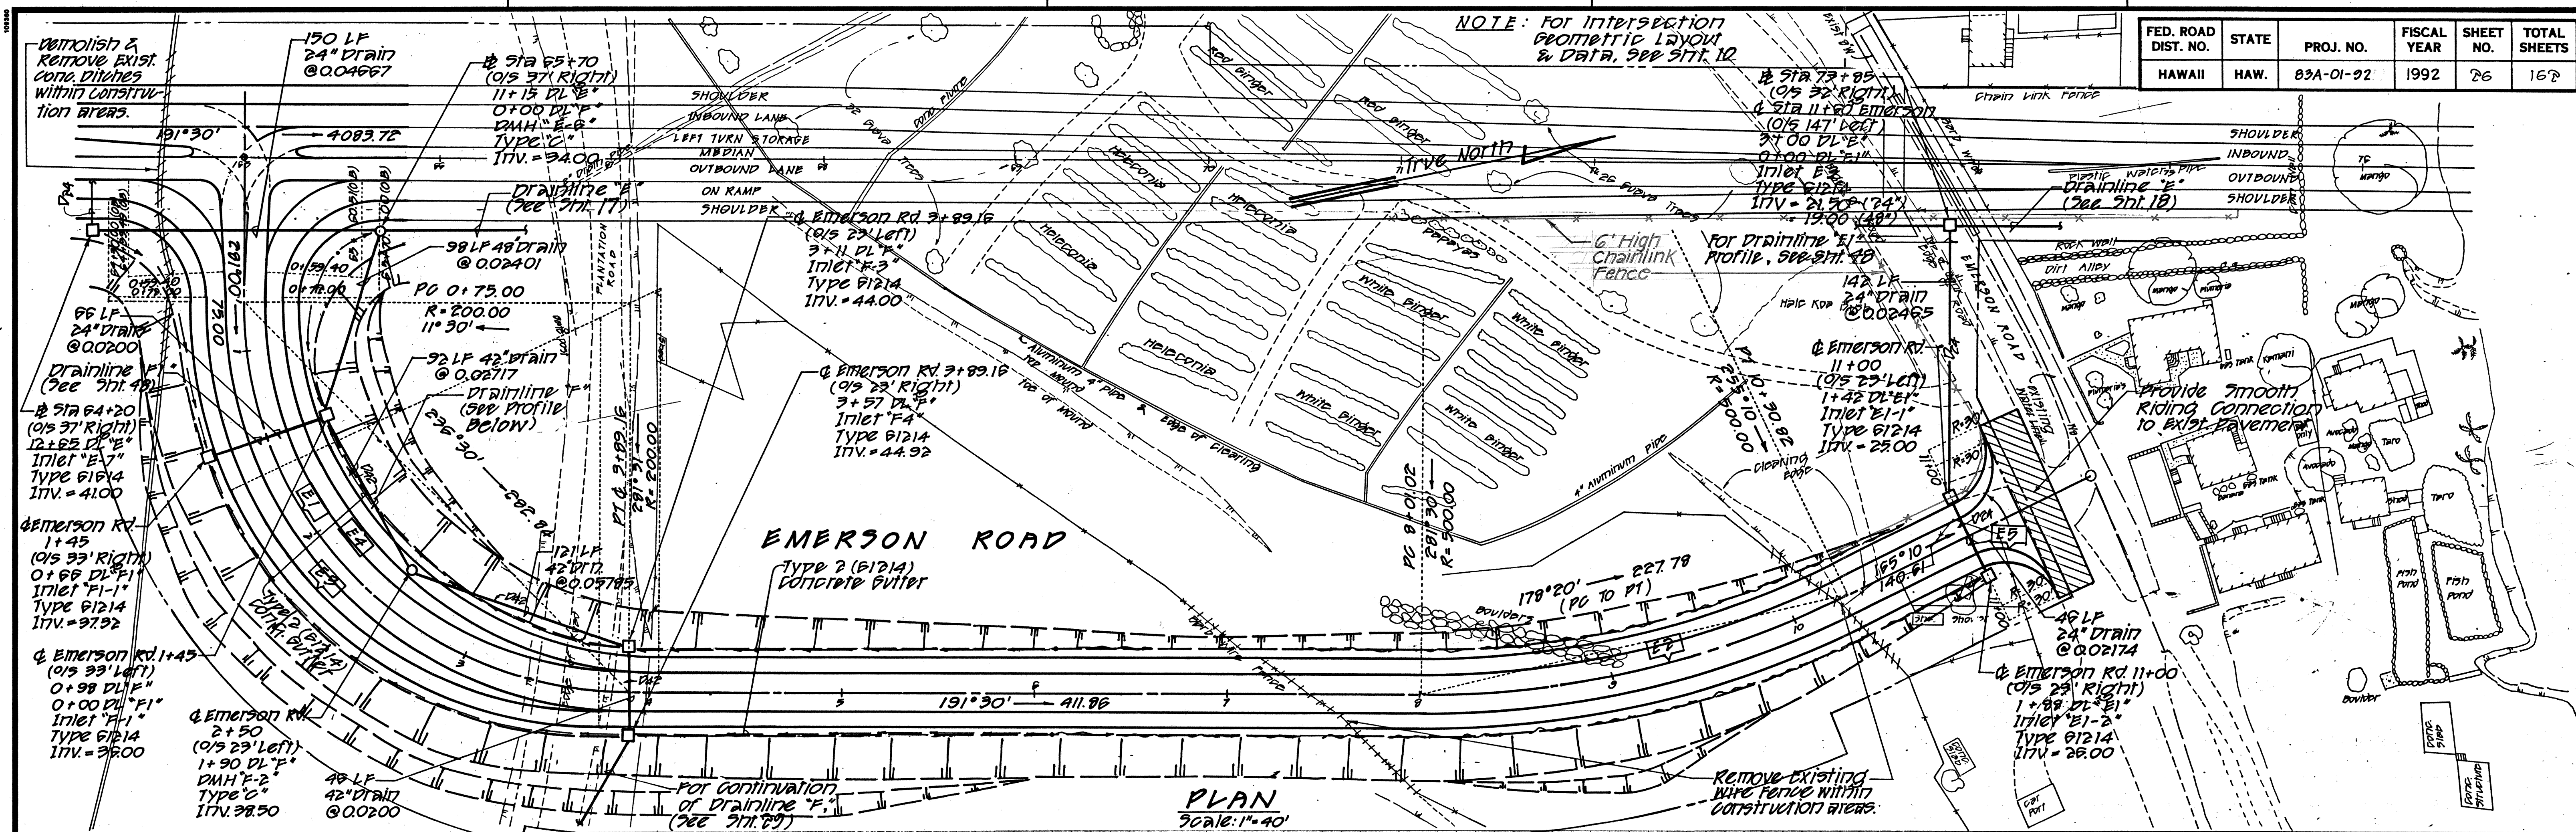

PLAN
Scale: 1" = 40'

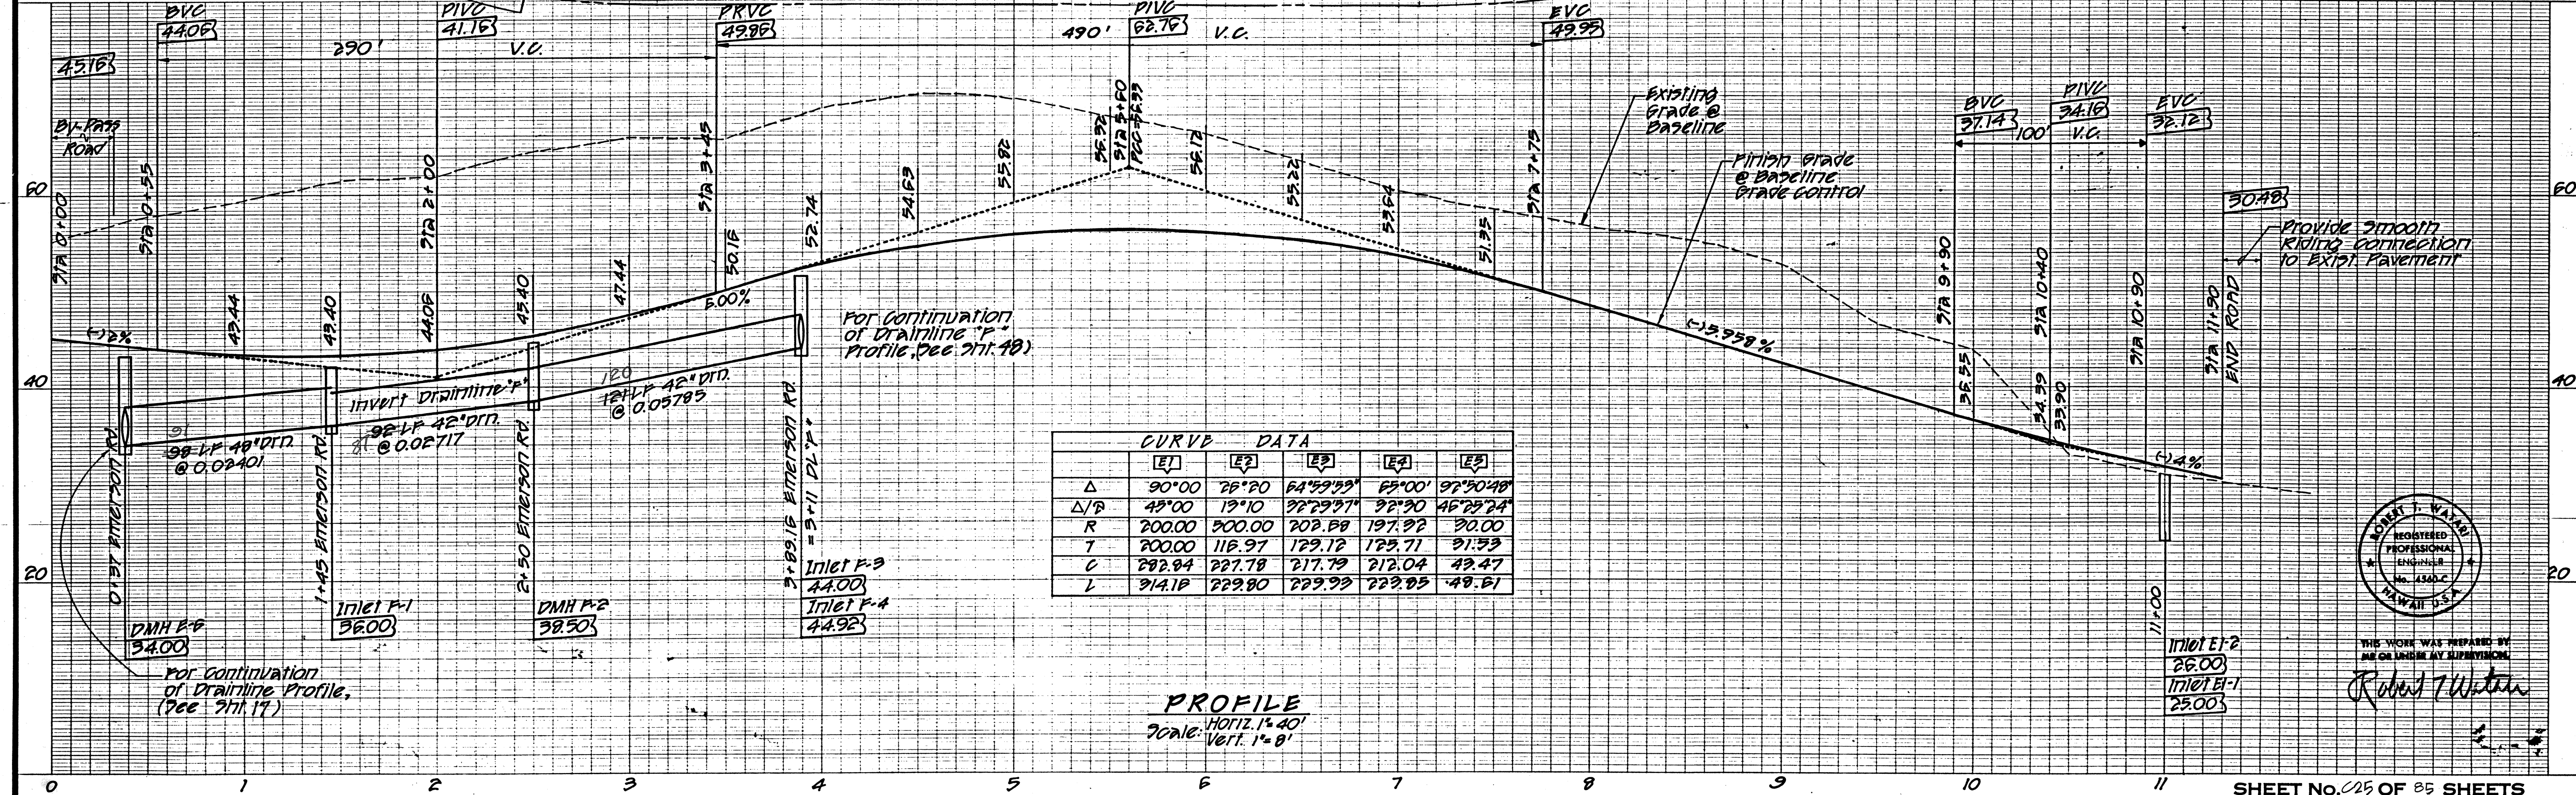

CURVE DATA					
	[E1]	[E2]	[E3]	[E4]	[E5]
R	200.00	500.00	202.88	197.92	30.00
T	200.00	116.97	129.12	125.71	31.53
C	282.84	227.78	217.79	212.04	42.47

PROFILE
Scale: Horiz. 1" = 40'
Vert. 1" = 8'

DATE _____

SURVEY PLOTTED BY _____

DESIGNED BY _____

QUANTITIES BY _____

CHECKED BY _____

NO. _____



THIS WORK WAS PREPARED BY ME OR UNDER MY SUPERVISION
Robert J. Winters