



ORIGINAL PLAN	SURVEY PLOTTED BY	DATE
NOTE BOOK	DESIGNED BY	11/19/97
QUANTITIES BY	CHECKED BY	

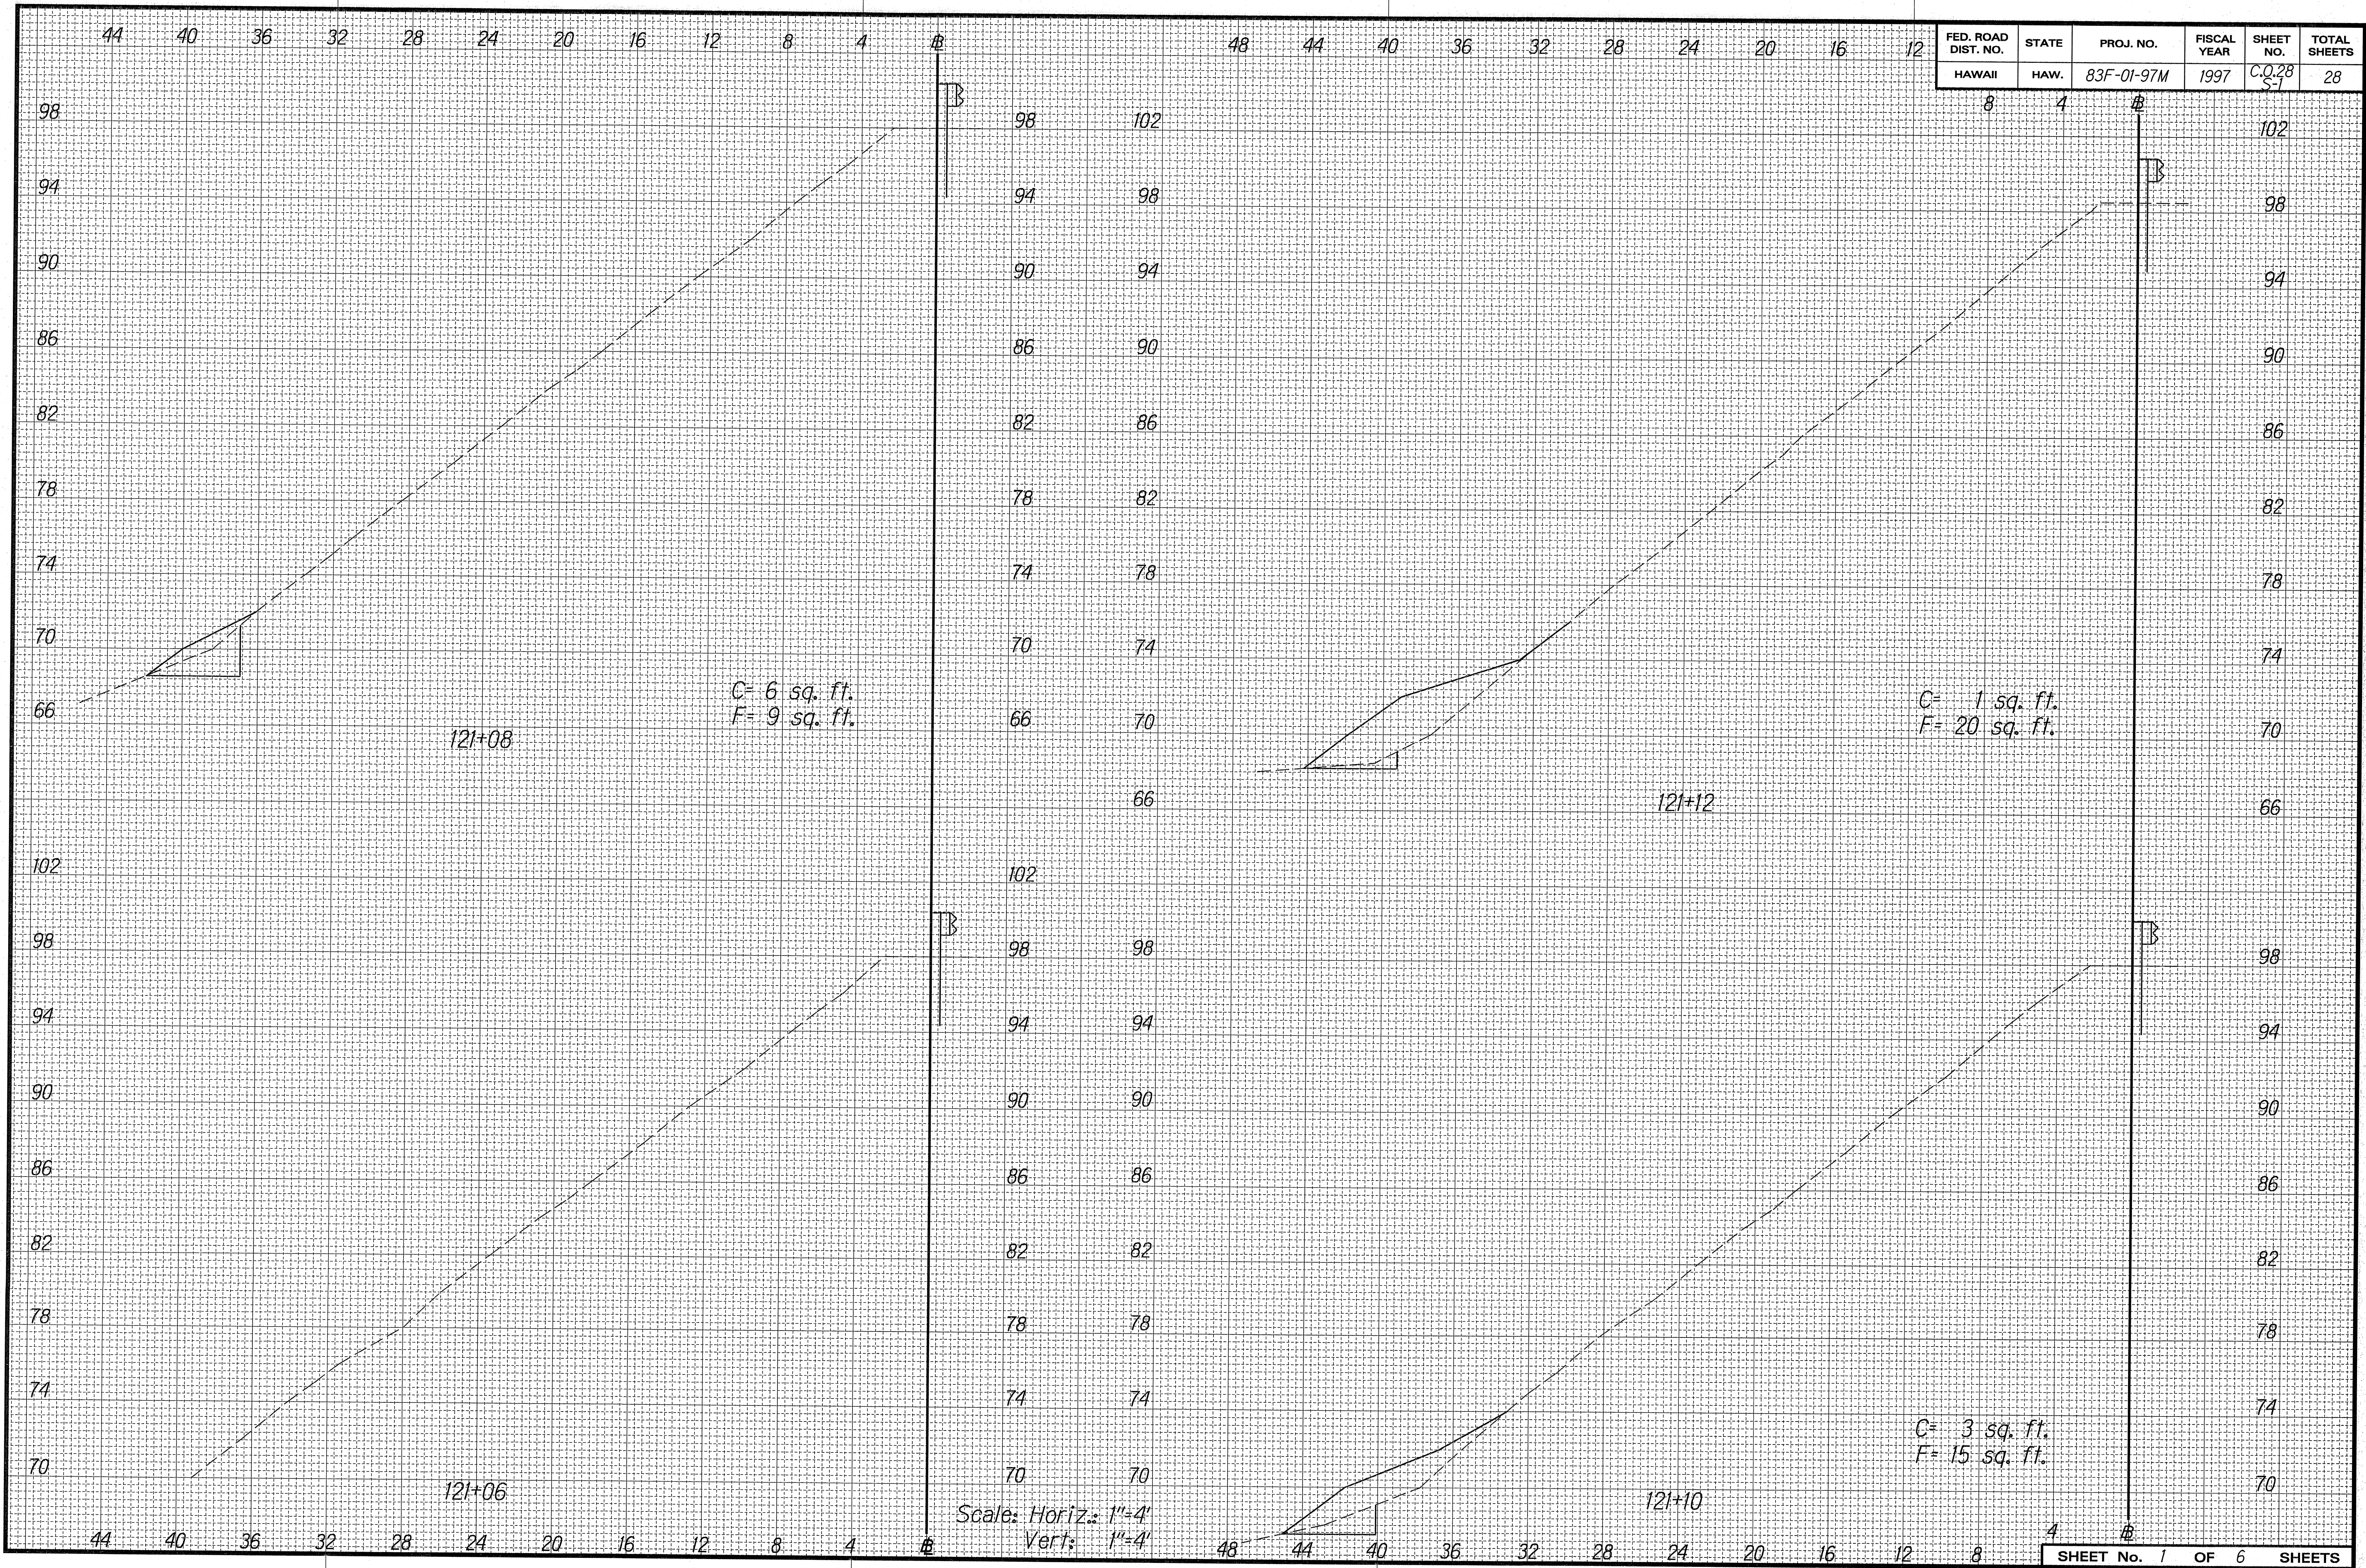


FED. ROAD DIST. NO.	STATE	PROJ. NO.	FISCAL YEAR	SHEET NO.	TOTAL SHEETS
HAWAII	HAW.	83F-01-97M	1997	C.O. 28 S-2	28


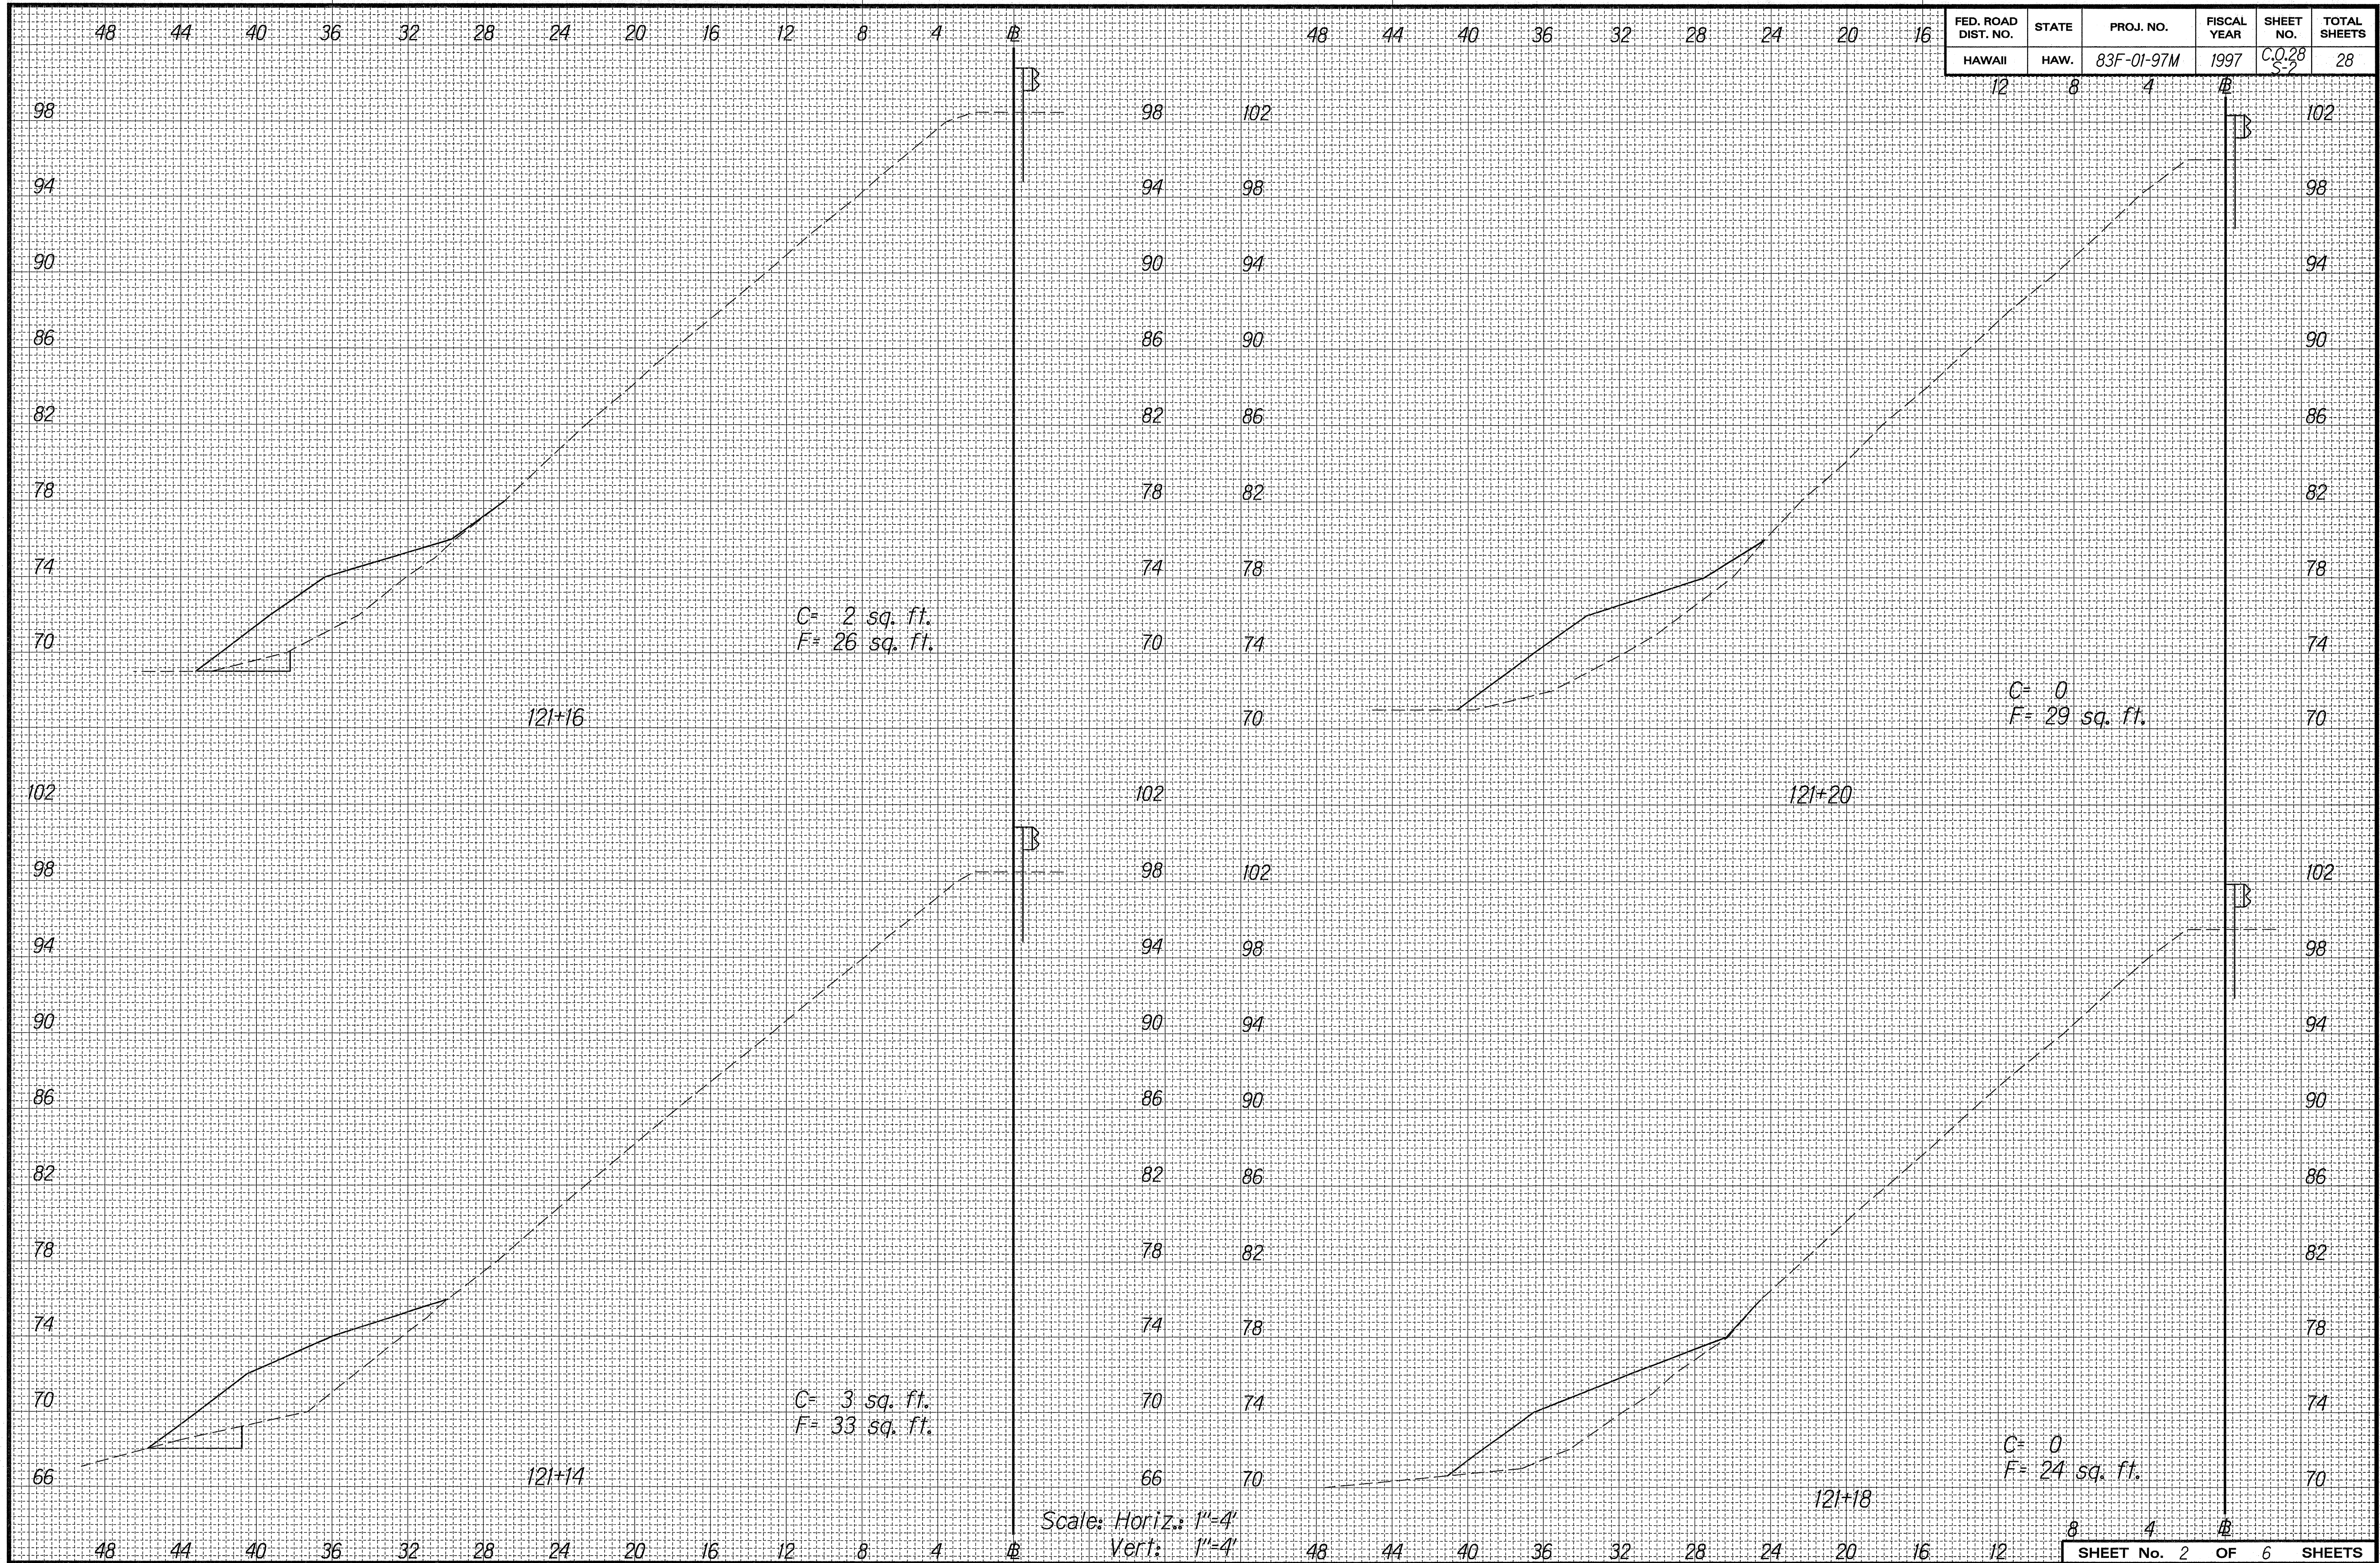


ORIGINAL PLAN	SURVEY PLOTTED BY	DATE
NOTE BOOK	DRAWN BY	11/19/91
QUANTITIES BY	TRACED BY	
2/10/92	1/1/92	

FED. ROAD DIST. NO.	STATE	PROJ. NO.	FISCAL YEAR	SHEET NO.	TOTAL SHEETS
HAWAII	HAW.	83F-01-97M	1997	C.O. 28 S-3	28

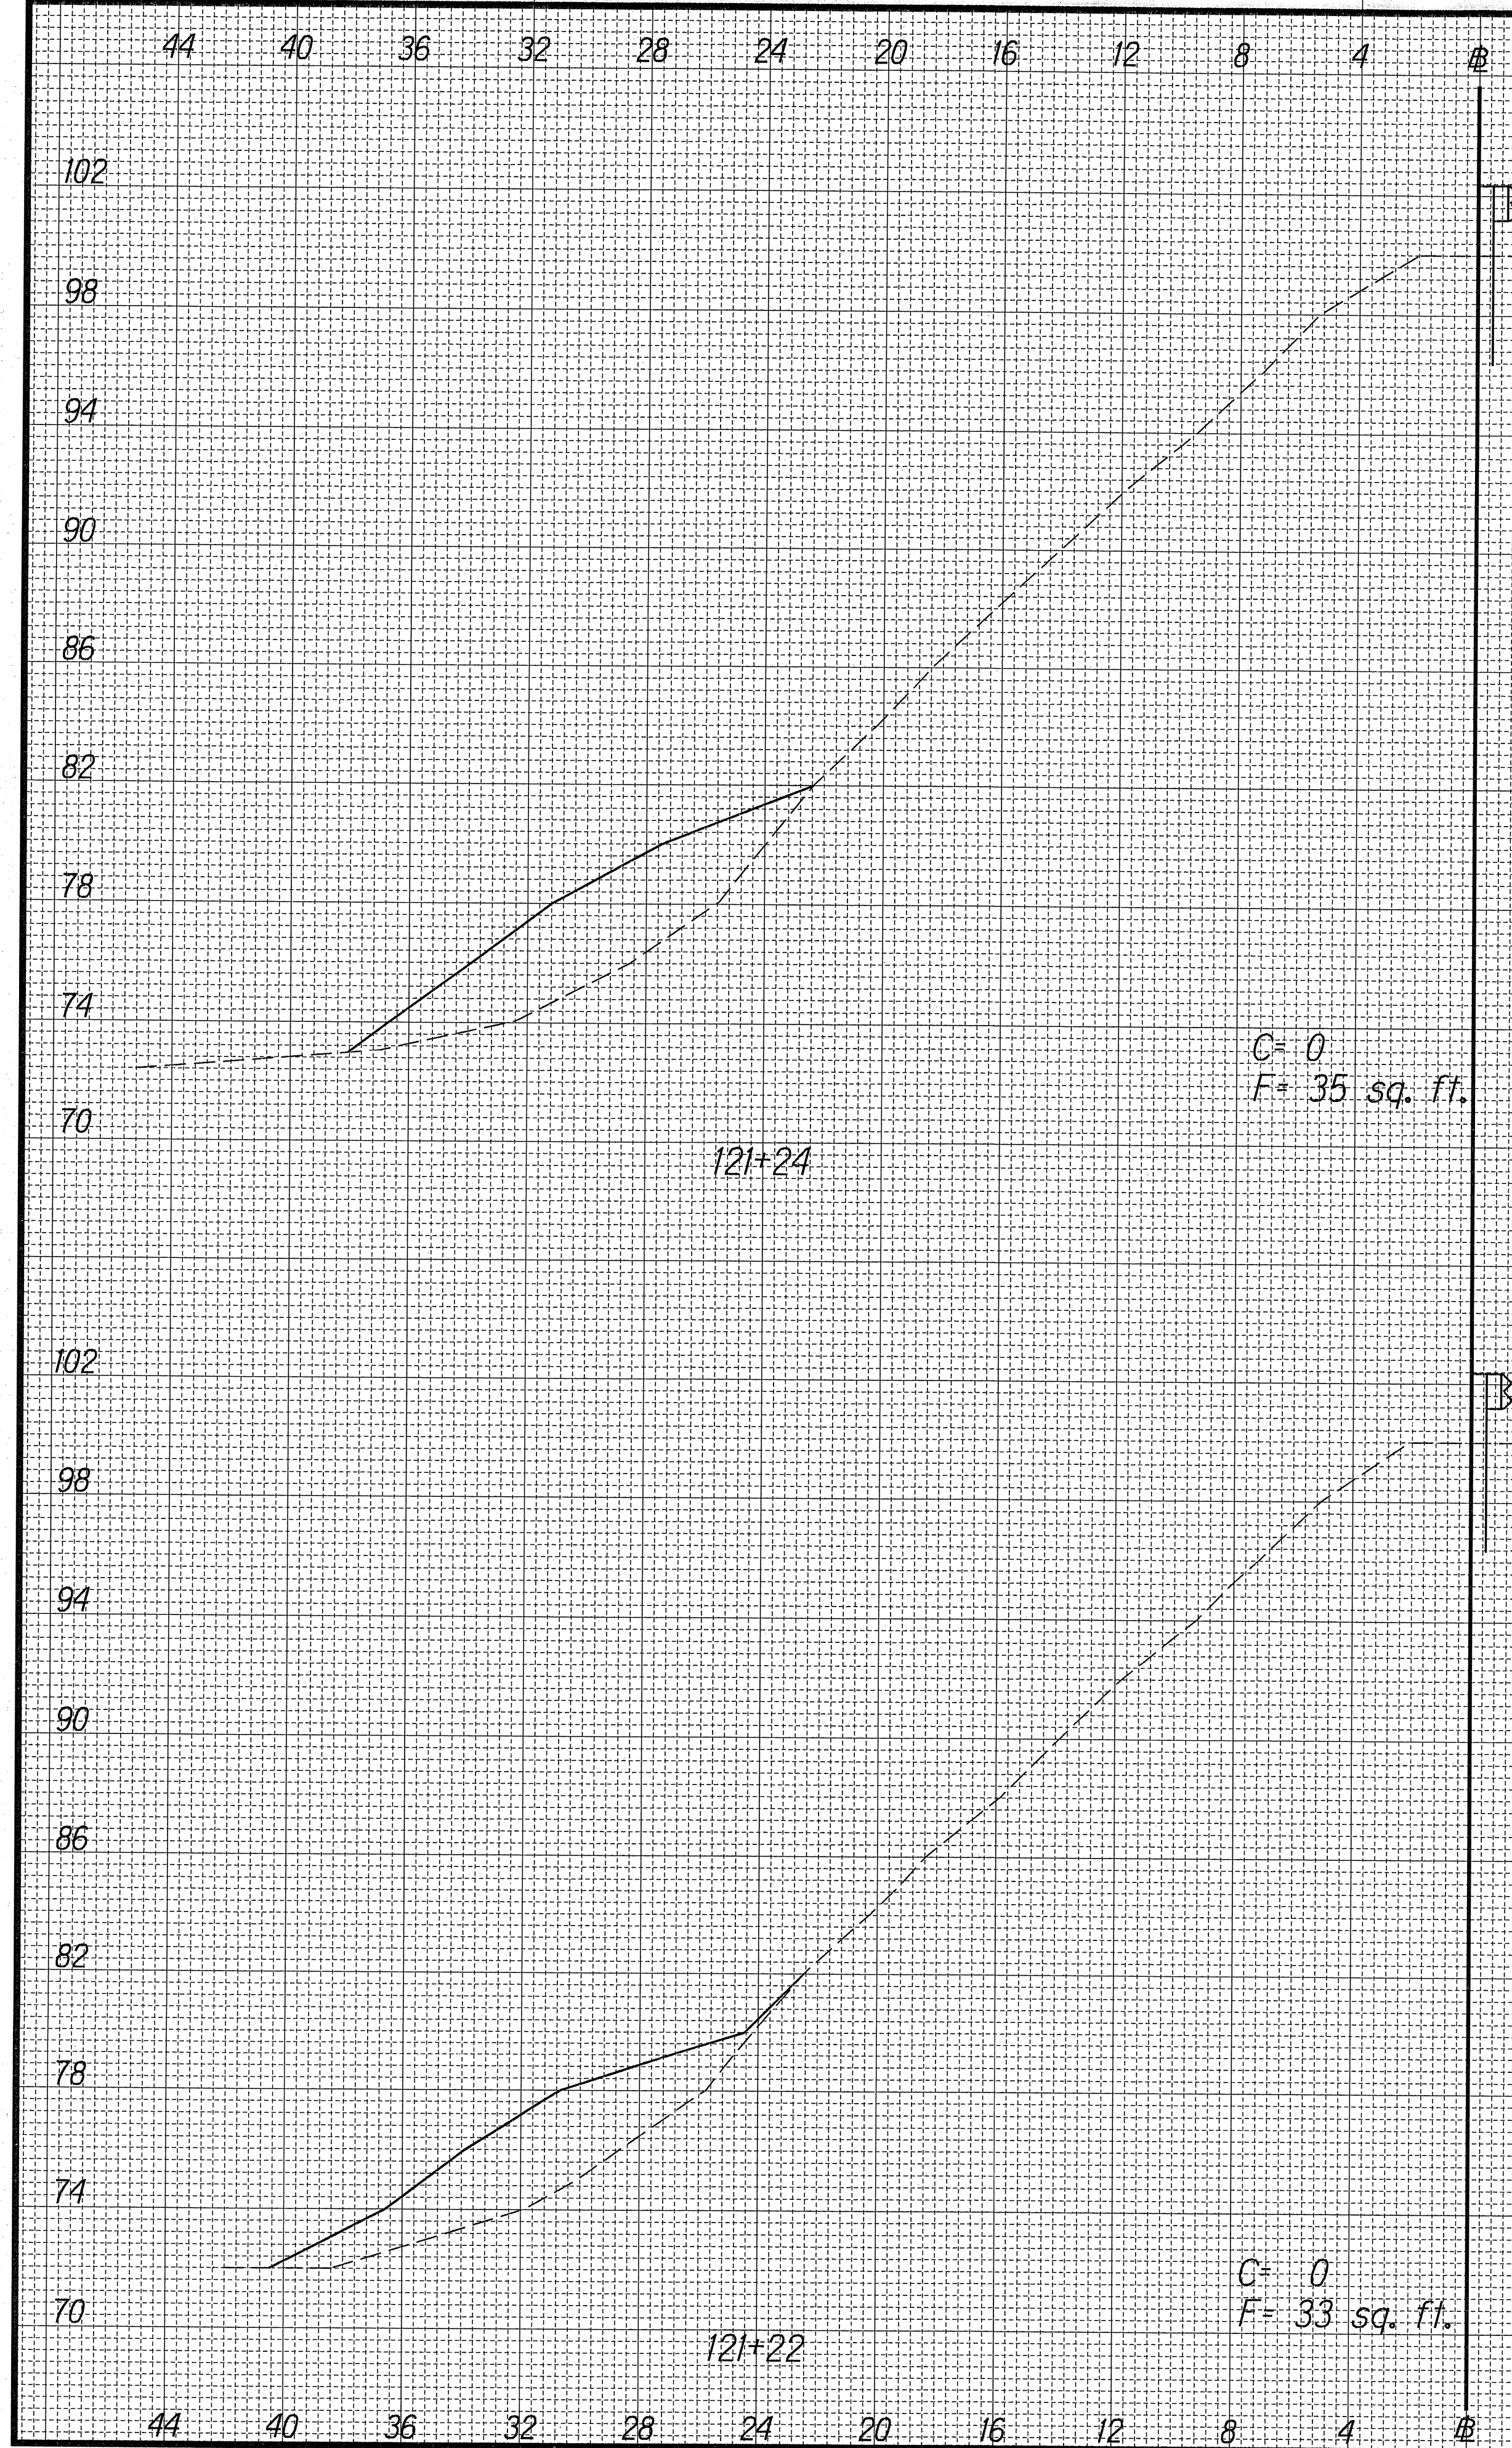


Scale: Horiz.: 1"=4'
Vert.: 1"=4'

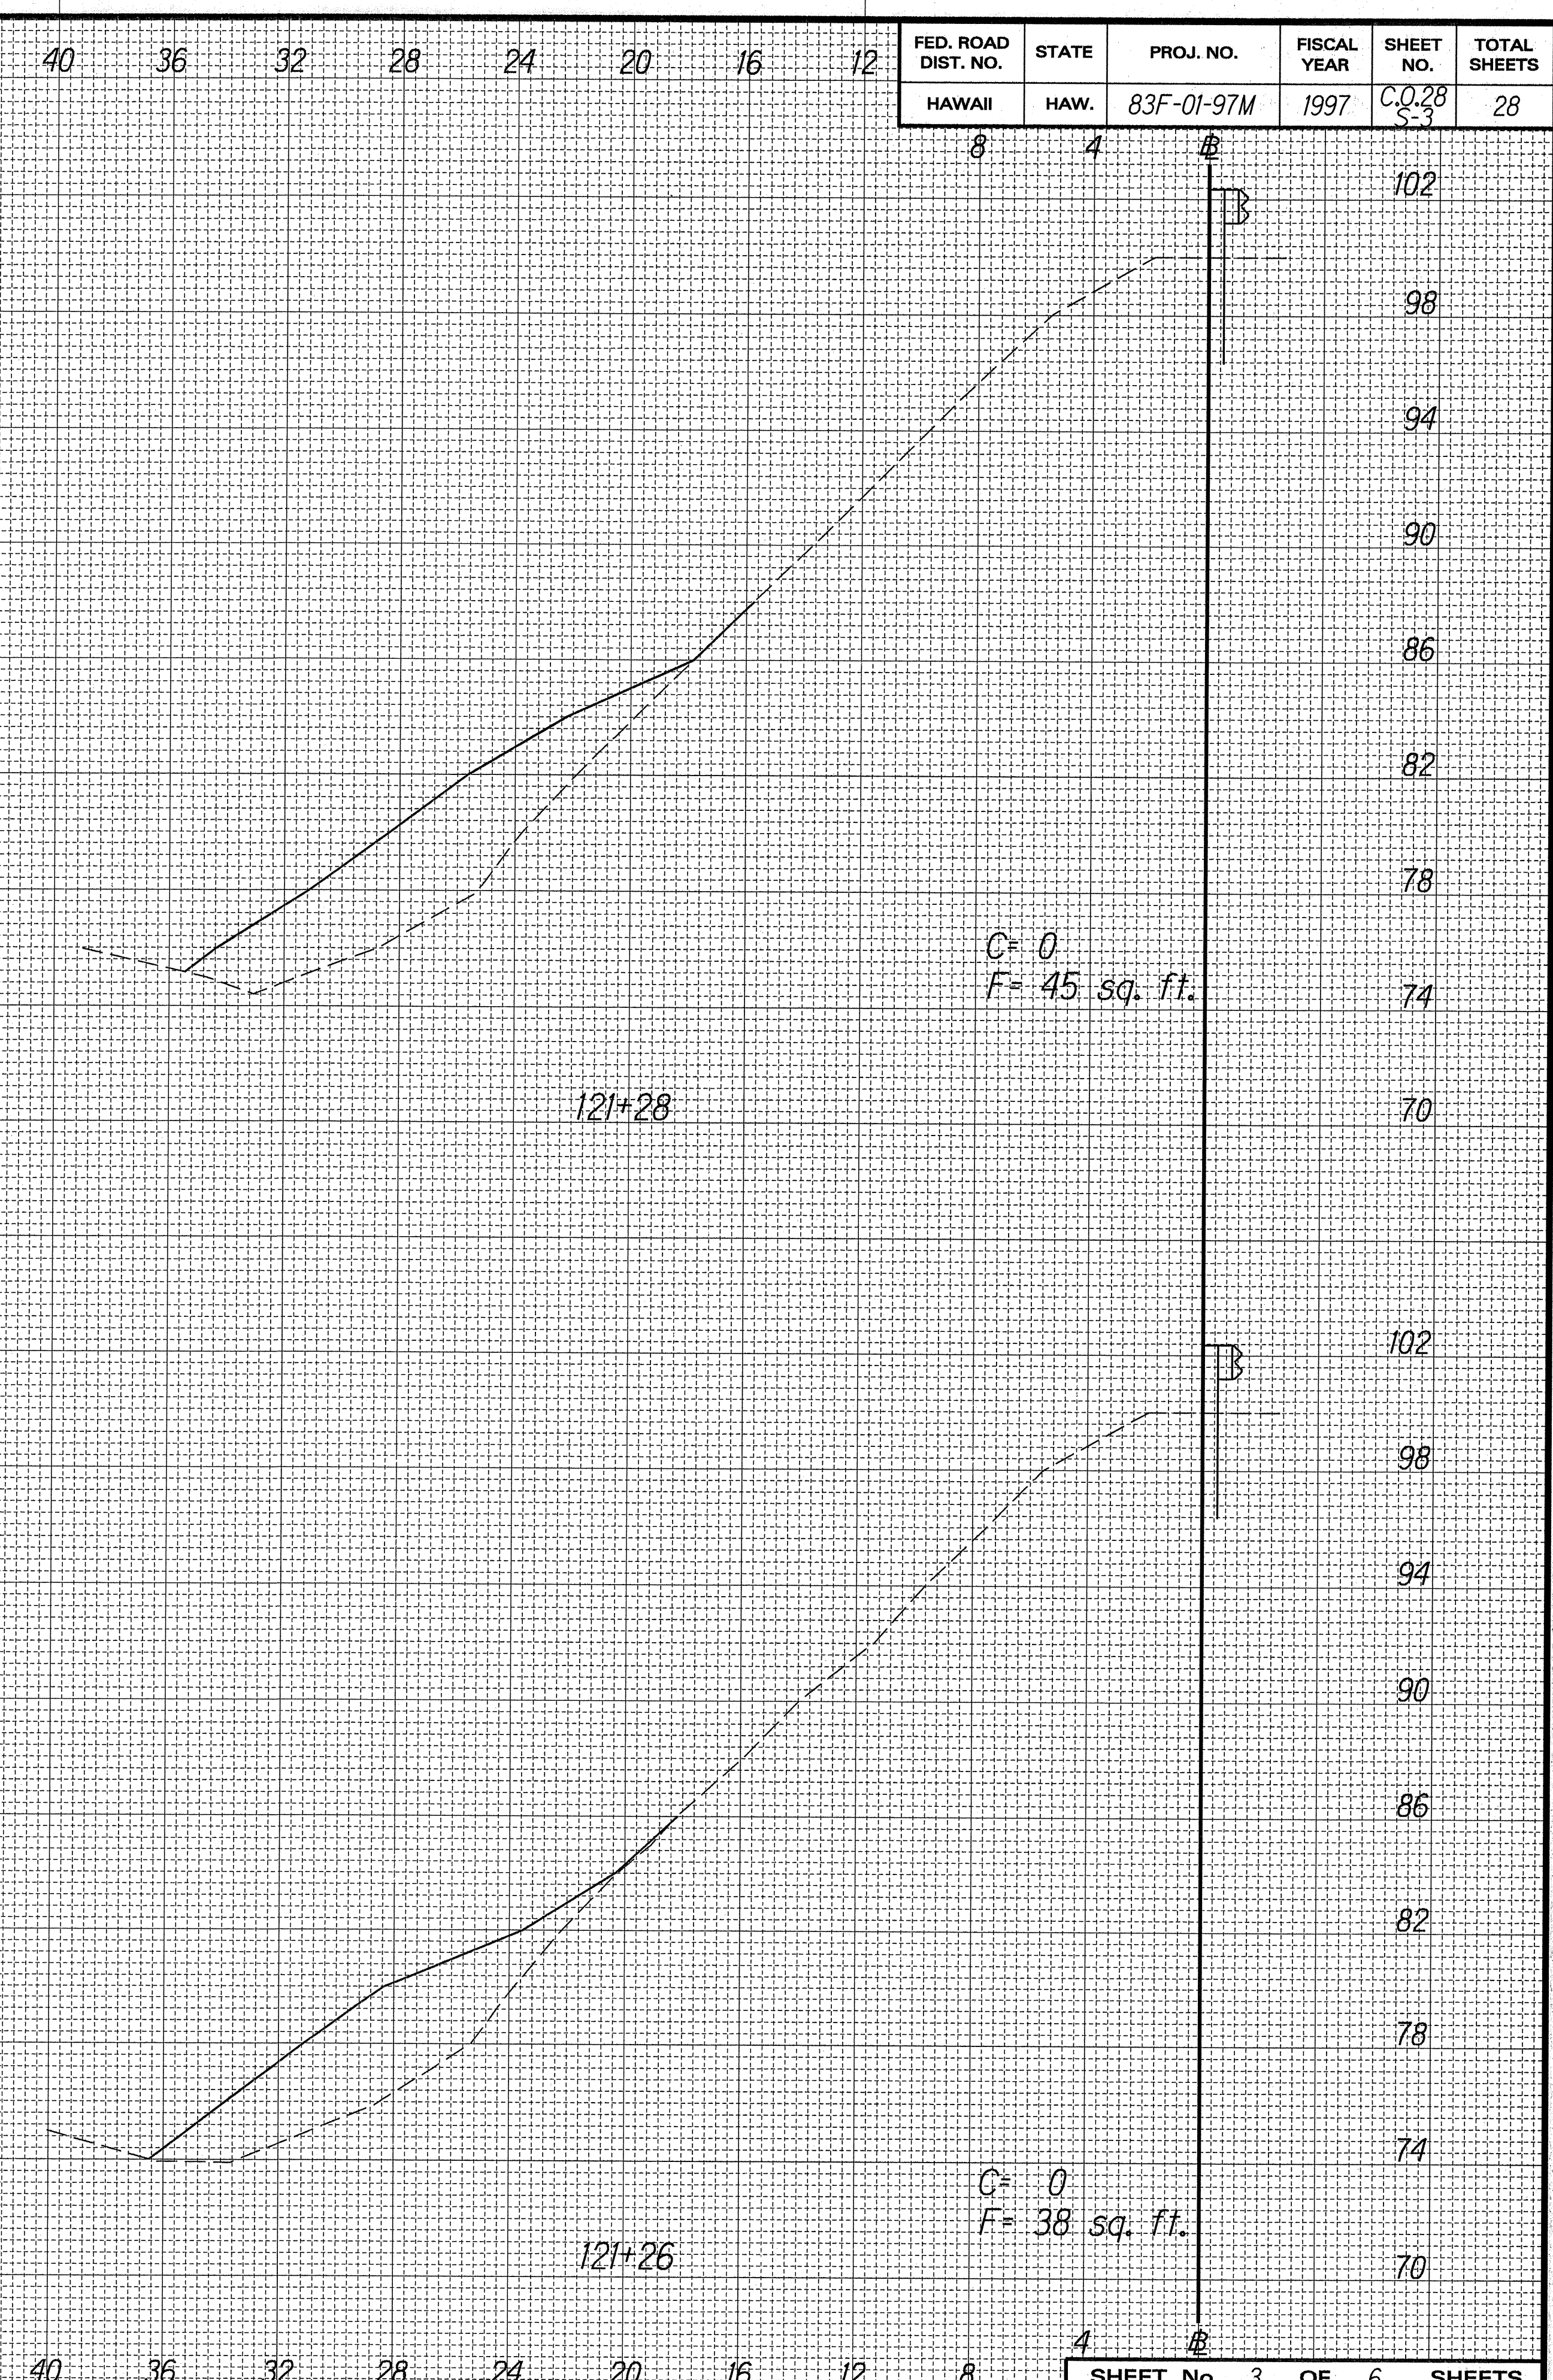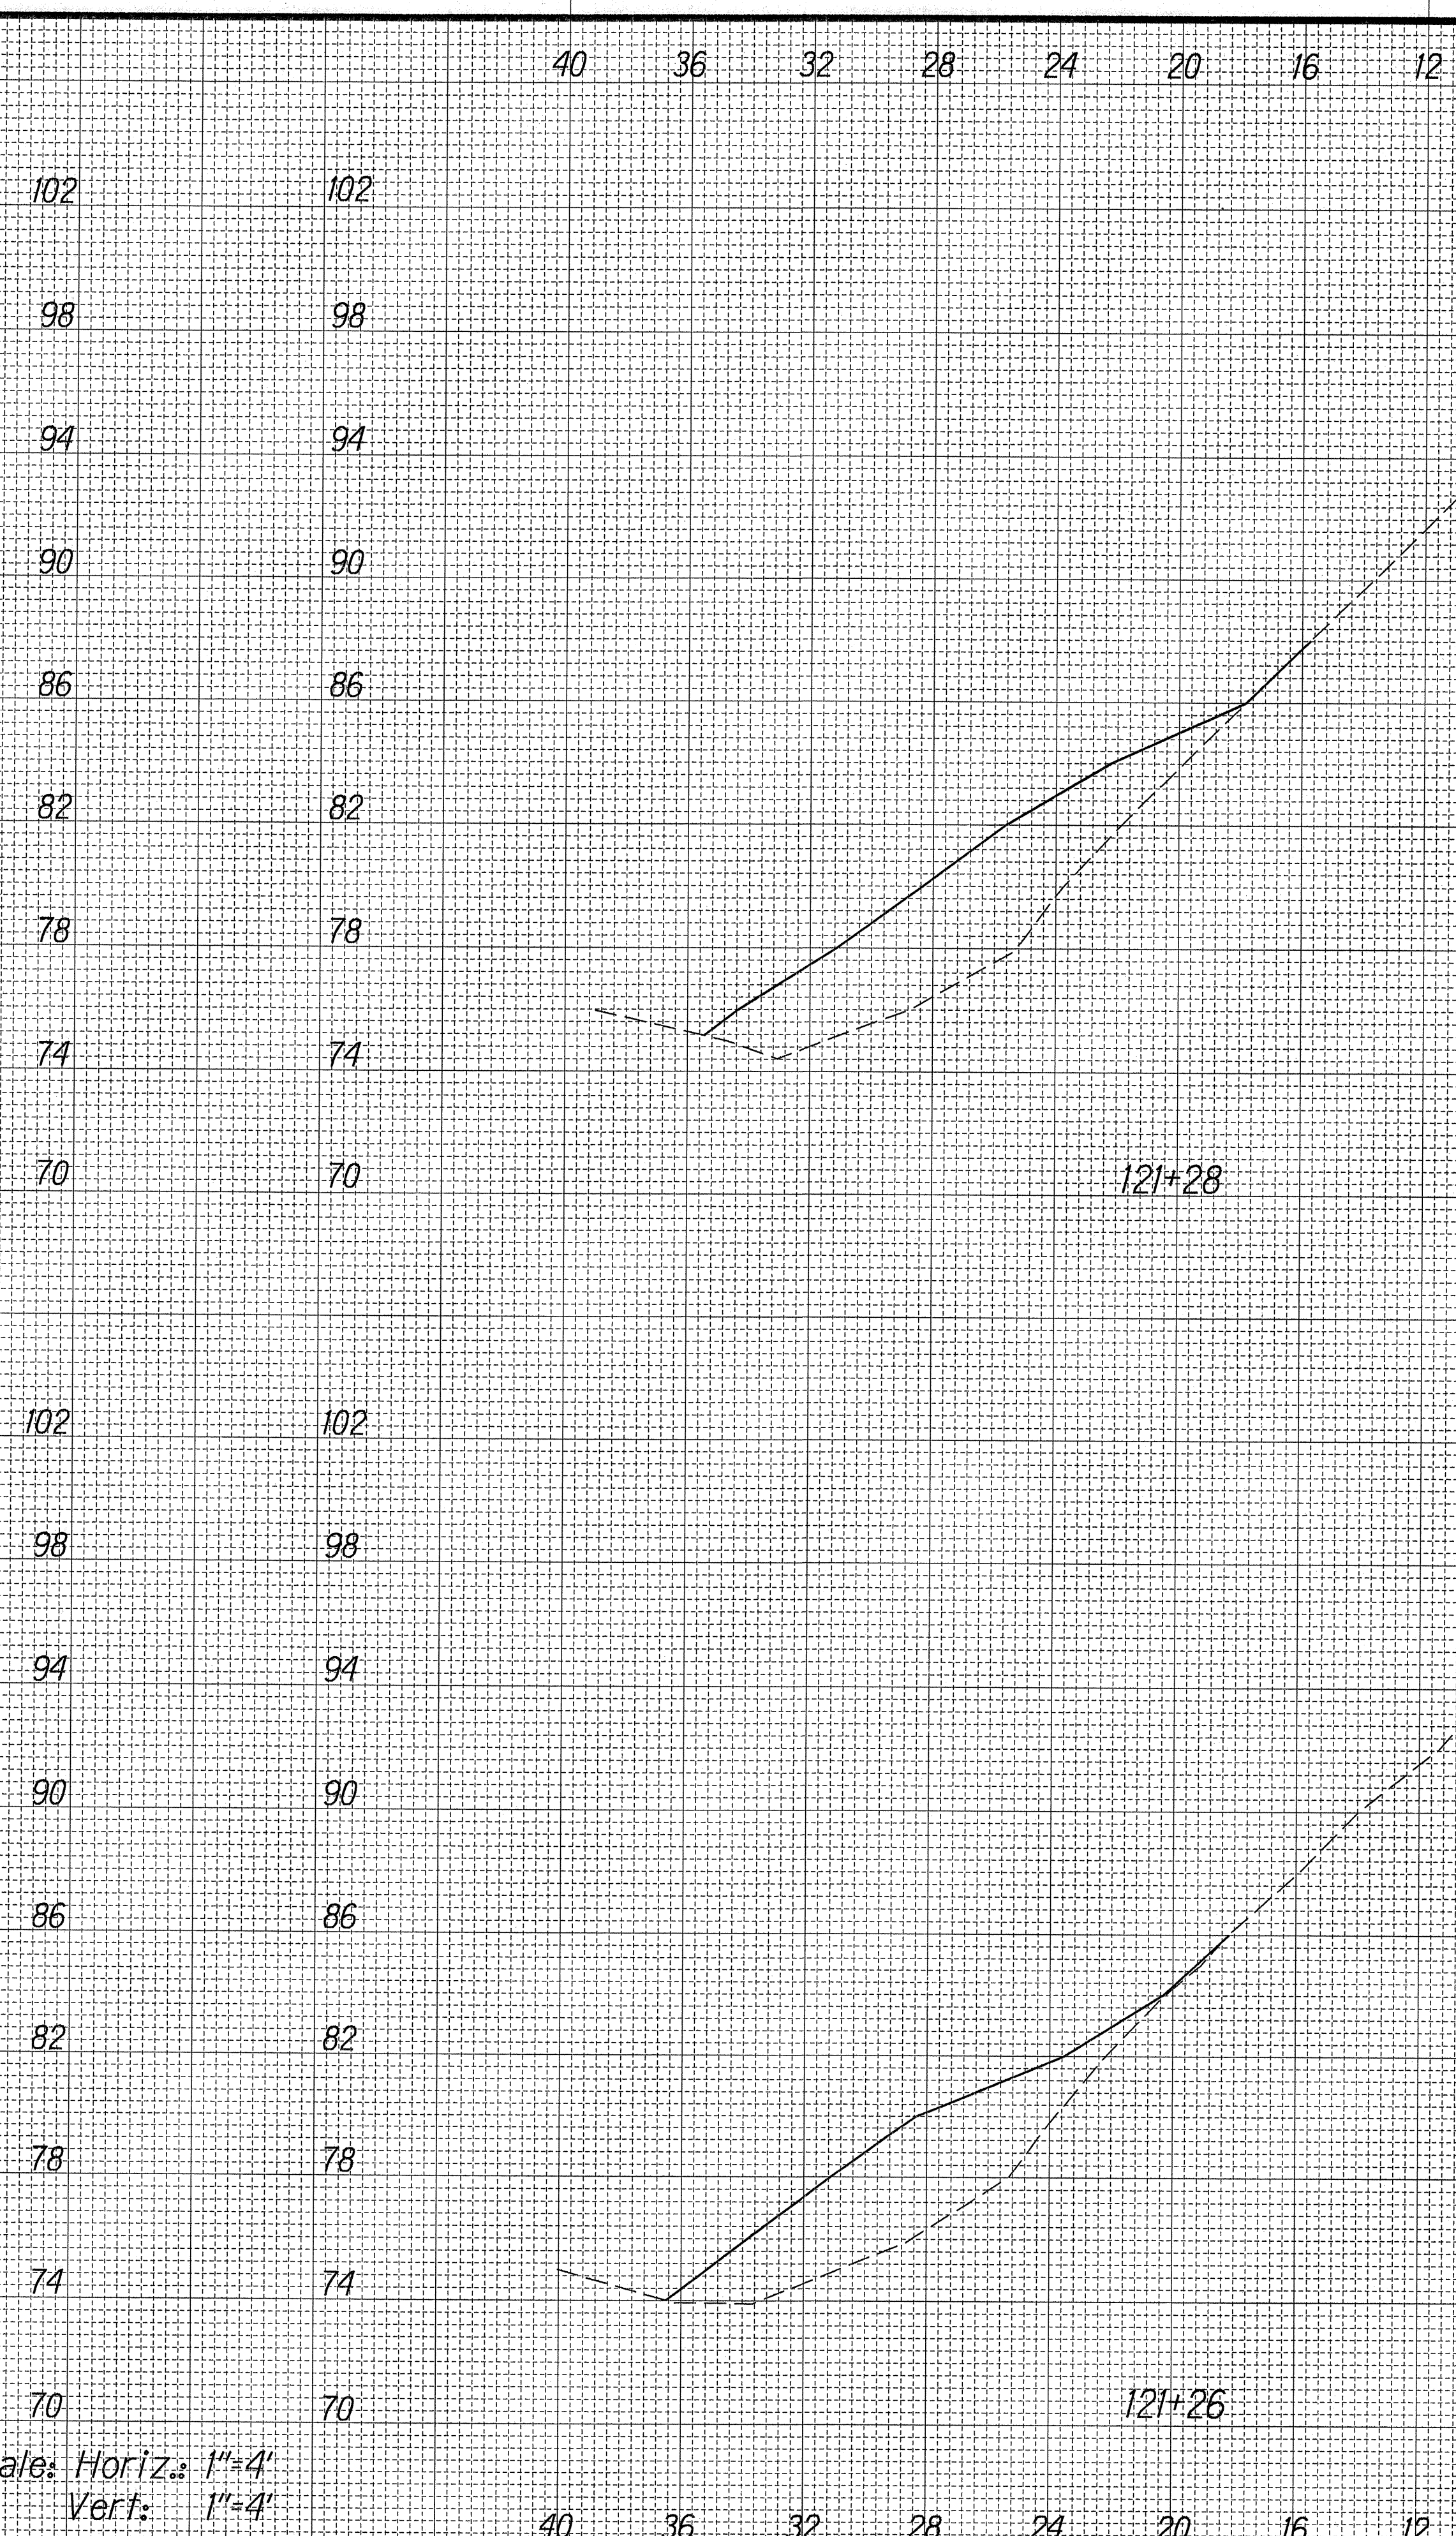


ORIGINAL PLAN
DATE: 11/19/97
SURVEY PLATTED BY: J. W. W. W.
DRAWN BY: J. W. W. W.
NOTE BOOK DESIGNED BY: J. W. W. W.
CHECKED BY: J. W. W. W.
N. 2nd ed. 63.

FED. ROAD DIST. NO.	STATE	PROJ. NO.	FISCAL YEAR	SHEET NO.	TOTAL SHEETS
HAWAII	HAW.	83F-01-97M	1997	C.O. 28 S-4	28

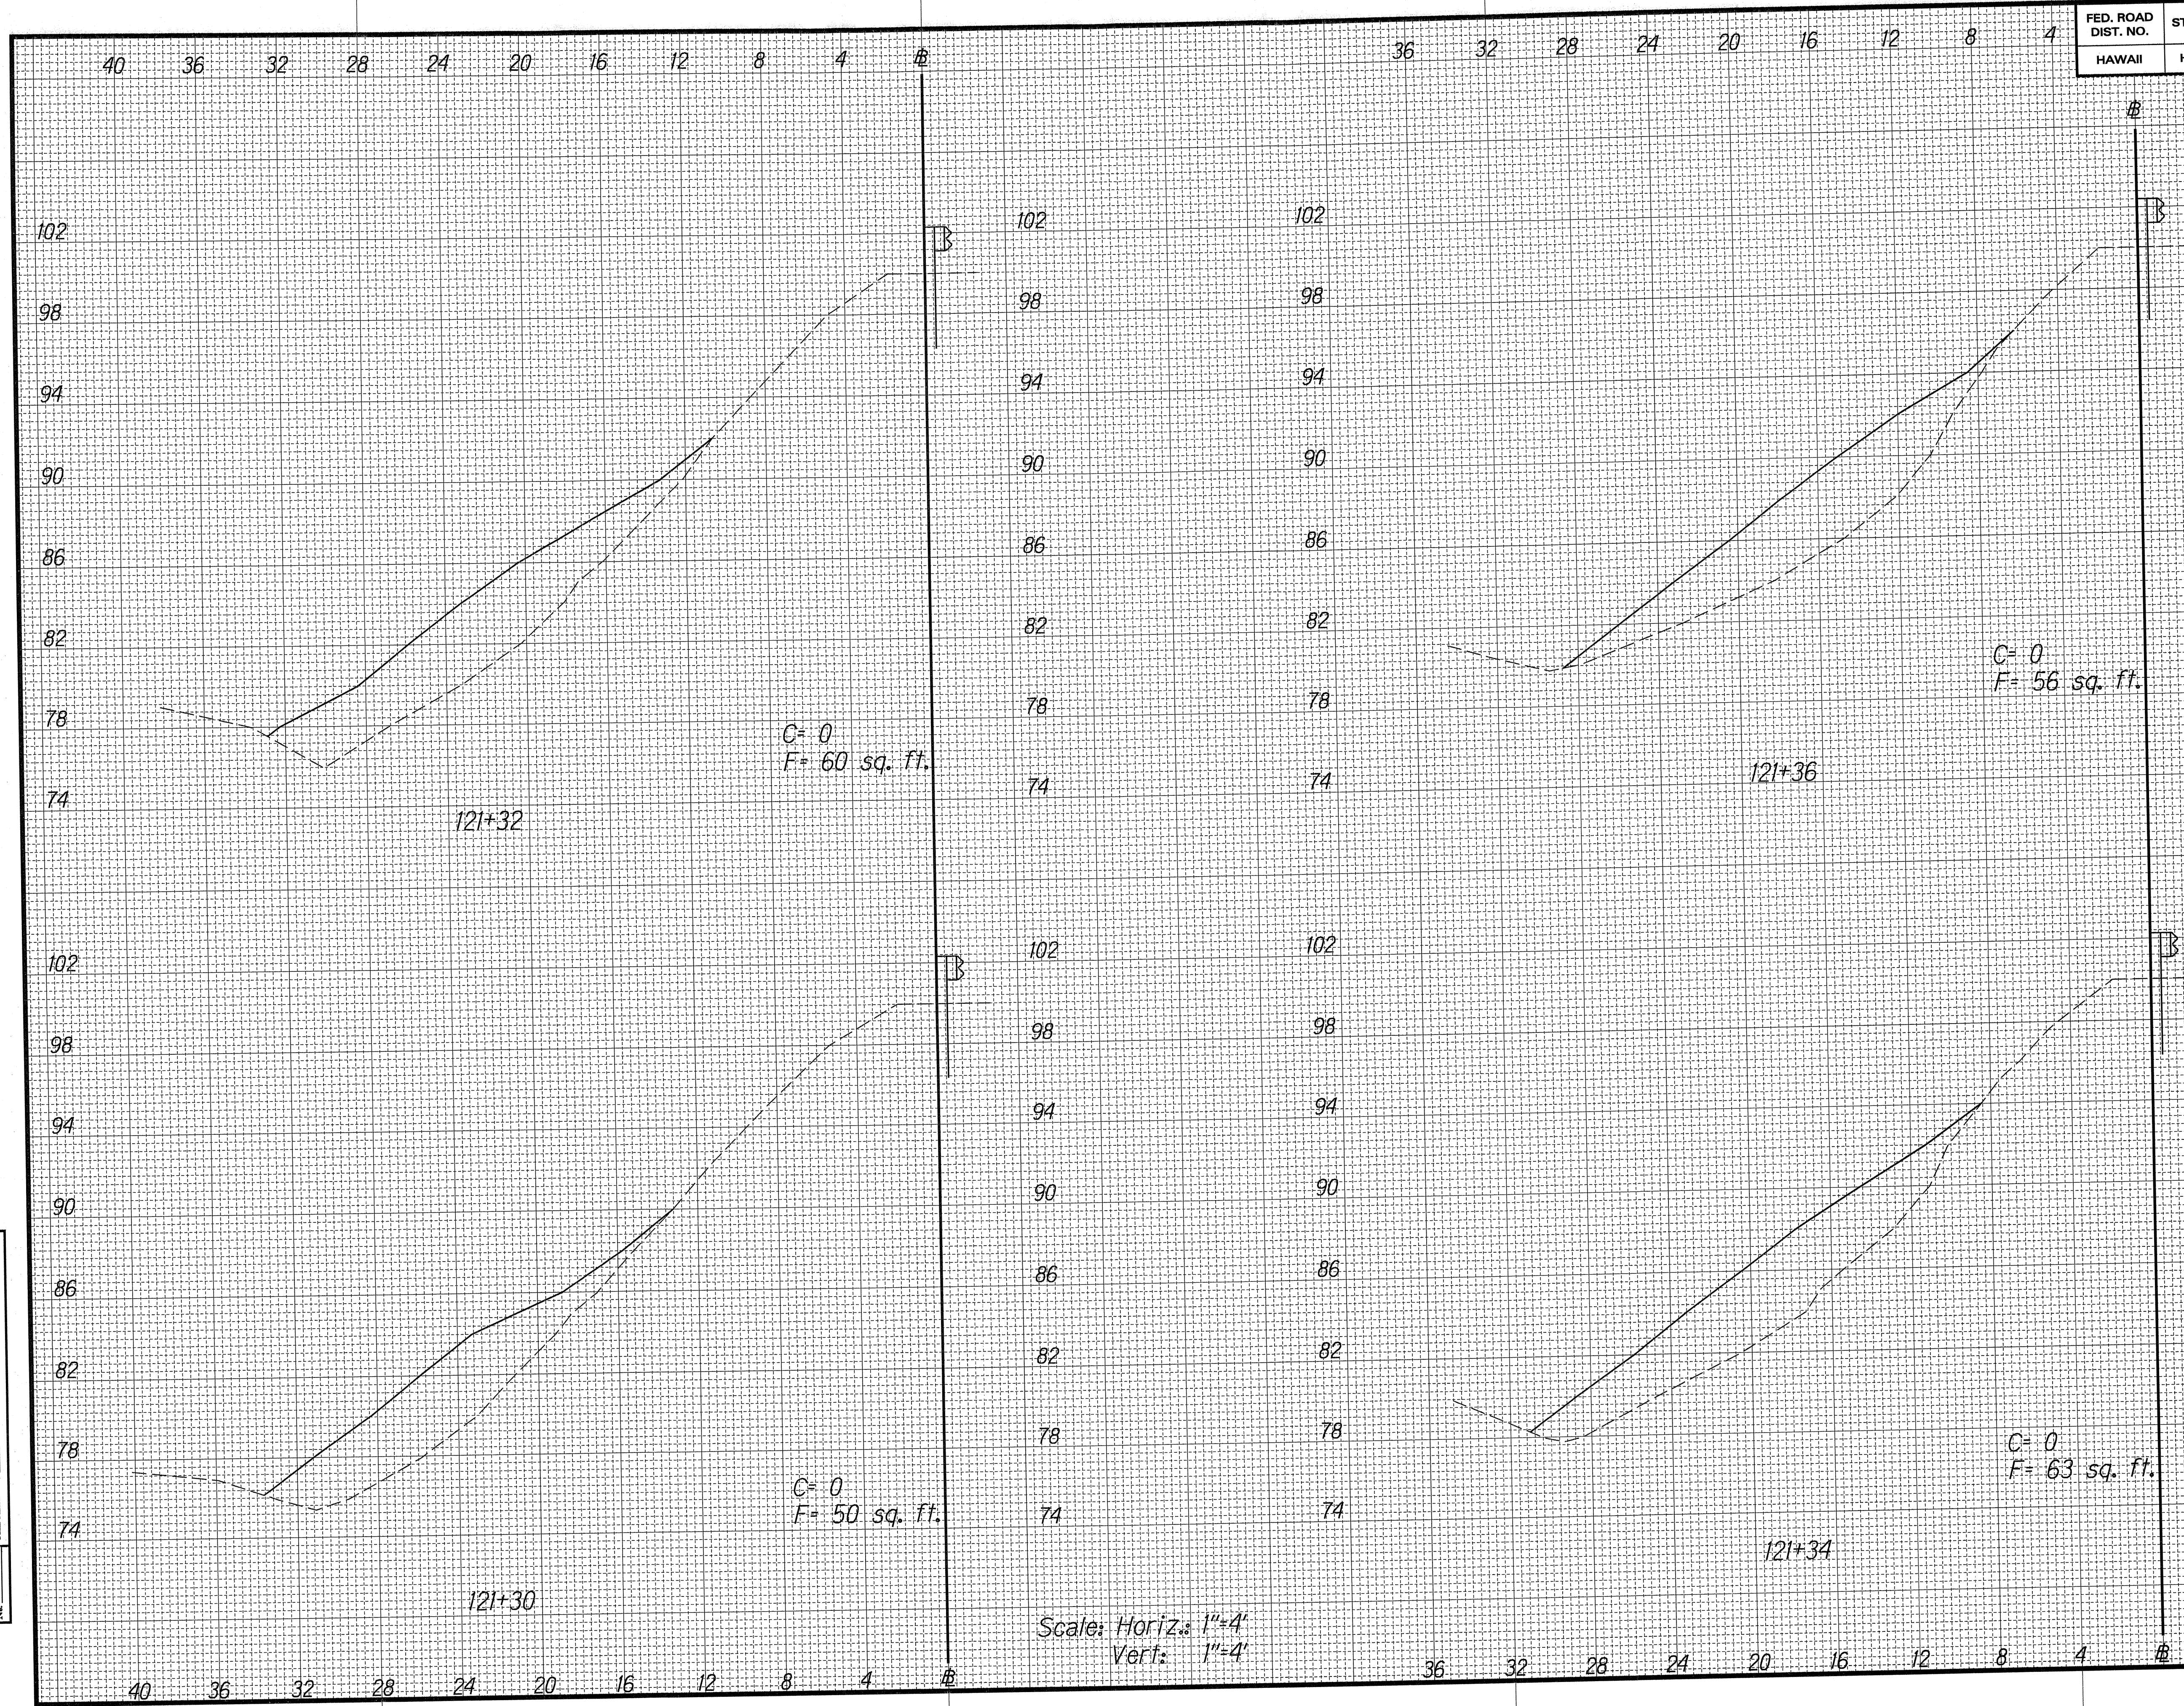

ORIGINAL PLAN
NOTE BOOK
DESIGNED BY J. W. W. W.
QUANTITIES BY
CHECKED BY
DATE 11/29/97


FED. ROAD DIST. NO.	STATE	PROJ. NO.	FISCAL YEAR	SHEET NO.	TOTAL SHEETS
HAWAII	HAW.	83F-01-97M	1997	C.O. 28 S-5	28

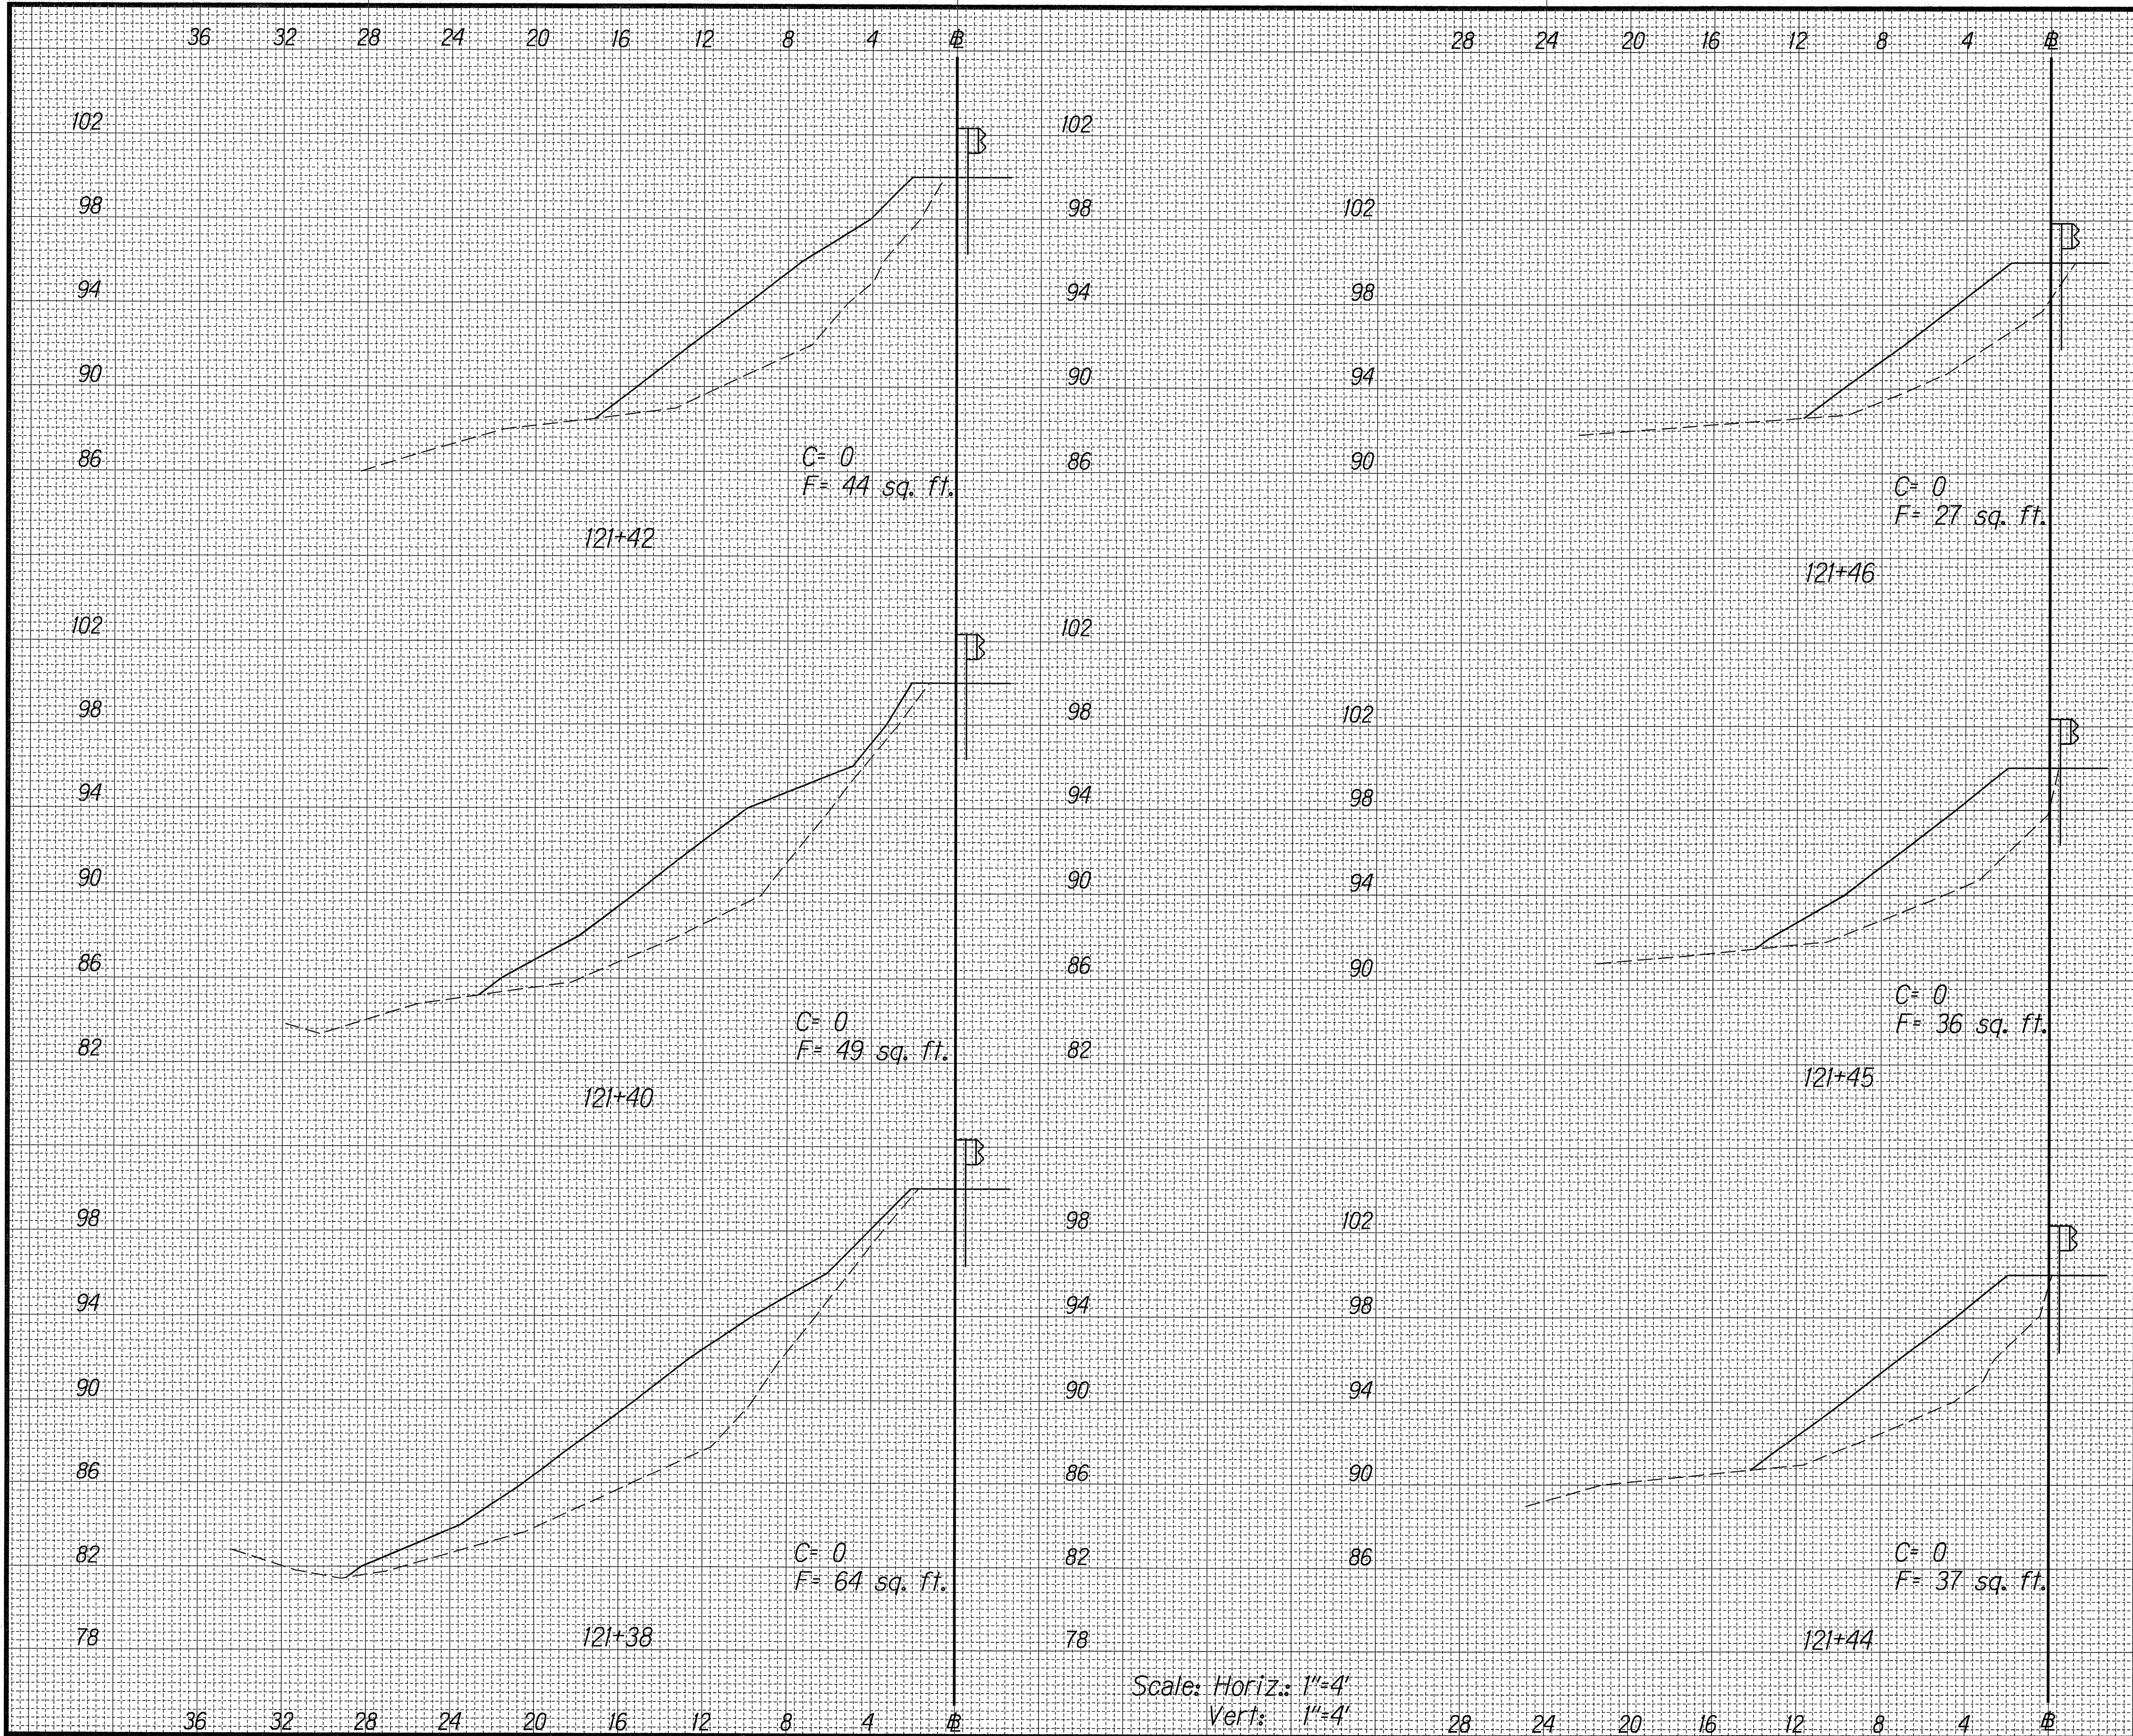

SURVEY PLOTTED BY _____ DATE 11/09/97
 DRAWN BY G.A.M.
 NOTE BOOK _____
 QUANTITIES BY _____
 CHECKED BY _____
 N. 211d655

Scale: Horiz.: 1"=4'
 Vert: 1"=4'

FED. ROAD DIST. NO.	STATE	PROJ. NO.	FISCAL YEAR	SHEET NO.	TOTAL SHEETS
HAWAII	HAW.	83F-01-97M	1997	C.O. 28 S-6	28

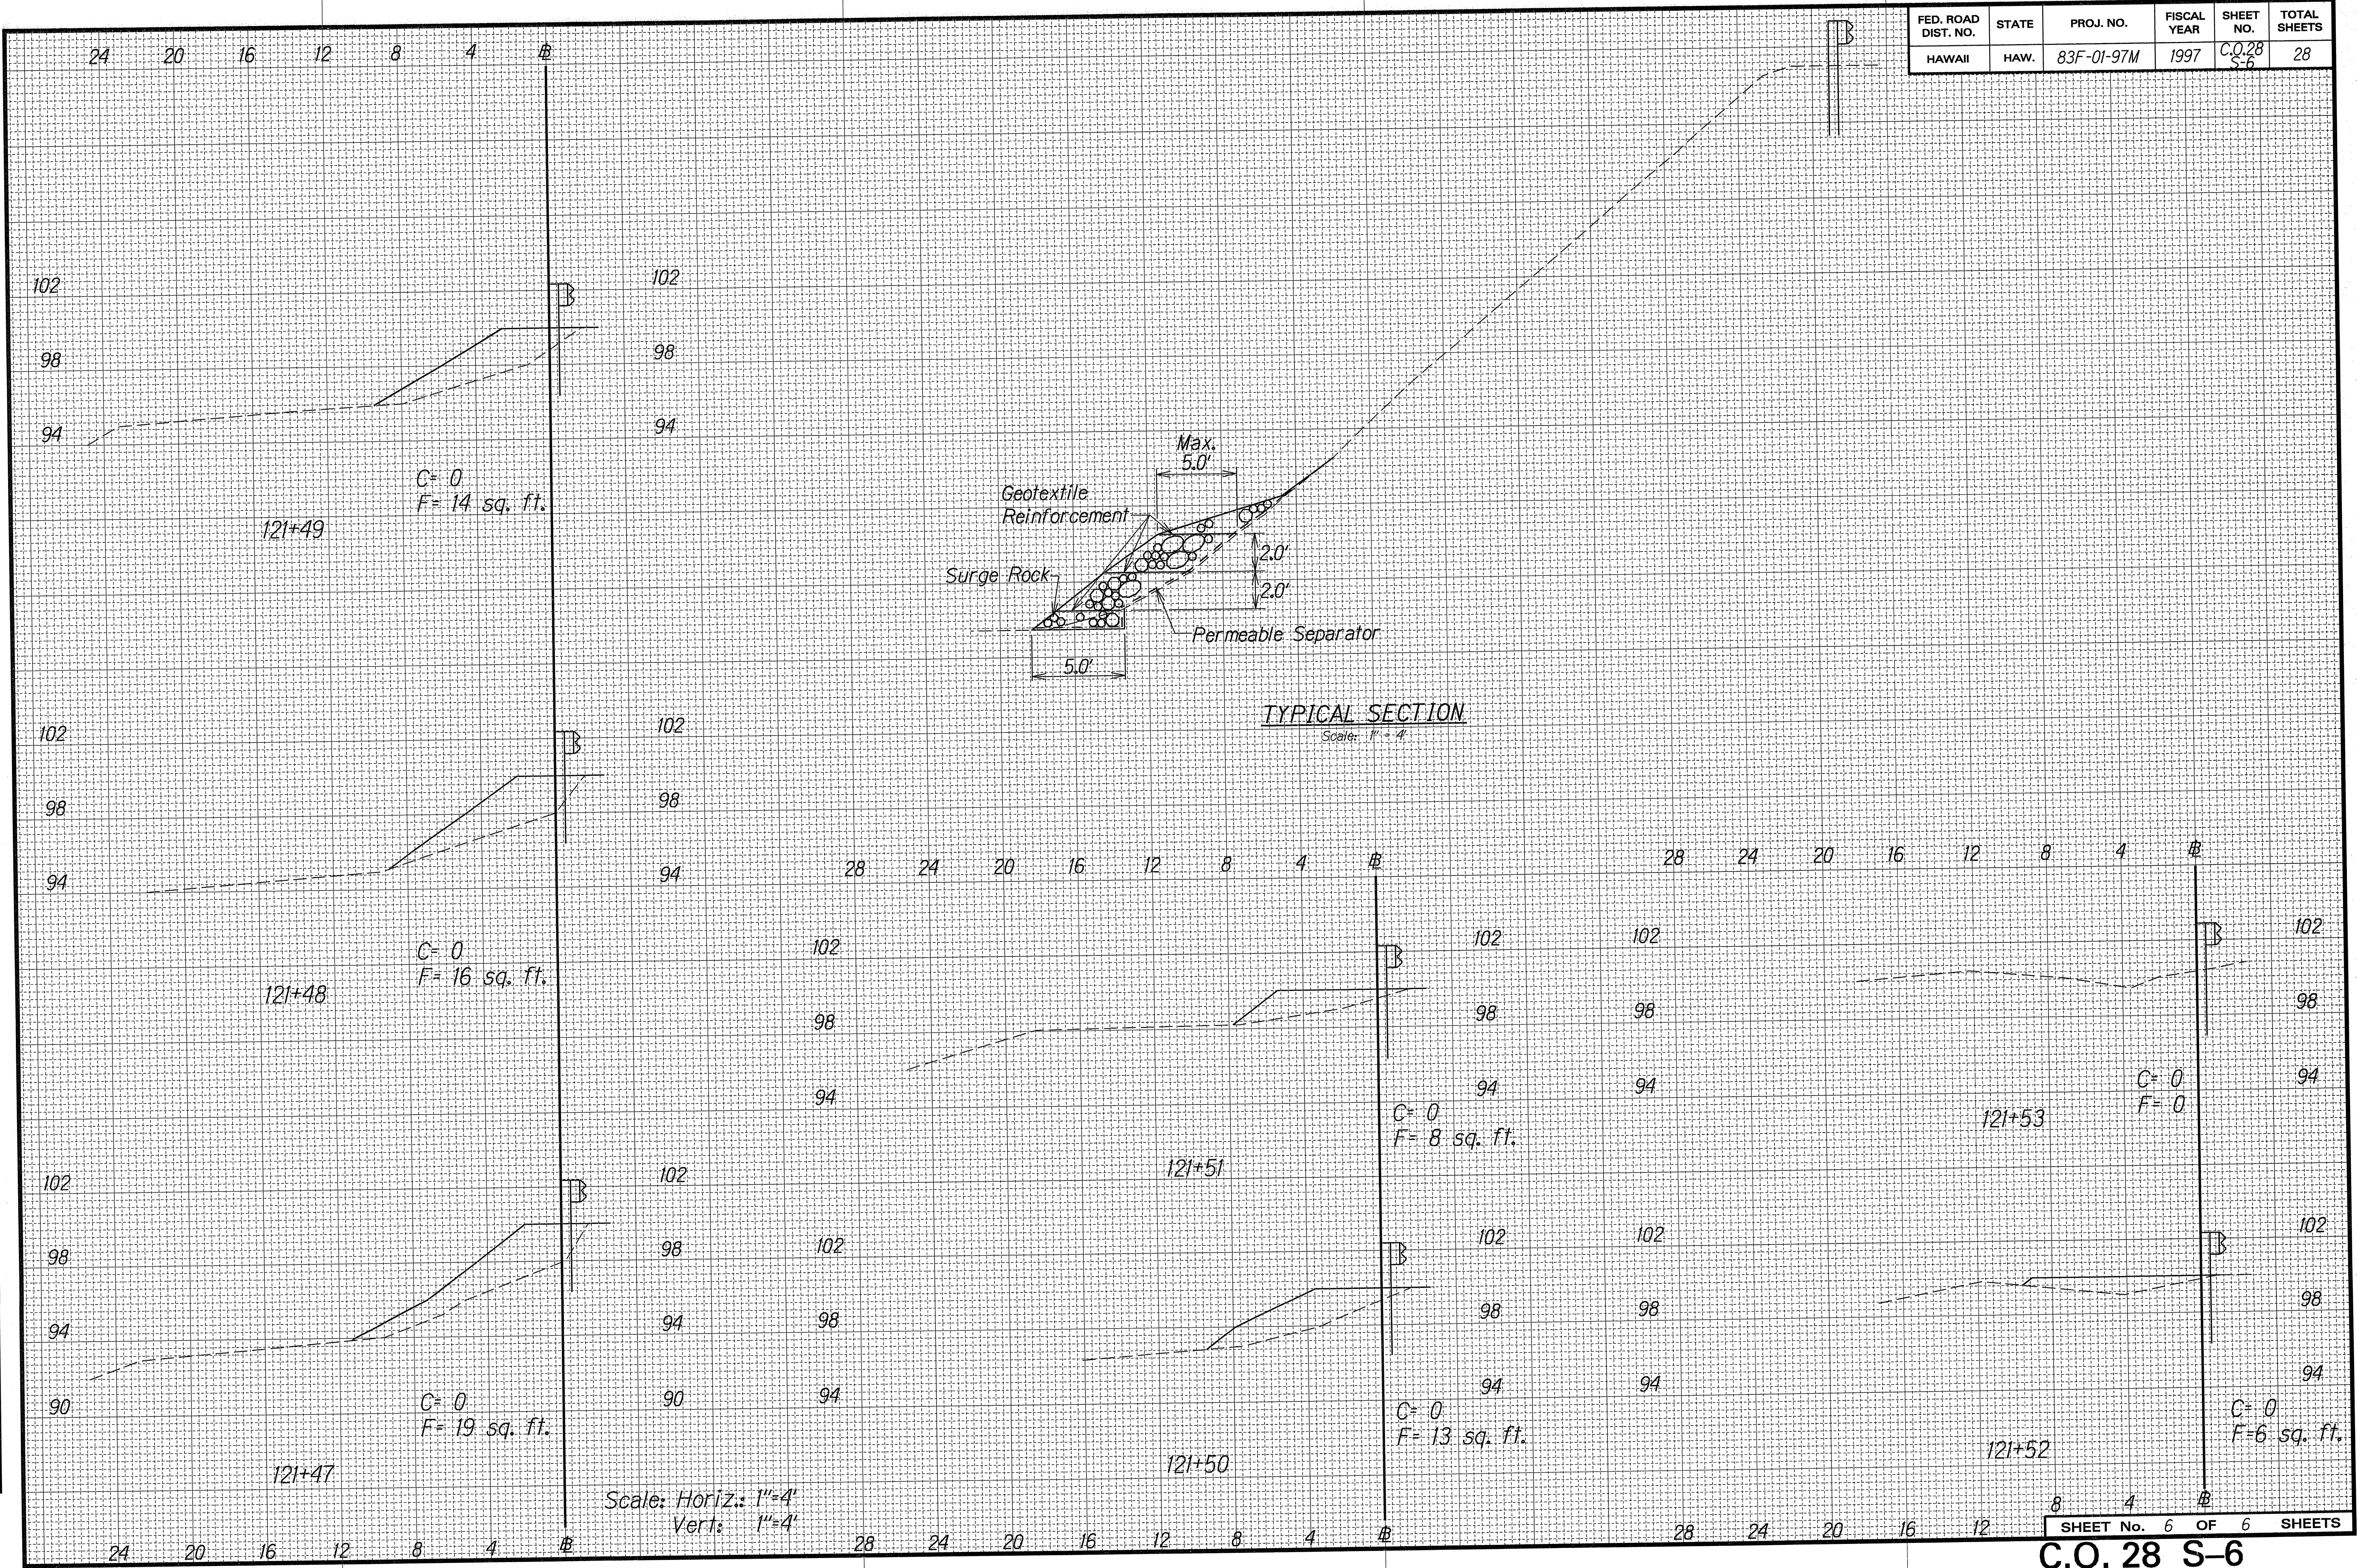

ORIGINAL PLAN	SURVEY PLOTTED BY	DATE
NOTED	DRAWN BY	11/19/97
DESIGNED BY	TRACED BY	
CHECKED BY	DESIGNED BY	
	CHECKED BY	