INDEX TO DRAWINGS	
SHEET NO.	DESCRIPTION
1	TITLE SHEET
2	STANDARD PLANS SUMMARY
3	GENERAL NOTES AND LEGEND
4 – 13	FOOTBRIDGE REPLACEMENT

FED. ROAD DIST. NO.	STATE	FED. AID PROJ. NO.	FISCAL YEAR	SHEET NO.	TOTAL SHEETS
HAWAII	HAW.	83C–01–97M	1997	1	13

STATE OF HAWAII

DEPARTMENT OF TRANSPORTATION

HIGHWAYS DIVISION

HONOLULU, HAWAII

"AS-BUILT"

PLANS FOR

KAMEHAMEHA HIGHWAY

REPLACE WOODEN FOOTBRIDGES
MULIWAI, HAUULA WAIPUHI AND MAHEIWI FOOTBRIDGES

PROJECT NO. 83C–01–97M

DISTRICT OF KOOLAULOA

ISLAND OF OAHU

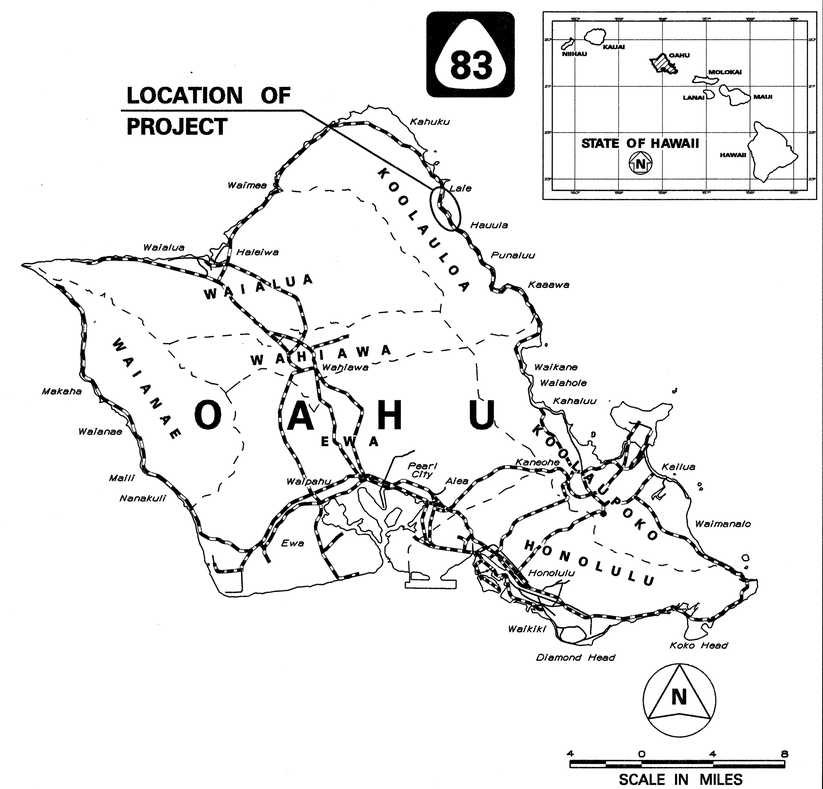

FEDERAL AID PROJECTS PREVIOUSLY CONSTRUCTED OR UNDER CONSTRUCTION

MILE POST 21.31 TO MILE POST 21.75

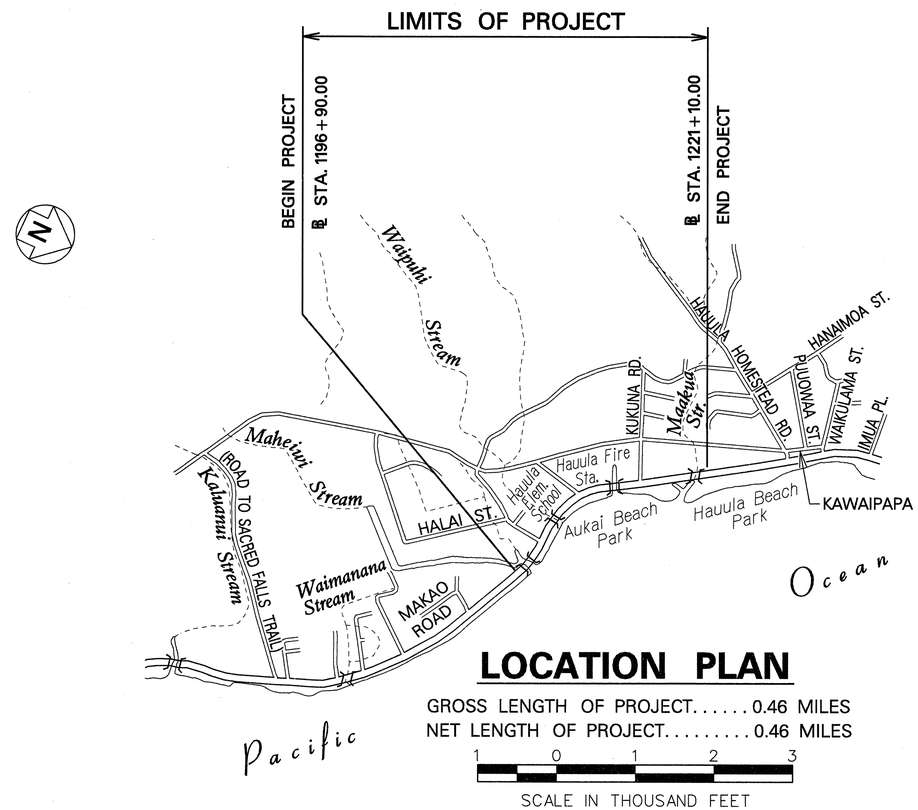

LOCATION PLAN

GROSS LENGTH OF PROJECT..... 0.46 MILES

NET LENGTH OF PROJECT..... 0.46 MILES

1 0 1 2 3

SCALE IN THOUSAND FEET

CHANGES MADE DURING CONSTRUCTION HAVE BEEN INCORPORATED ON THESE PLANS EXCEPT CHANGES IN THE ORIGINAL THEORETICAL QUANTITIES. FOR ACTUAL QUANTITIES, REFER TO PROJECT LEDGER AND/OR COMPUTATION BOOK.

RESIDENT ENGINEER — DATE 11/27/01

DEPARTMENT OF TRANSPORTATION
STATE OF HAWAII

APPROVED:

for DIR. OF TRANSPORTATION — DATE 6-5-97

HWY-DB	R. HIRONAKA	587-2250	MAY, 1997
DESIGNED BY	P. S. & E. BY	PHONE	DATE

login: george Okandtsht.dgn 5-16-97