INDEX TO DRAWINGS	
SHEET NO.	DESCRIPTION
1	TITLE SHEET
2	STANDARD PLAN SUMMARY
3	GENERAL NOTES AND LEGEND
4	GENERAL NOTES
5	DRAINAGE PLAN
6	DRAINAGE PROFILE
7–10	DRAINAGE DETAILS

FED. ROAD DIST. NO.	STATE	PROJ. NO.	FISCAL YEAR	SHEET NO.	TOTAL SHEETS
HAWAII	HAW.	83F–02–99	2000	1	10

STATE OF HAWAII

DEPARTMENT OF TRANSPORTATION

HIGHWAYS DIVISION

HONOLULU, HAWAII

PLANS FOR "AS-BUILT"

KAHEKILI HIGHWAY DRAINAGE IMPROVEMENTS

VICINITY OF HUI IWA STREET

PROJECT NO. 83F–02–99

DISTRICT OF KOOLAUPOKO

ISLAND OF OAHU

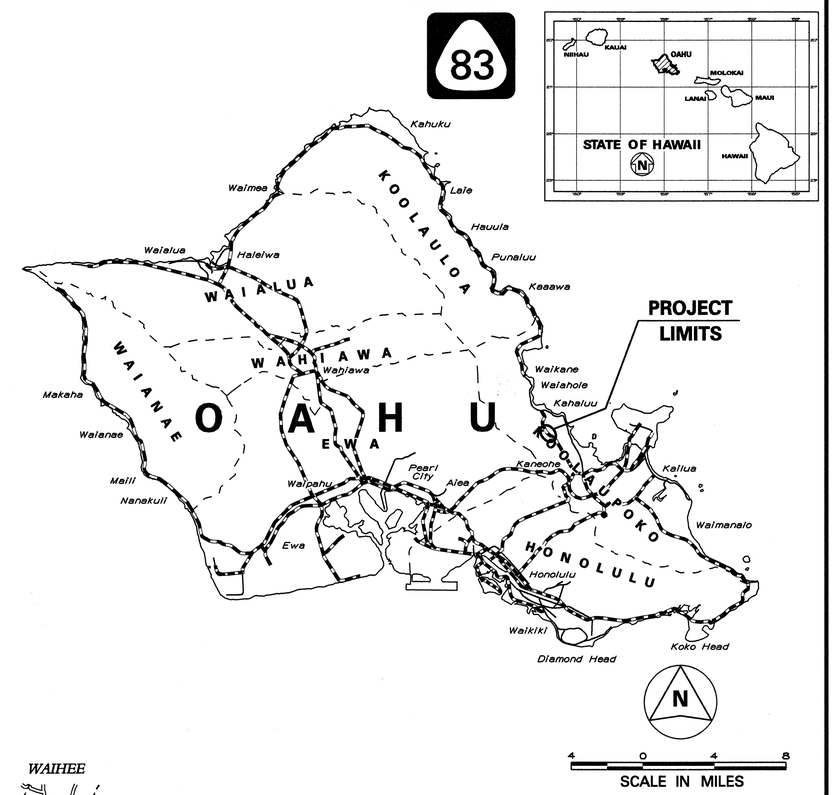

BEGIN PROJ. ⊕ STA. 152+30

END PROJ. ⊕ STA. 156+20

PROJECT LIMITS

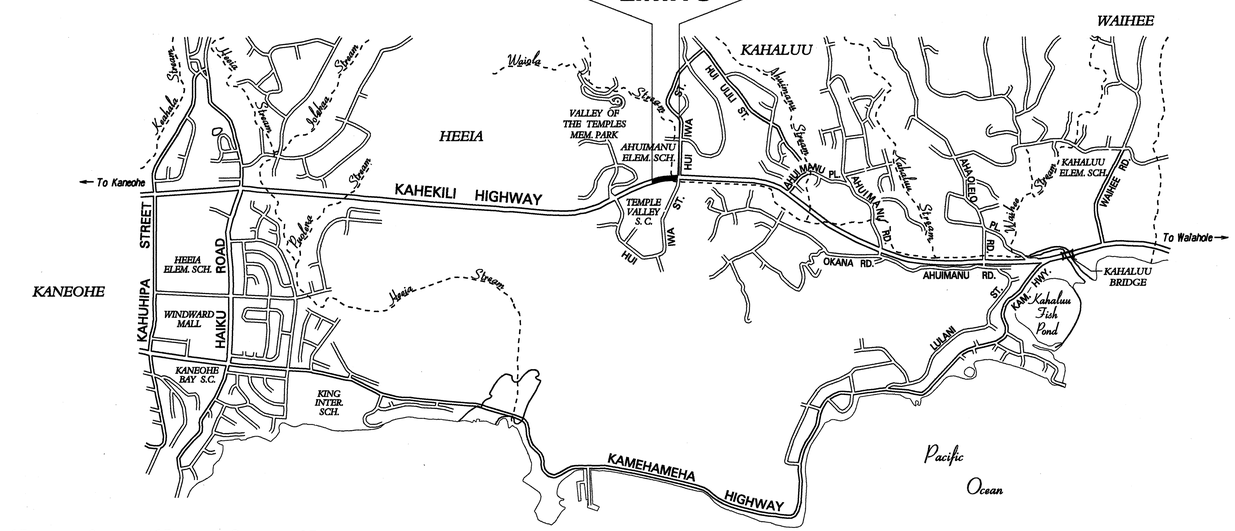

LAYOUT PLAN

GROSS LENGTH OF PROJECT..... 0.09 MILE

NET LENGTH OF PROJECT..... 0.09 MILE

FEDERAL AID PROJECTS PREVIOUSLY CONSTRUCTED OR UNDER CONSTRUCTION

MILE POST 38.07 TO MILE POST 37.98

CHANGES MADE DURING CONSTRUCTION HAVE BEEN INCORPORATED ON THESE PLANS EXCEPT CHANGES IN THE ORIGINAL THEORETICAL QUANTITIES. FOR ACTUAL QUANTITIES, REFER TO PROJECT LEDGER AND/OR COMPUTATION BOOK.

Gilbert Hara 12/3/01

RESIDENT ENGINEER DATE

DEPARTMENT OF TRANSPORTATION STATE OF HAWAII	
APPROVED:	
Rodney Haraguchi	9/27/99
DIR. OF TRANSPORTATION	DATE

HWY-DH	R. HIRONAKA	692-7575	AUG., 1999
DESIGNED BY	P. S. & E. BY	PHONE	DATE

dhl:randy:3kil
3kilhfsh.dgn