FED. ROAD DIST. NO.	STATE	FED. AID PROJ. NO.	FISCAL YEAR	SHEET NO.	TOTAL SHEETS
HAWAII	HAW.	NH-083-1(46)	2002	17	89

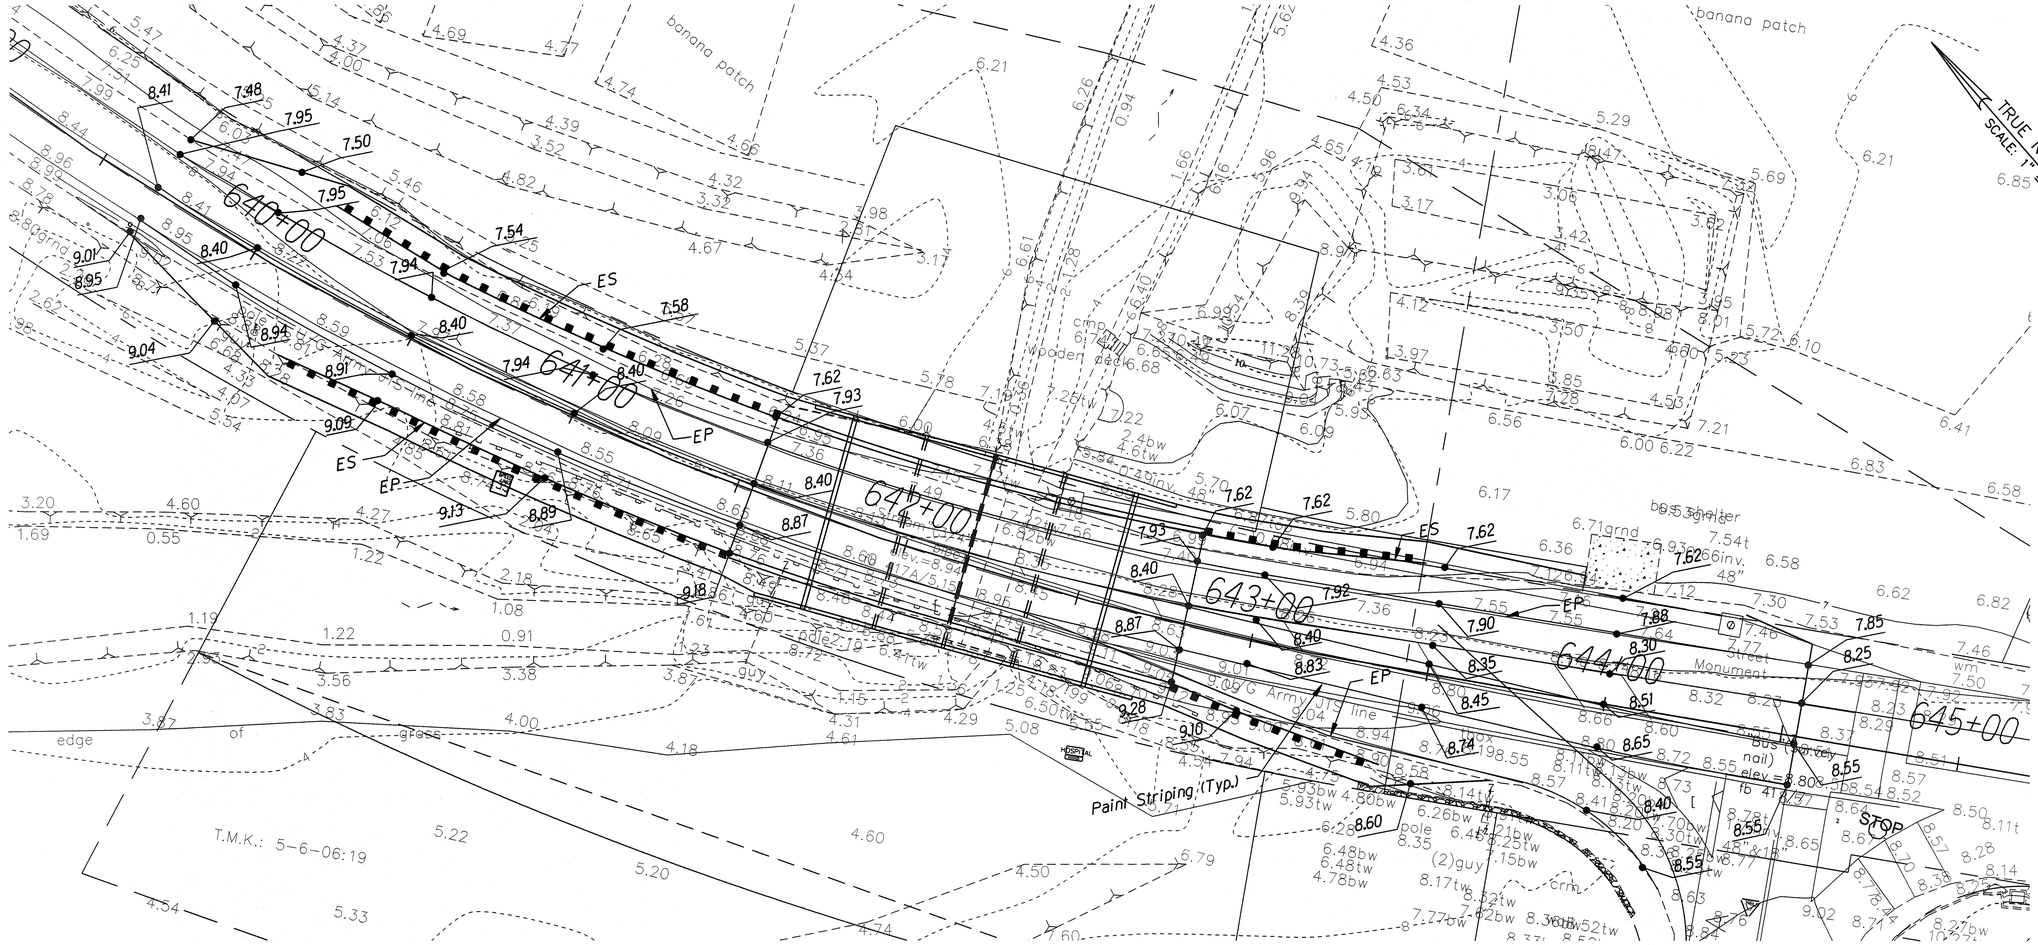

HOSPITAL CULVERT SUPERELEVATION PLAN

Scale: 1"=20'

Graphic Scale

1"=20' 20' 0 20' 40'

NOTES

1. Spot Elevations Shown At Even 50' Stations Or At End Of Pavement As Shown.
2. Spot Elevation Locations Based On Finished Paint Striping As Shown.
3. All Kamehameha Highway Stationing Shown on this Sheet is Off by 3.23'. To Obtain Current D.O.T. Highways Stationing, Subtract 3.23' from any Station Shown.

ORIGINAL PLAN
NOTE BOOK
SURVEY PLOTTED BY
DRAWN BY
TRACED BY
DESIGNED BY
QUANTITIES BY
CHECKED BY
DATE

NEAL S. FUKUMOTO
LICENSED PROFESSIONAL ENGINEER
No. 6186-C
HAWAII U.S.A.

This work was prepared by me or under my supervision.
Exp. 04-30-10

Wesley R. Segawa & Associates, Inc.

STATE OF HAWAI'I
DEPARTMENT OF TRANSPORTATION
HIGHWAYS DIVISION

HOSPITAL CULVERT SUPERELEVATION PLAN

KAMEHAMEHA HIGHWAY DRAINAGE IMPROVEMENTS
Vicinity of Kahuku Hospital and Replacement of Kii Bridge
Federal Aid Project No. NH-083-1(46)

Scale: 1" = 20' Date: April 2004

SHEET No. 1 OF 1 SHEETS

AS-BUILT