STATE	PROJECT	SHEET NO.
HI	HI STP SR 83(1) & (2)	A7

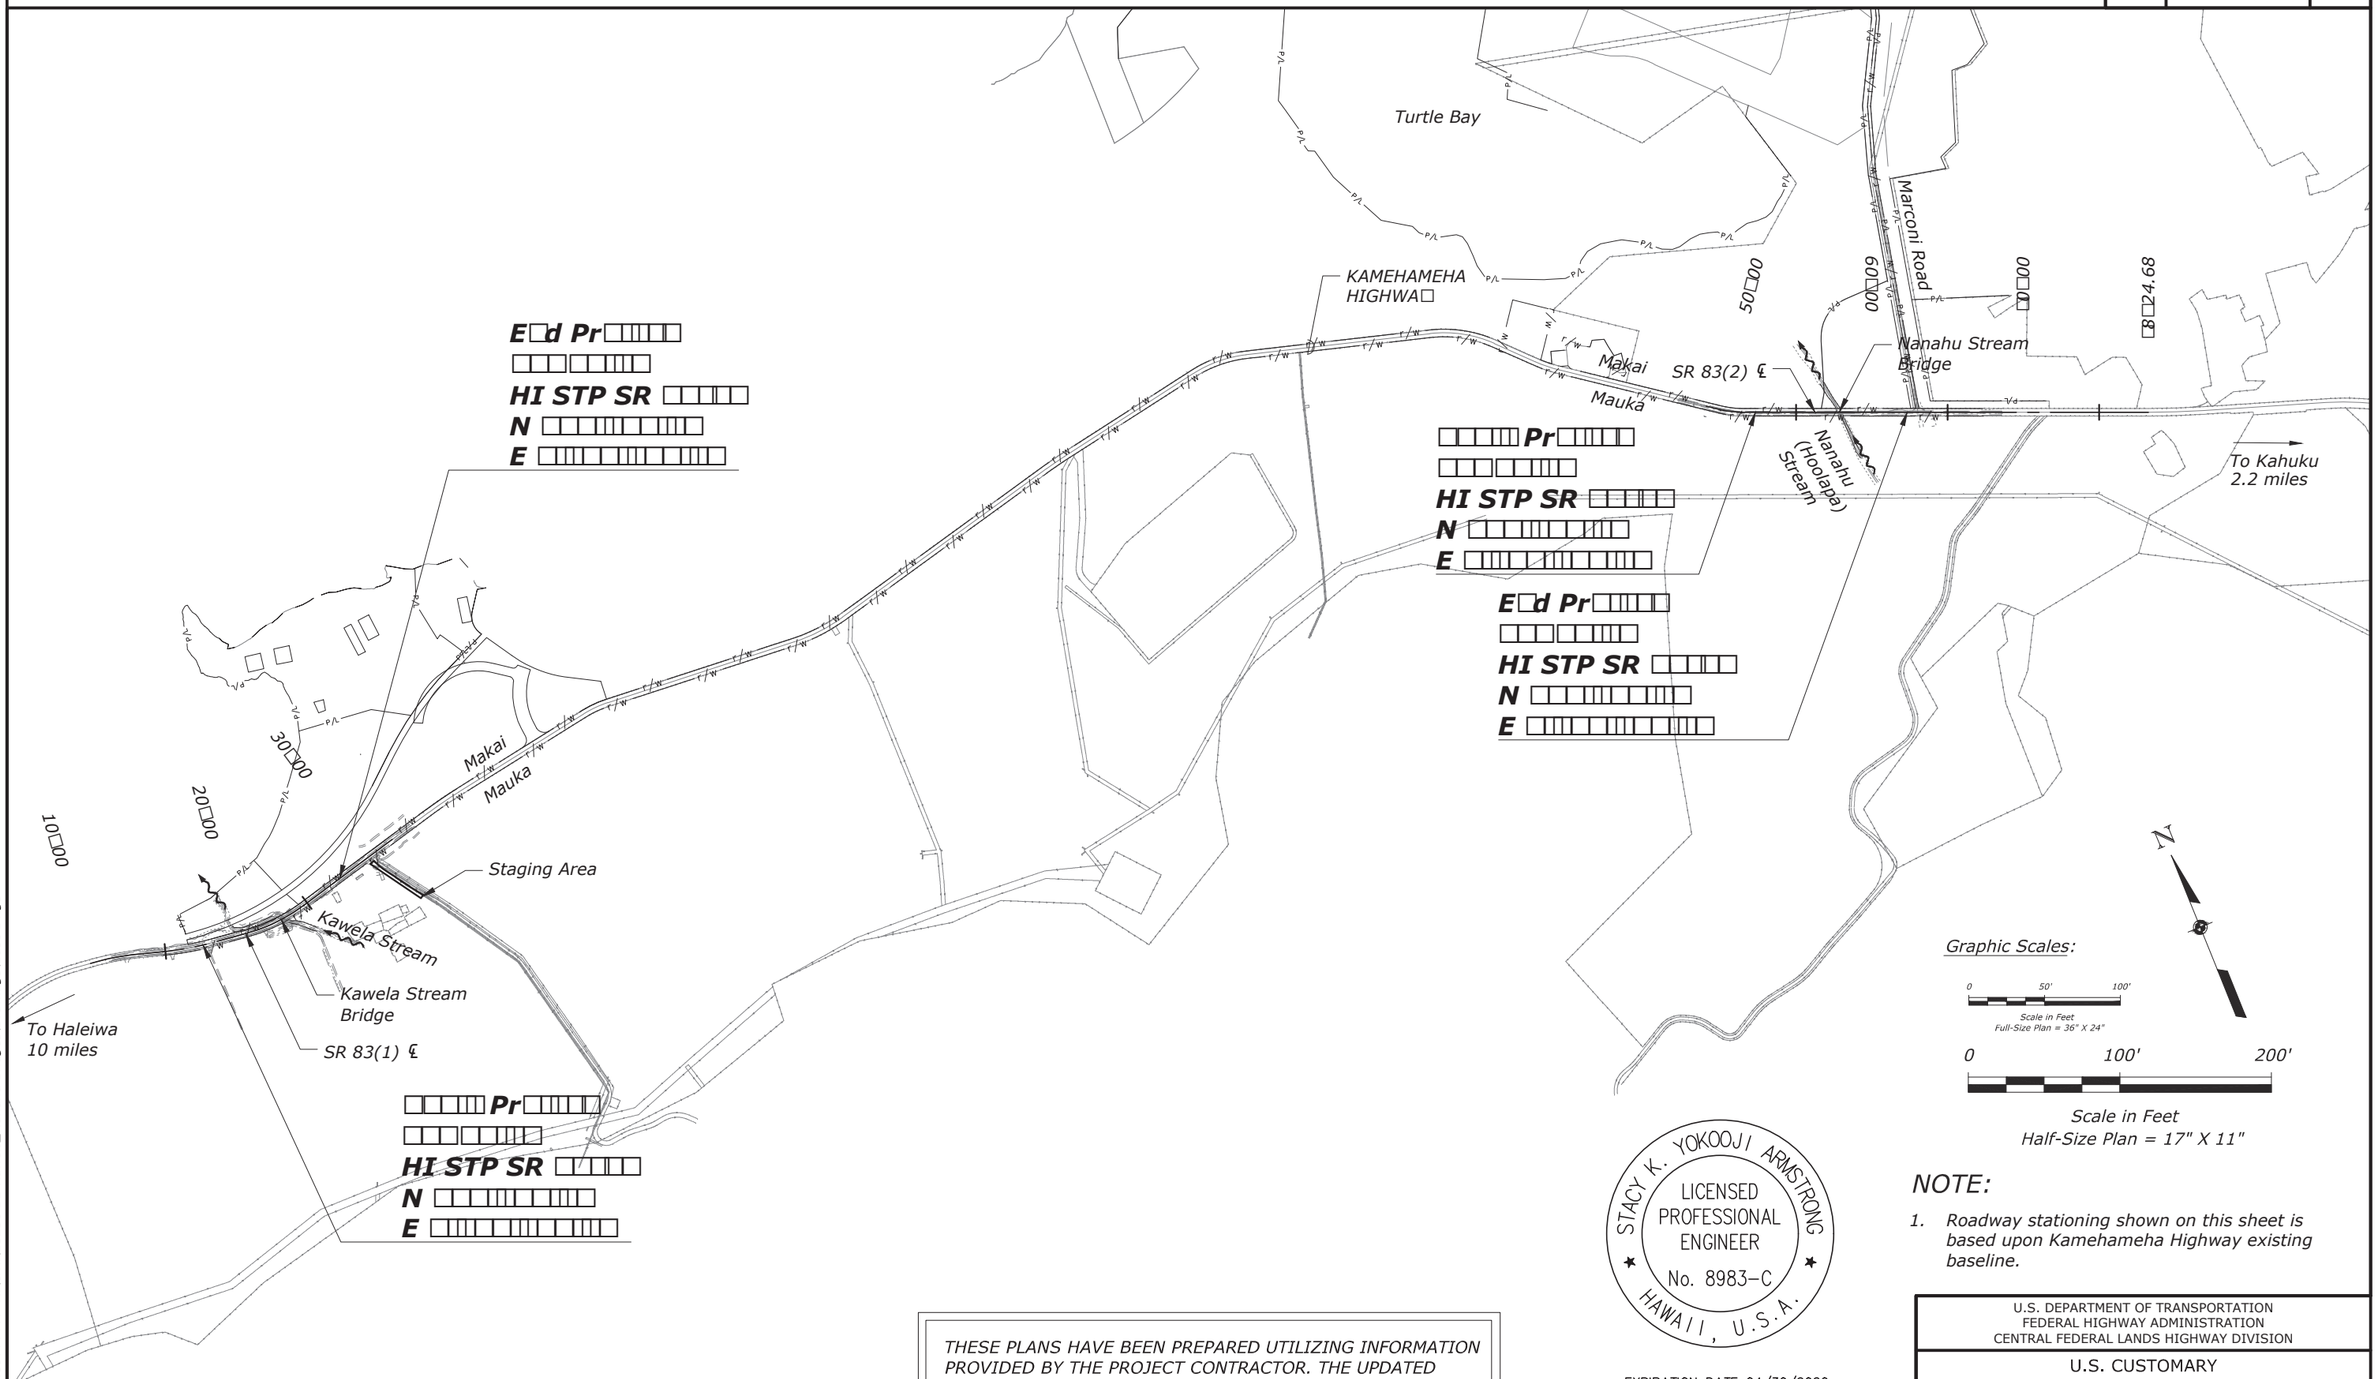

THESE PLANS HAVE BEEN PREPARED UTILIZING INFORMATION PROVIDED BY THE PROJECT CONTRACTOR. THE UPDATED CONSTRUCTION INFORMATION DEPICTED HEREIN HAS NOT BEEN VERIFIED FOR ACCURACY AND COMPLETENESS. NO REPRESENTATION IS BEING MADE TO ITS VALIDITY.

STACY K. YOKOOJI ARMSTRONG
LICENSED PROFESSIONAL ENGINEER
No. 8983-C
HAWAII, U.S.A.

EXPIRATION DATE 04/30/2020

THIS WORK WAS PREPARED BY ME OR UNDER MY SUPERVISION AND CONSTRUCTION OF THIS PROJECT WILL BE UNDER MY OBSERVATION.

NOTE:

1. *Roadway stationing shown on this sheet is based upon Kamehameha Highway existing baseline.*

U.S. DEPARTMENT OF TRANSPORTATION
FEDERAL HIGHWAY ADMINISTRATION
CENTRAL FEDERAL LANDS HIGHWAY DIVISION

U.S. CUSTOMARY

SITE PLAN

AS-BUILT DRAWINGS

5:59:44 PM K:\civil\23256 DB Kawela_Nanahu Bridges\Drawings\Base Dwgs