FED. ROAD DIST. NO.	STATE	FED. AID PROJ. NO.	FISCAL YEAR	SHEET NO.	TOTAL SHEETS
HAWAII	HAW	SN-A-F44(4)	1948	1	49

TERRITORY OF HAWAII
TERRITORIAL HIGHWAY DEPARTMENT
HONOLULU, OAHU, T. H.

PLANS OF

HONOLULU PEARL HARBOR ROAD
KAPALAMA SECTION

FEDERAL AID PROJECT NO. SN-A-F 44(4)

DISTRICT OF HONOLULU

ISLAND OF OAHU

INDEX TO DRAWINGS

SHEET NO.	DESCRIPTION
1	Title Sheet
2	Typical Section
3-5	Plan & Profile
6-8	Plan & Profile - Water System, Conduits, Etc.
9-12	Intersection Plans
13	Railroad Crossings
14-18	Standard Details-No. 1-No. 5 Incl.
19	Standard Details-Water Main
20	Relocating Water Main
21	Relocating Fire Hydrants
22	Manholes, Storm Drains, Etc.
23	Box Culverts
24	Relocating Oil Lines
25	Adjusting Oil & Water Valves
26	Standard Bridge Details
27-32	Bridge Details
33-45	Kapalama Relief Sewer
46-49	Cross Sections

CONVENTIONAL SIGNS

Centerline
Boundary Lines
Fences (Named)
Existing Roadways
Circular Culvert
Box Culvert
Bridge
Telephone Pole
Electric Power Pole
Water Main (W4, 8, 12, Etc.)
Storm Drain (SD18, 24, Etc.)
Concrete Drop Intake
Standard Catch Basin
Standard Manhole
Sewer Manhole
Telephone Manhole
Fire Hydrant
Tree (Large, named) Mango Coco
Railroad

SCALE

PLAN		1 INCH = 50 FEET
PROFILE	HOR.	1 INCH = 50 FEET
	VERT.	1 INCH = 5 FEET
CROSS SECTIONS	HOR.	1 INCH = 10 FEET
	VERT.	1 INCH = 5 FEET

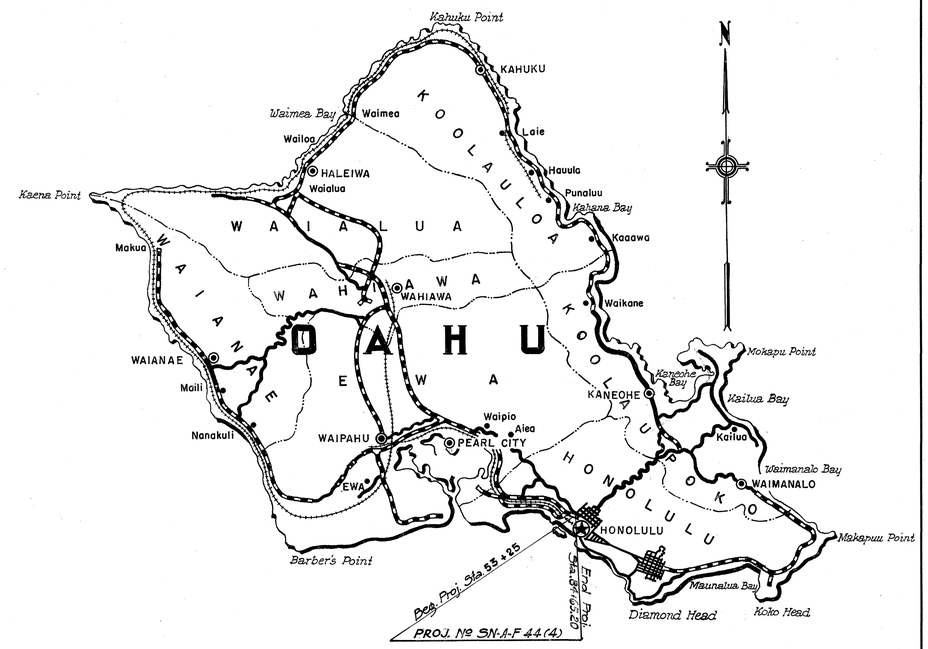

Federal Aid Projects Previously Constructed Or Under Construction

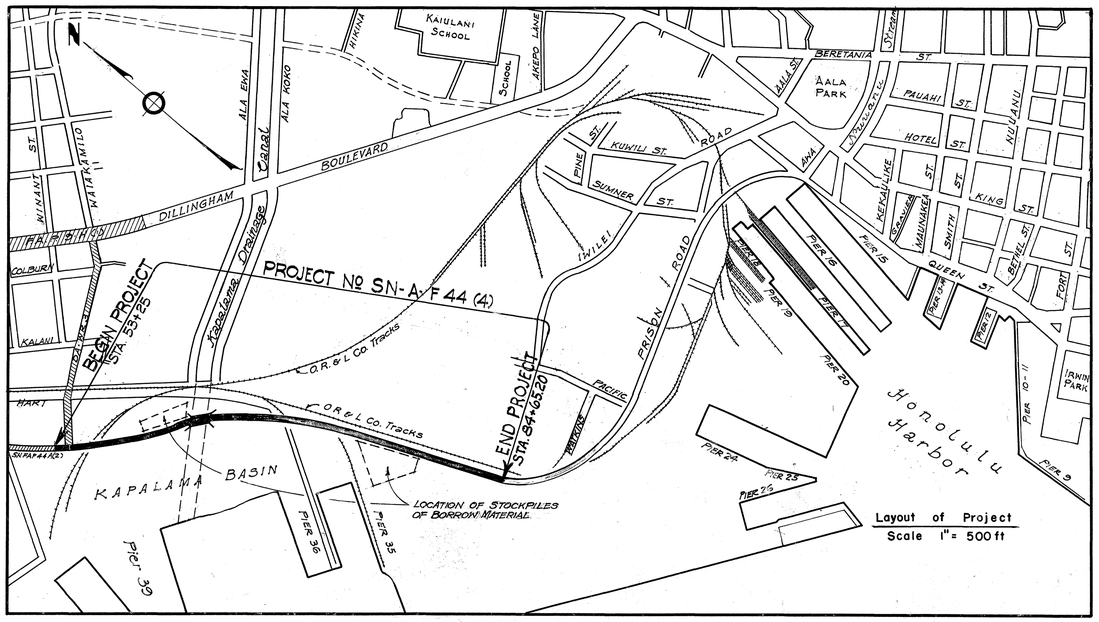

Gross Length of Project	------	0.595 Mi.
Bridges over 20 ft. Span	------	0.027 "
Net Length of Roadway	------	0.568 "

Note: All changes made during construction have been noted in red on these tracings and checked by
Melvin E. Lepine
Resident Engineer
Date Jan 27, 1950

APPROVED DATE 8-15-47
TERRITORIAL HIGHWAY ENGINEER

APPROVED DATE 4-22-47
B. F. Rush
TERRITORIAL HIGHWAY ENGINEER

RECOMMENDED FOR APPROVAL DATE
DISTRICT ENGINEER
PUBLIC ROADS ADMINISTRATION
FEDERAL WORKS AGENCY

APPROVED DATE
DIVISION ENGINEER
PUBLIC ROADS ADMINISTRATION
FEDERAL WORKS AGENCY

ORIGINAL PLAN		DATE
	SURVEY PLOTTED BY	
	DESIGNED BY	"
	DRAWN BY	"
	TRACED BY	"
NOTE BOOK	QUANTITIES BY	"
	QUANTITIES CHECKED BY	"
No.	CHECKED BY	"

5242.1

K & E CO., N.Y. PERMALT TRACING CLOTH PRINTED ON

DP-J