FED. ROAD DIST. NO.	STATE	FED. AID PROJ. NO.	FISCAL YEAR	SHEET NO.	TOTAL SHEETS
HAWAII	HAW	FU 44 (5) UNIT I	1950	1	41

TERRITORY OF HAWAII
TERRITORIAL HIGHWAY DEPARTMENT
HONOLULU, OAHU, T. H.

PLANS OF

HONOLULU PEARL HARBOR ROAD QUEEN STREET SECTION

FEDERAL AID URBAN PROJECT NO FU 44(5) UNIT I

DISTRICT OF HONOLULU
ISLAND OF OAHU

ALTERATIONS & ADDITIONS TO EXISTING BUILDINGS

	SHEET NO.		INDEX TO DRAWINGS
PIER 11	1	1	TITLE SHEET
	2	2	PLAN OF EXISTING FOOTINGS
	3	3	GENERAL PLOT PLAN SHOWING UTILITIES
	4	4	" PLAN SHOWING EXISTING WORK 2ND FLOOR
	5	5	" " " " ROOF
	6	6	ARCHITECTURAL PLANS - 1ST & 2ND FLOORS
	7	7	" " 3RD FL. & ROOF
	8	8	ELEVATIONS & SECTIONS
	9	9	DOOR & WINDOW SCHEDULE & DETAILS
	10	10	SECTIONS & DETAILS
	11	11	" "
	12	12	" "
	13	13	CONNECTION BETWEEN OLD & NEW WORK FORT ST. SIDE
	14	14	CONNECTION BETWEEN OLD & NEW WORK GALLERY SIDE
	15	15	CONNECTION BETWEEN OLD & NEW WORK
	16	16	LOBBY & SHOW WINDOW DETAILS
	17	17	VAULT & MISCELLANEOUS DETAILS
	18	18	FOUNDATION & SECOND FLOOR FRAMING PLANS
	19	19	THIRD FLOOR & ROOF FRAMING PLANS
	20	20	BEAM & COLUMN SCHEDULE - DETAILS
	21	21	PLUMBING PLANS - FIRST & SECOND FLOORS
	22	22	" " THIRD FLOOR & ROOF
	23	23	ELECTRICAL PLANS - FIRST & SECOND FLOORS
	24	24	" " THIRD FLOOR & ROOF
PIER 12	25	1	FLOOR PLANS & DETAILS
	26	2	ELEVATIONS & SECTIONS
	27	3	DETAILS & ELECTRICAL LAYOUT, ETC.
PIERS 13 & 14	28	1	PLOT PLAN
	29	2	FLOOR PLANS - SCHEDULES - DETAILS
	30	3	ROOF PLAN - ELEVATIONS - SECTIONS
	31	4	BEAM SCHEDULE - DETAILS
	32	5	COLUMN DETAILS - SECTIONS - DETAILS
	33	6	PLUMBING LAYOUT - DETAILS
	34	7	ELECTRICAL LAYOUT - DETAILS
SPERRY BLDG.	35	1	PLANS & ELEVATIONS
	36	2	DETAILS
ESQ. BLDG.	37	1	PLANS
	38	2	DETAILS
SEWER WORK	39	1	UTILITIES (SEWERS)
	40-41	1 & 2	STANDARD DETAILS (SEWERS)

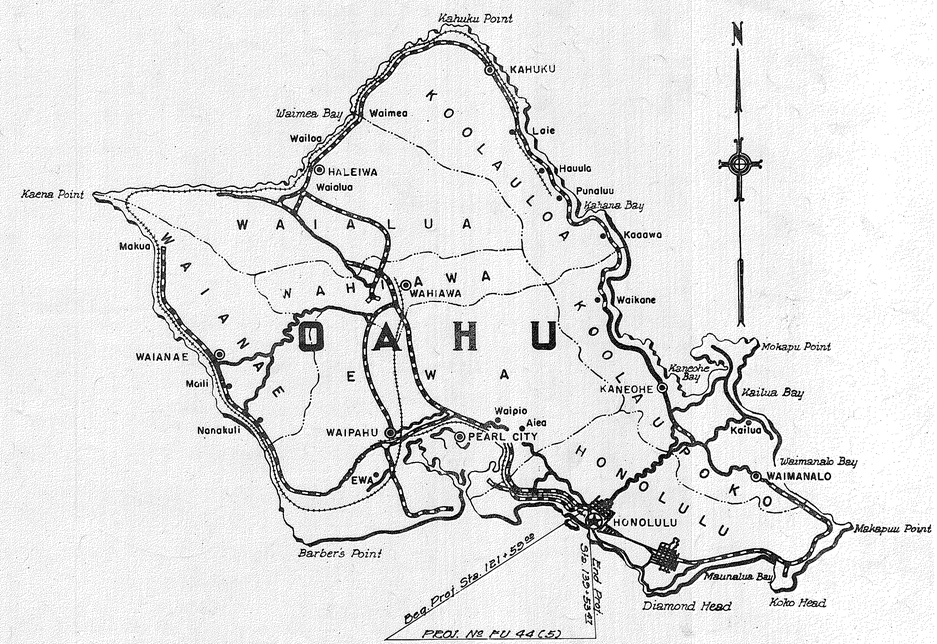

Federal Aid Projects Previously Constructed Or Under Construction

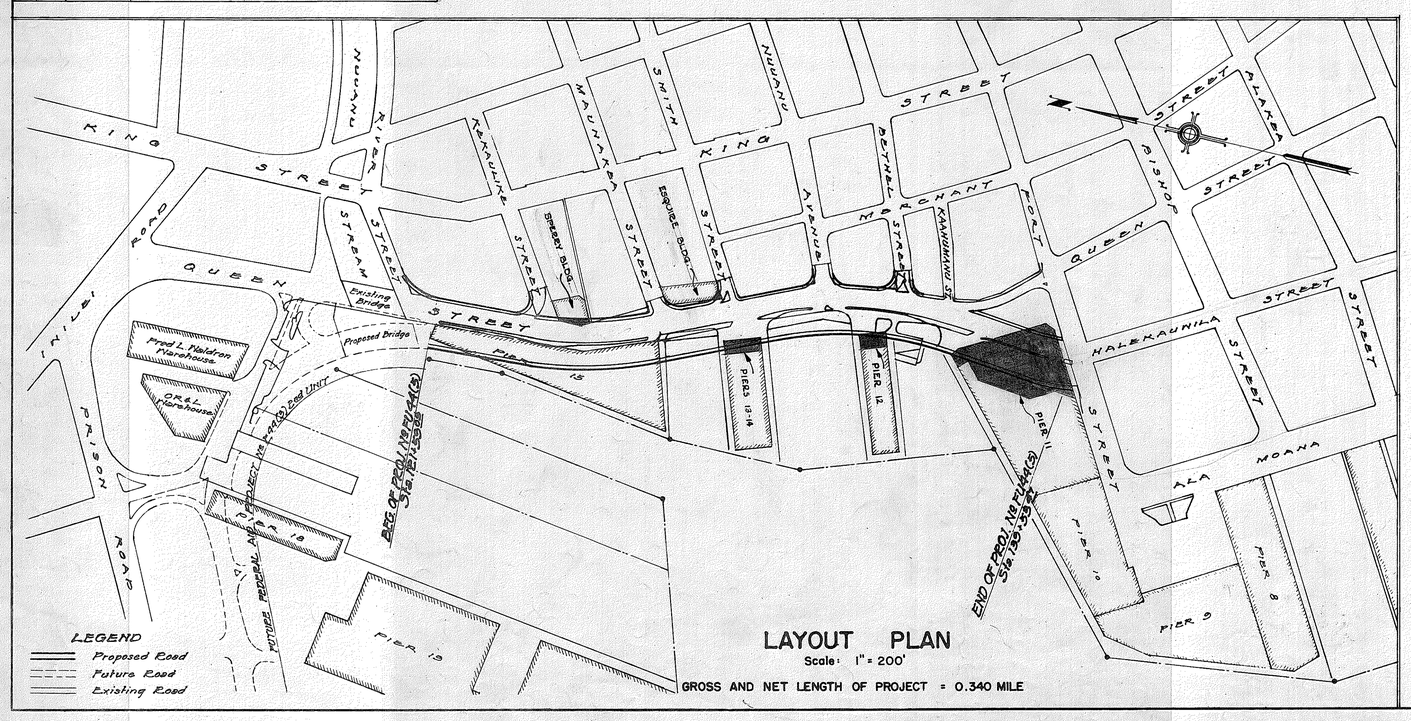

LAYOUT PLAN
Scale: 1" = 200'
GROSS AND NET LENGTH OF PROJECT = 0.340 MILE

NOTE:
ALL CHANGES DURING THE CONSTRUCTION ARE SHOWN ON THE REVISED SHEETS:

F. C. Pruitt, Section Engineer
SECTION ENGINEER

5/11/53
DATE

PLANS BY

G. F. WAGNER
REGISTERED ARCHITECT
No. 555
HAWAII, U.S.A.

JUNE 1950

APPROVED DATE July 24, 1950

TERRITORIAL HIGHWAY ENGINEER

DEPARTMENT OF COMMERCE
BUREAU OF PUBLIC ROADS

RECOMMENDED FOR APPROVAL:

DISTRICT ENGINEER — DATE

APPROVED:

DIVISION ENGINEER — DATE

ORIGINAL PLAN	SURVEY PLOTTED BY	DATE
	TRACED BY	"
	DRAWN BY	"
NOTE BOOK	TRACED BY	"
	QUANTITIES BY	"
	QUANTITIES CHECKED BY	"
No.	CHECKED BY	"

549S.1