FED. ROAD DIST. NO.	STATE	FED. AID PROJ. NO.	FISCAL YEAR	SHEET NO.	TOTAL SHEETS
HAWAII	HAW	FU 44(3)	1950	71	114

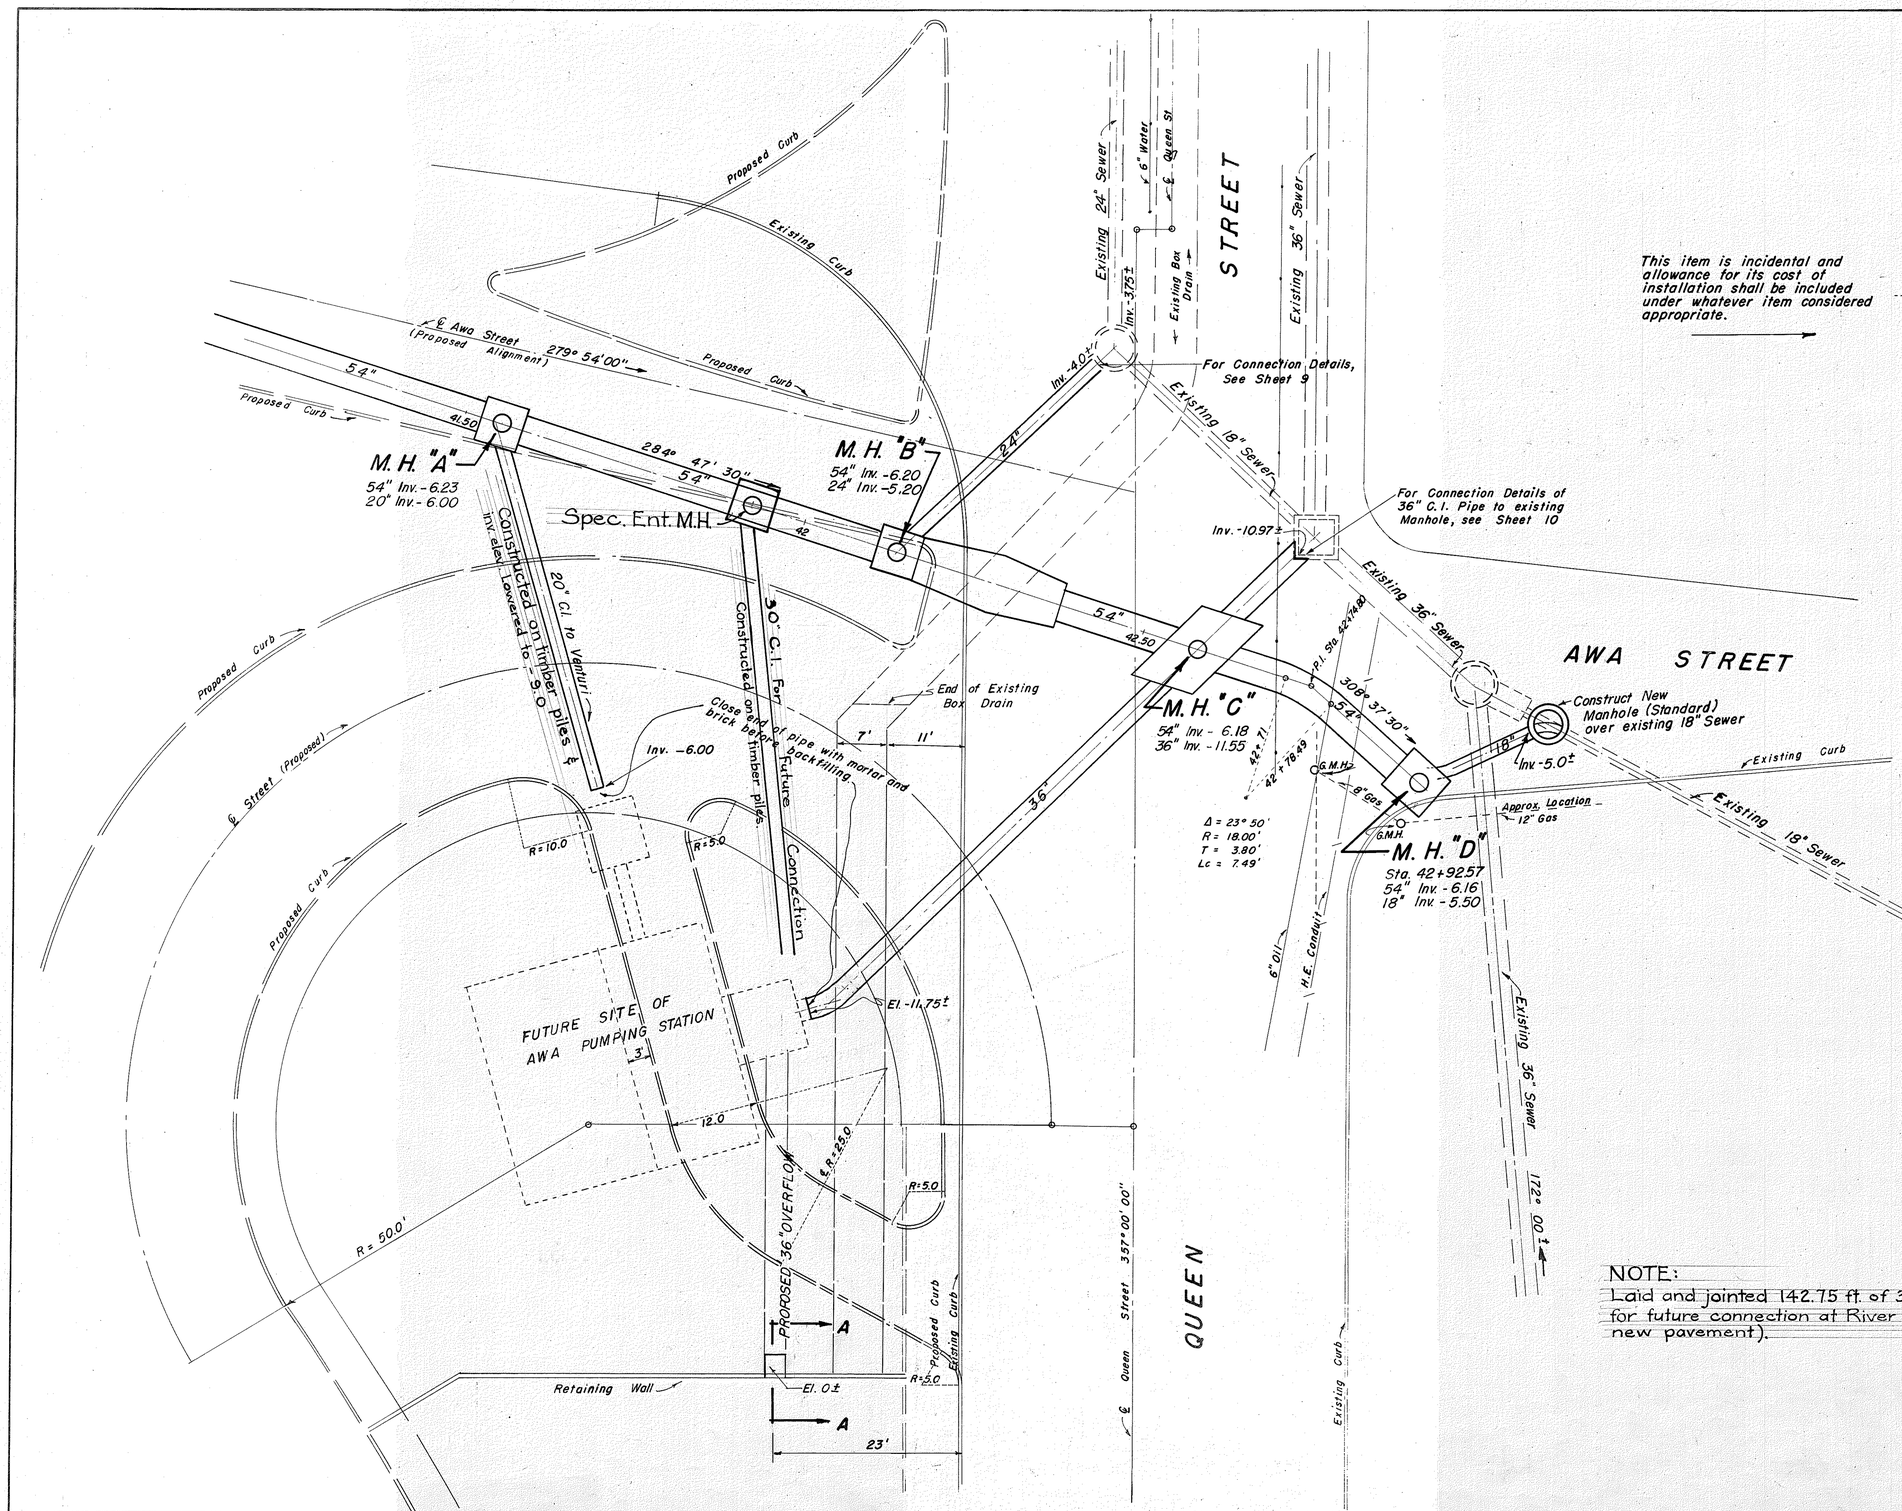

NOTE:
Laid and jointed 142.75 ft. of 30" C.I. pipe for future connection at River St. (under new pavement).

NOTE:
THESE PLANS WERE PREPARED IN THE OFFICE OF DEPARTMENT OF PUBLIC WORKS, CITY & COUNTY OF HONOLULU.

JOB #28-50

TERRITORIAL HIGHWAY DEPARTMENT
TERRITORY OF HAWAII
LOCATION PLAN FOR SPEC. MANHOLES
KAPALAMA RELIEF SEWER
SECTION #3
PACIFIC STREET TO
AWA STREET PUMPING STATION
HONOLULU-PEARL HARBOR ROAD
PROJECT No. FU44(3) 2ND UNIT
SEPTEMBER 1950

ENGINEER H. Finlay
DRAFTSMAN C.D. Ahn
SCALE 1" = 10'
DATE 8-31-50
CHECKED BY C.D. Ahn
TRACER A. Barker

APPROVED: H. Hansen, CHIEF ENGINEER
APPROVED: R. Wallace, DIVISION ENGINEER

5484.71

SHEET 5 OF 14

FILE	POCKET	FOLDER	NO
6	13	2	5