

FED. ROAD DIST. NO.	STATE	FED. AID PROJ. NO.	FISCAL YEAR	SHEET NO.	TOTAL SHEETS
HAWAII	HAW.	U44(G)	1951	5	44


NOTE:

All existing Lava Rock Curb shall be salvaged and paid for under the item of salvaging existing curb. Approx. 2015 lin. ft.
 All MH shall be adjusted to finish grade.
 Where Catch Basins are to be constructed in Median Strips or in Traffic Islands, the face of Conc. Curbs adjacent to the Catch Basins shall have transition of not less than 10 ft.
 Removal of existing Storm Drain Manholes and existing Concrete Catch Basins are incidental to the item of Unclassified Excavation. The existing gratings shall be salvaged.

USA, WAR DEPARTMENT-WHSE.

NOTE: For Construction Detail See Shts. No. 5505.7 to 5505.9 incl.
 For Profile of Drainage System See Sht. No. 5505.17

NOTE:
 Where New Concrete Sidewalk Replaces Existing Sidewalk, the Existing Sidewalk shall be removed and the area prepared for the New Sidewalk as provided in the Specifications.

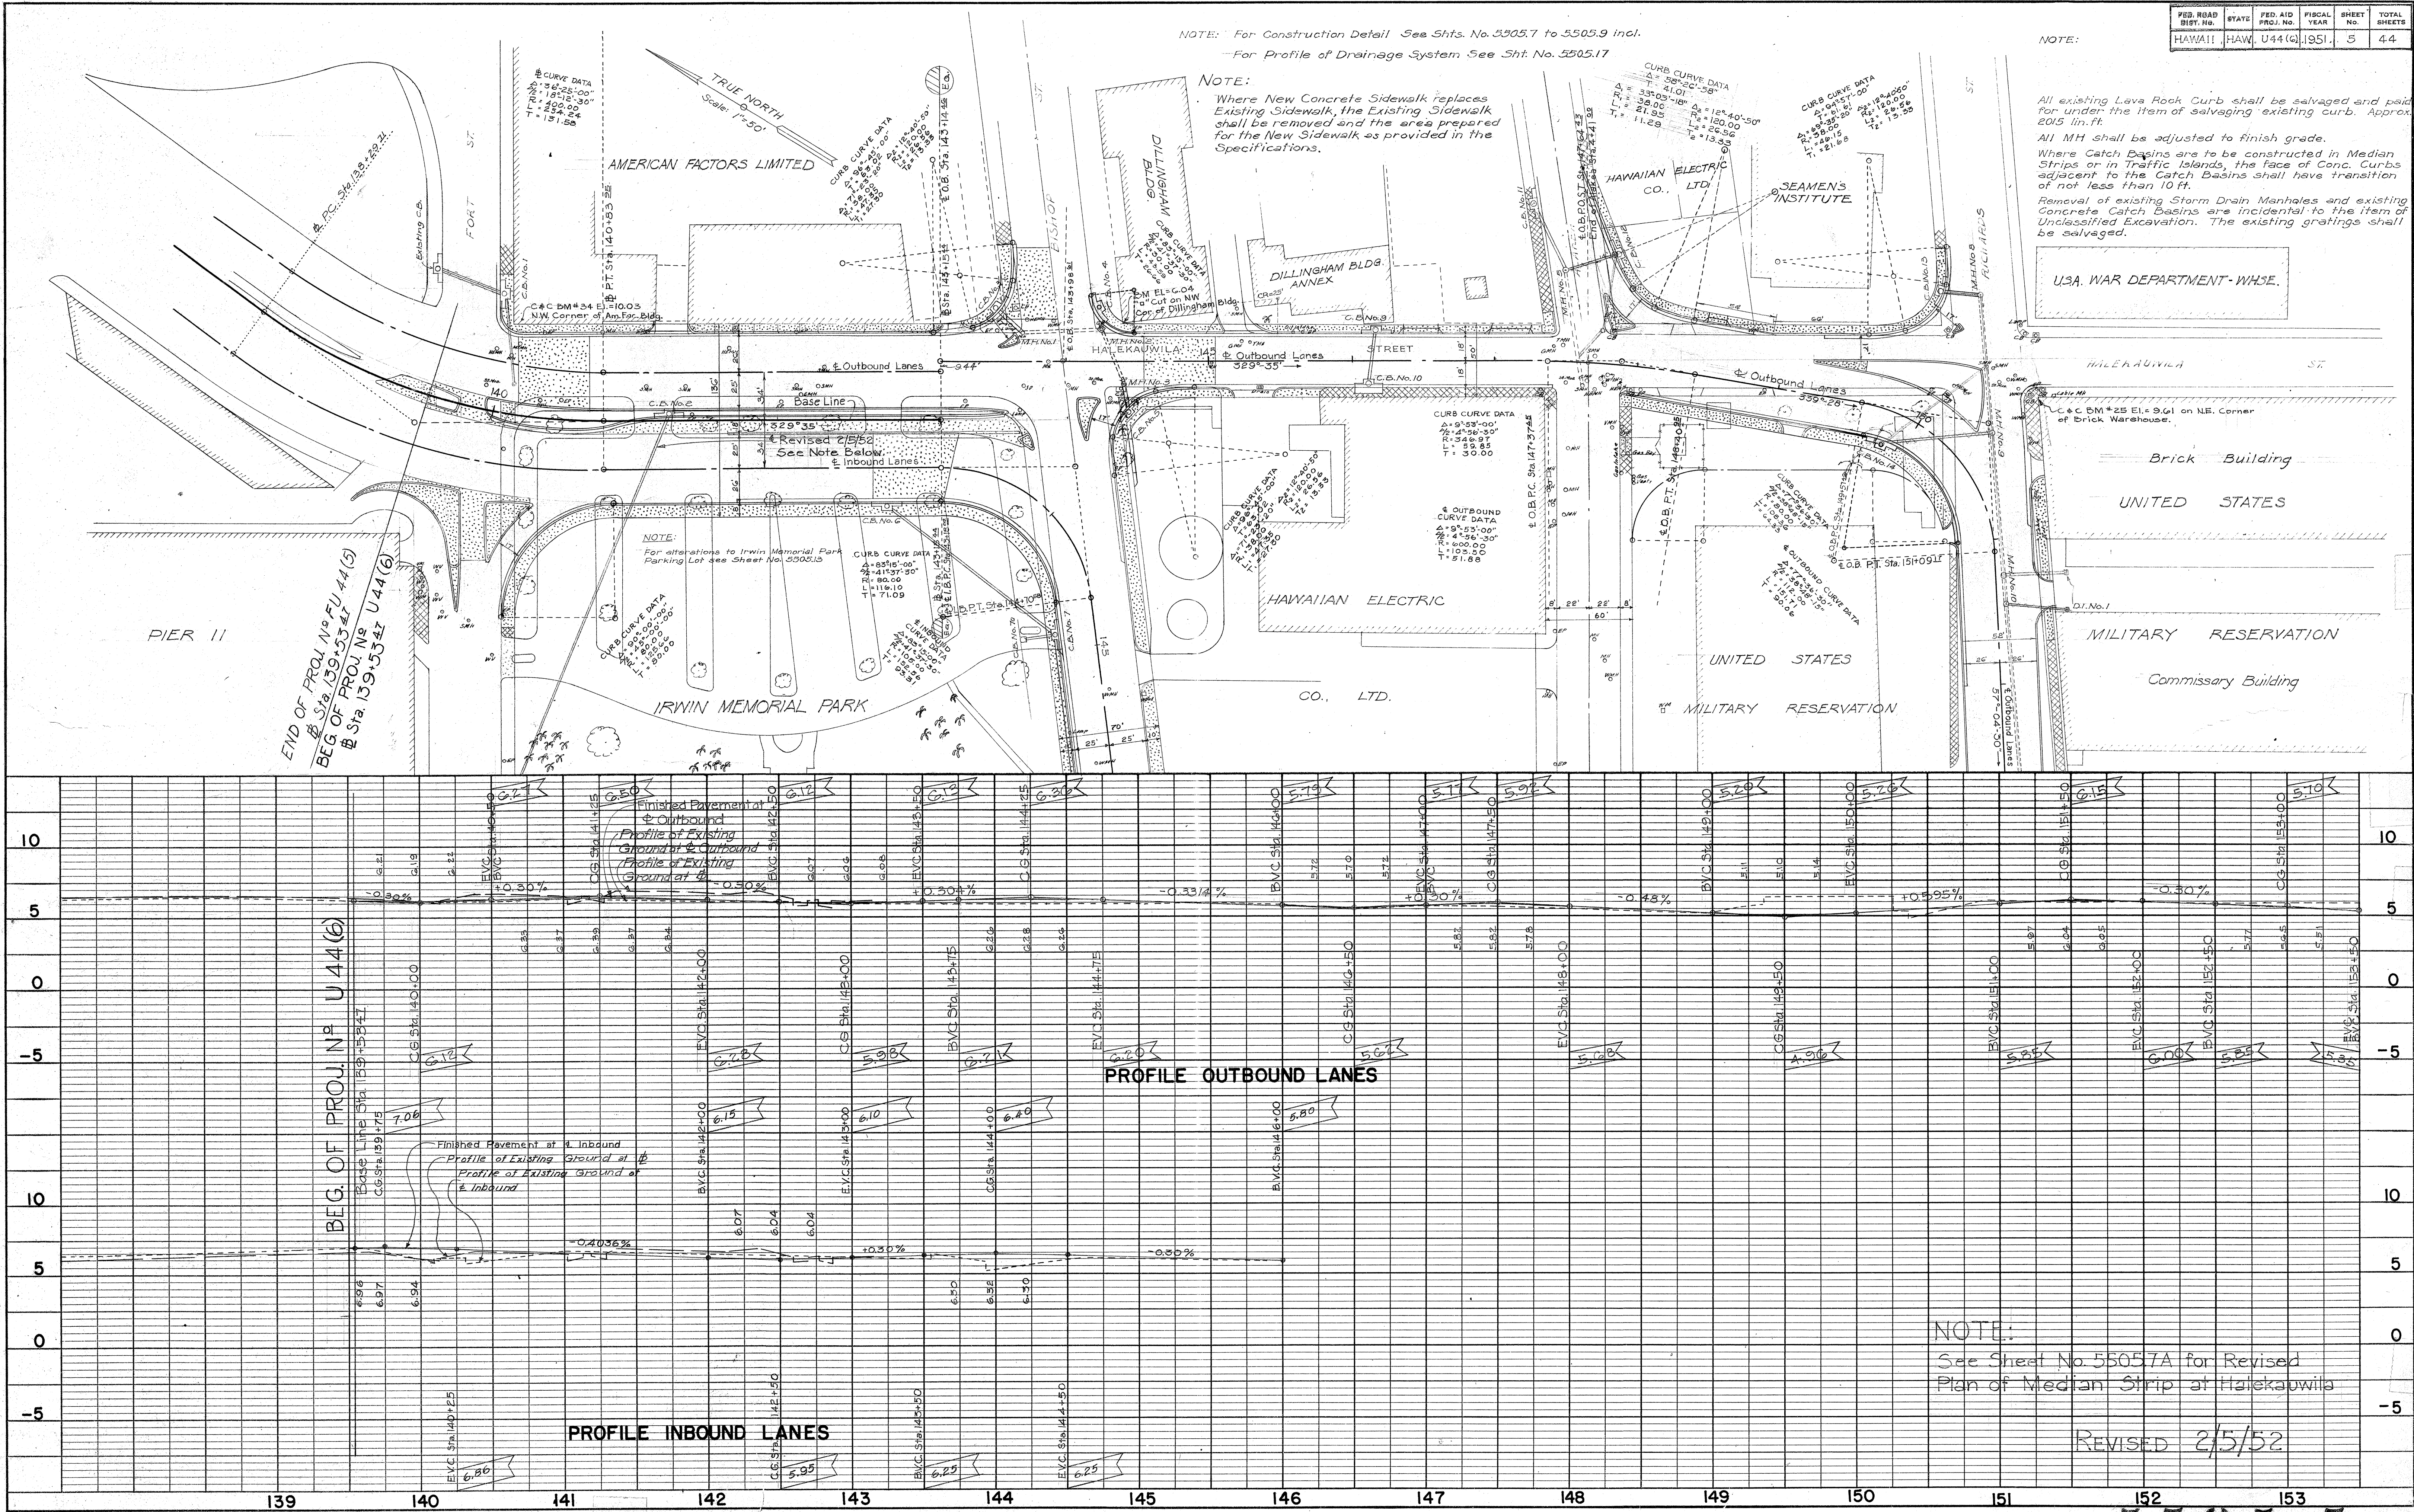

NOTE:
 See Sheet No. 5505.7A for Revised Plan of Median Strip at Halekapuila

REVISED 2/5/52

5505.5

FED. ROAD DIST. NO.	STATE	FED. AID PROJ. NO.	FISCAL YEAR	SHEET NO.	TOTAL SHEETS
HAWAII	HAW	U44(6)	1951	6	44

PLAN	SURVEYED	BY	DATE
NOTE BOOK	PLOTTED		
NO.	ALIGNMENT CHECKED		
	BY		

PROFILE	SURVEYED	BY	DATE
NOTE BOOK	PLOTTED		
NO.	ALIGNMENT CHECKED		
	BY		

