FED. ROAD DIST. NO.	STATE	FED. AID PROJ. NO.	FISCAL YEAR	SHEET NO.	TOTAL SHEETS
HAWAII	HAW.	EHS-U-092-1(11)	1974	1	141

Revised: 11/6/74

INDEX TO DRAWINGS

SHEET NO.	DESCRIPTION
1	TITLE SHEET
2-4	TYPICAL SECTIONS
5-6	PLAN AND PROFILE
7-13	DETAIL PLAN OF ROADWAY
14-15	RAMPS PROFILE
16-20	MISC. & ROADWAY STANDARD
21-33	DRAINAGE DETAILS
34-37	RETAINING WALLS NO.1 & NO.2
38-39	HECO WALL
40-42	PIER 4 REHAB. & MISC. DETAILS
43-48	LANDSCAPING, SPRINKLER SYSTEM
49-52	HWY. LIGHTING & FIREALARM SYSTEM
53-63	CONSTRUCTION PHASING & DETOURS
64-82	SIGNING AND PAVEMENT MARKINGS
83-85	TEMPORARY TRAFFIC SIGNALS SYSTEM
86-94	TRAFFIC SIGNALS SYSTEM
95-135	UTILITIES
136-141	CROSS-SECTIONS

STATE OF HAWAII

DEPARTMENT OF TRANSPORTATION
HIGHWAYS DIVISION

HONOLULU, HAWAII

"AS BUILT"

PLANS OF

NIMITZ HIGHWAY
BISHOP STREET TO PUNCHBOWL STREET

FEDERAL AID PROJECT NO. EHS-U-092-1(11)

DISTRICT OF HONOLULU
ISLAND OF OAHU

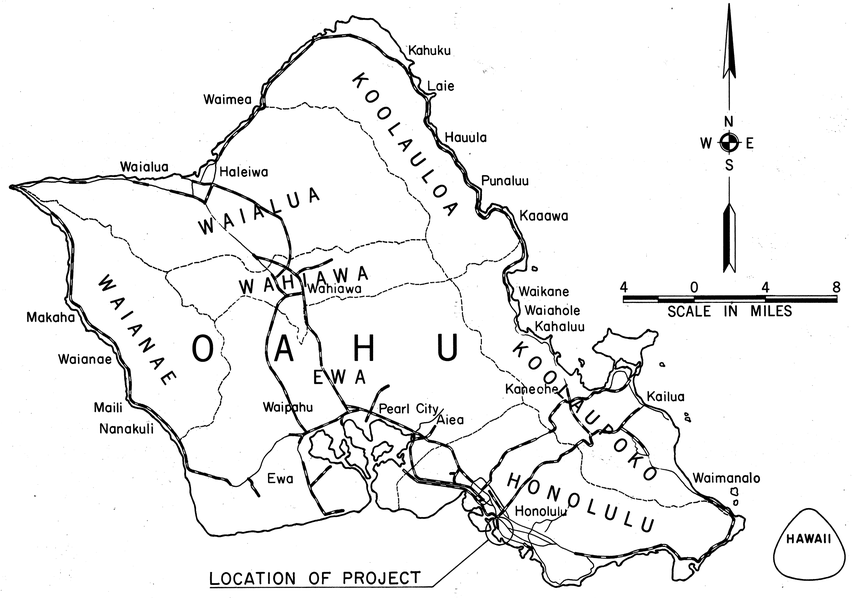

Federal Aid Projects Previously Constructed or Under Construction

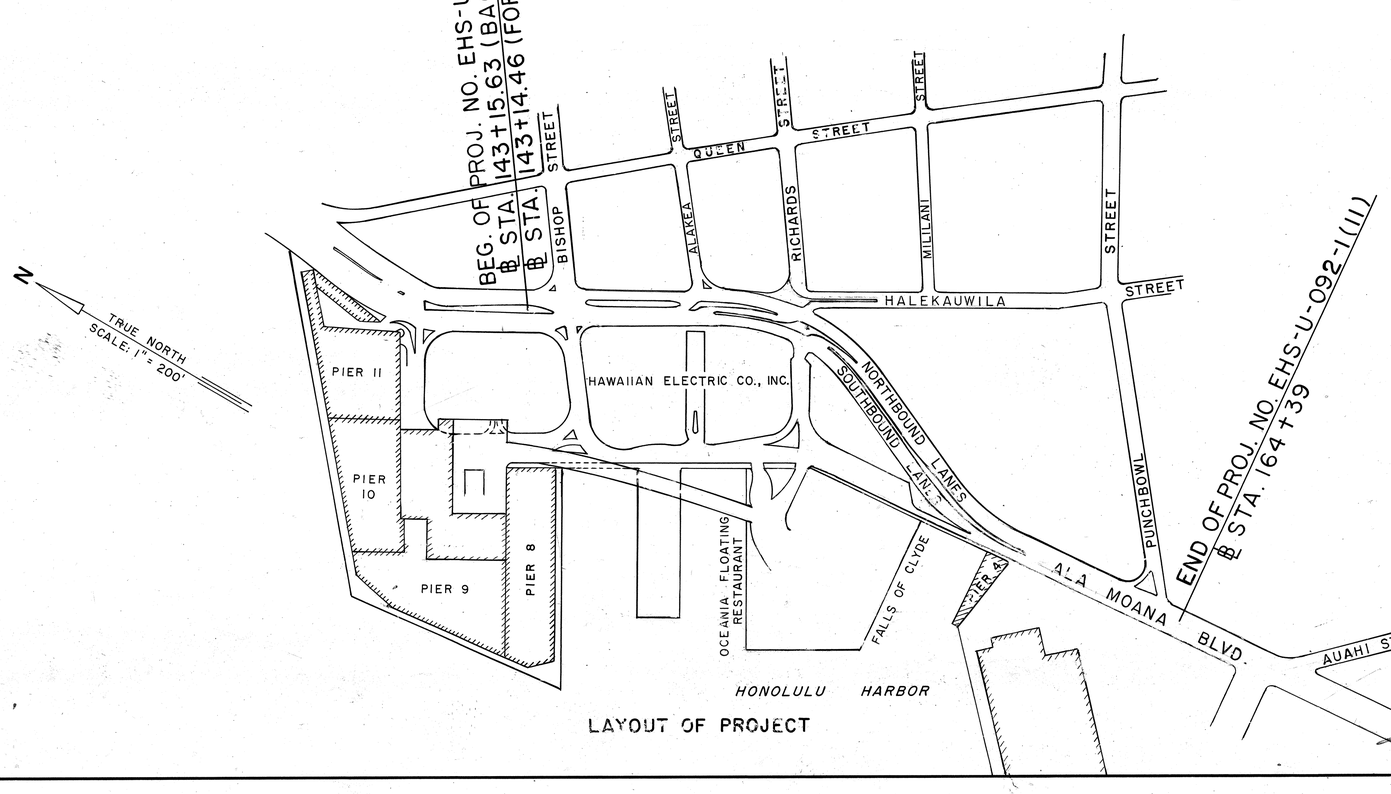

LAYOUT OF PROJECT

ALL CHANGES MADE DURING CONSTRUCTION HAVE BEEN INCORPORATED ON THESE PLANS EXCEPT CHANGES IN THE ORIGINAL THEORETICAL QUANTITIES.

Glenn Matsumoto — PROJECT ENGINEER — 2/12/80 DATE

DESIGN DATA

ADT(1973)	54,250
ADT(1993)(E)	57,490
DHV	5,460
K	9.5%
D	55/45
T	4.0%
V	35 MPH

DESIGNED BY: D. Bevier — P.S. & E. BY — PHONE: 548-7537 — DATE: May, 1974

DEPARTMENT OF TRANSPORTATION FEDERAL HIGHWAY ADMINISTRATION	
APPROVED:	
DIVISION ENGINEER	5.21.74 DATE

DEPARTMENT OF TRANSPORTATION STATE OF HAWAII	
APPROVED:	
FOR DIR. OF TRANSPORTATION	Mummy Lee 4/16/74 DATE

D-6-1