| FED. ROAD DIST. NO. | STATE | PROJ. NO. | FISCAL YEAR | SHEET NO. | TOTAL SHEETS |
|---|---|---|---|---|---|
| HAWAII | HAW. | 92A-01-78M | 1978 | 1 | 9 |

INDEX TO DRAWINGS

| SHEET NO. | DESCRIPTION |
|---|---|
| 1 | TITLE SHEET |
| 2 | GENERAL NOTES AND MISCELLANEOUS DETAILS |
| 3 | GENERAL NOTES, DETAIL AND ROADWAY PLAN |
| * 4-5 | ROADWAY PLANS |
| 6-9 | STANDARD DETAILS |

PLAN SHEET NOS. * CO 5S-1, CO 5S-2, CO 5S-3 & CO 5S-4 ARE SUPPLEMENTARY SHEETS TO THIS PROJECT.

TOTAL SHEET COUNT AFTER "AS-BUILT" POSTINGS: 13 SHEETS.

STATE OF HAWAII

# DEPARTMENT OF TRANSPORTATION

LAND TRANSPORTATION FACILITIES DIVISION

"AS BUILT"

PLANS FOR

RESURFACING A PORTION OF

# NIMITZ HIGHWAY

## SAND ISLAND ACCESS RD. TOWARDS FORT ST.

## PROJECT NO. 92A-01-78M

DISTRICT OF HONOLULU
ISLAND OF OAHU

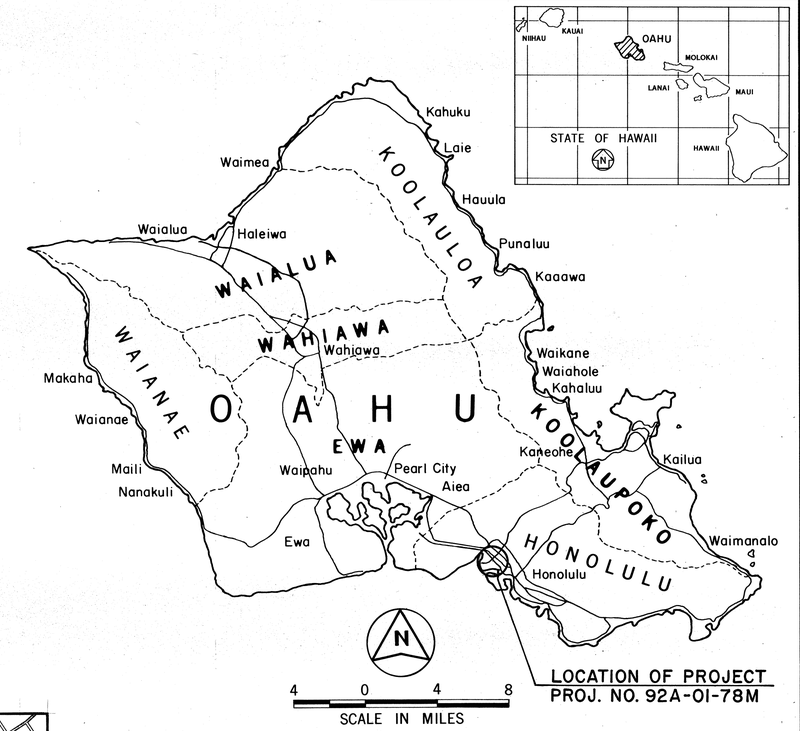


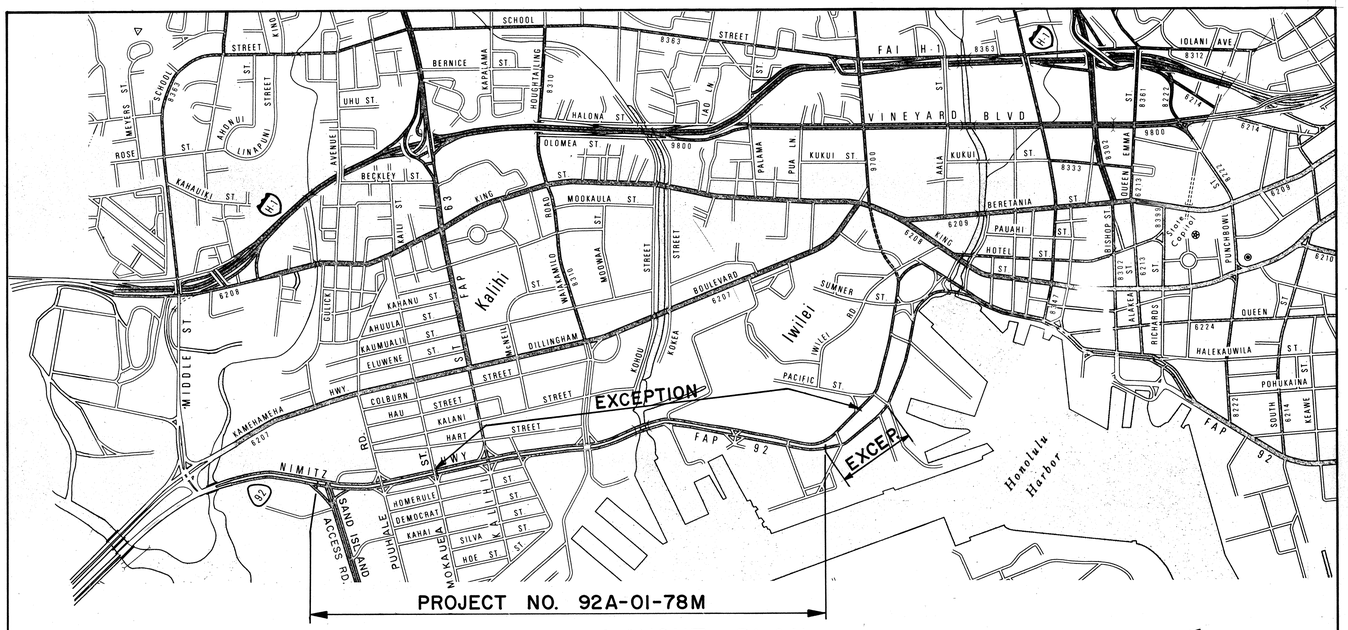


PROJECT NO. 92A-01-78M

## LAYOUT PLAN

LENGTH OF PROJECT..... 1.36 MILES

EXCEPTIONS: OUTBOUND LANES: MOKAUEA ST. TO PACIFIC ST.
INBOUND LANES: STA. 88+00 TO PACIFIC ST.

NOTE:

ALL CHANGES MADE DURING CONSTRUCTION HAVE BEEN INCORPORATED ON THESE PLANS IN RED EXCEPT CHANGES IN THE ORIGINAL THEORETICAL QUANTITIES. FOR ACTUAL QUANTITIES, REFER TO PROJECT LEDGER AND/OR COMPUTATION BOOK.

Albert T. Nishi — 5/6/80
RESIDENT ENGINEER — DATE

DEPARTMENT OF TRANSPORTATION
STATE OF HAWAII

APPROVED:

5/25/78
DIR. OF TRANSPORTATION — DATE

| | | | |
|---|---|---|---|
| Mike Miura | Mike Miura | 548-7490 | May, 1978 |
| DESIGNED BY | P. S. & E. BY | PHONE | DATE |

DD-8-7-8