FED. ROAD DIST. NO.	STATE	PROJ. NO.	FISCAL YEAR	SHEET NO.	TOTAL SHEETS
HAWAII	HAW.	92A-01-11M	2011	ADD.30	42

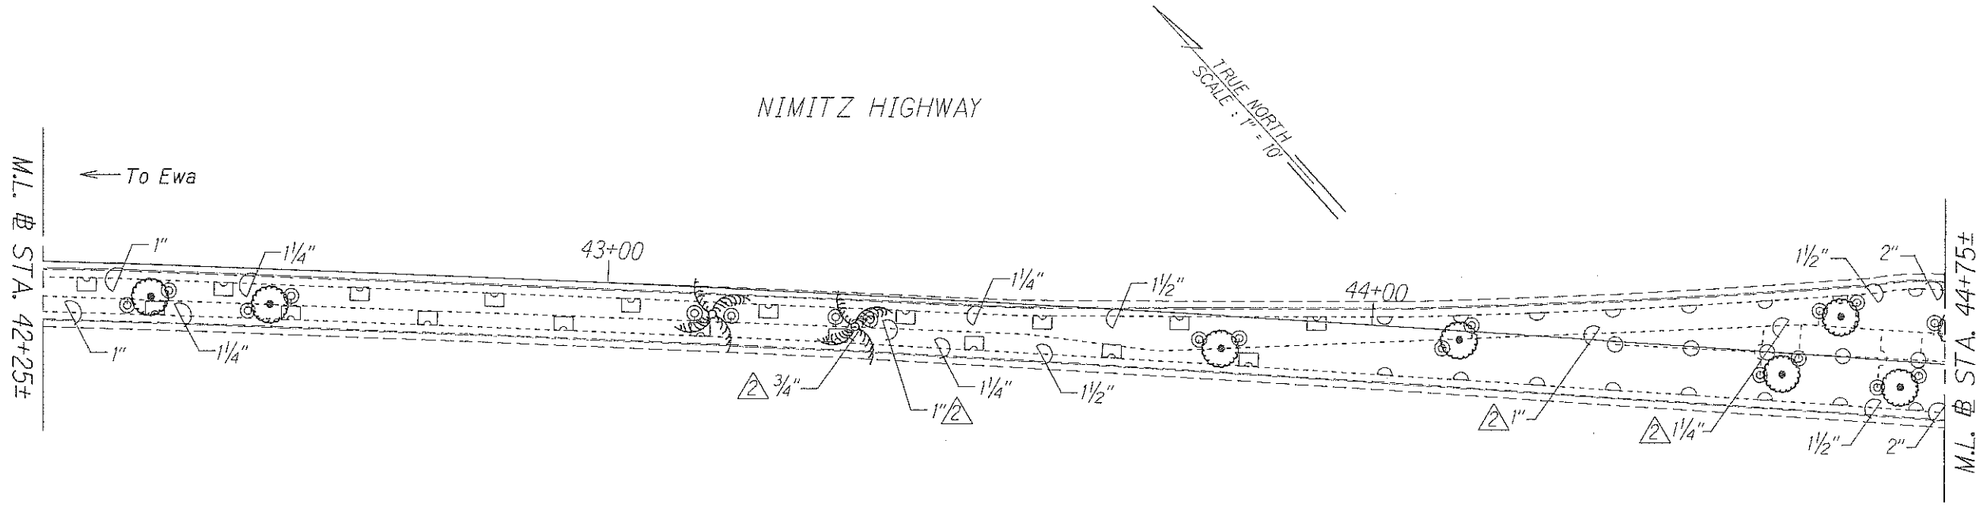

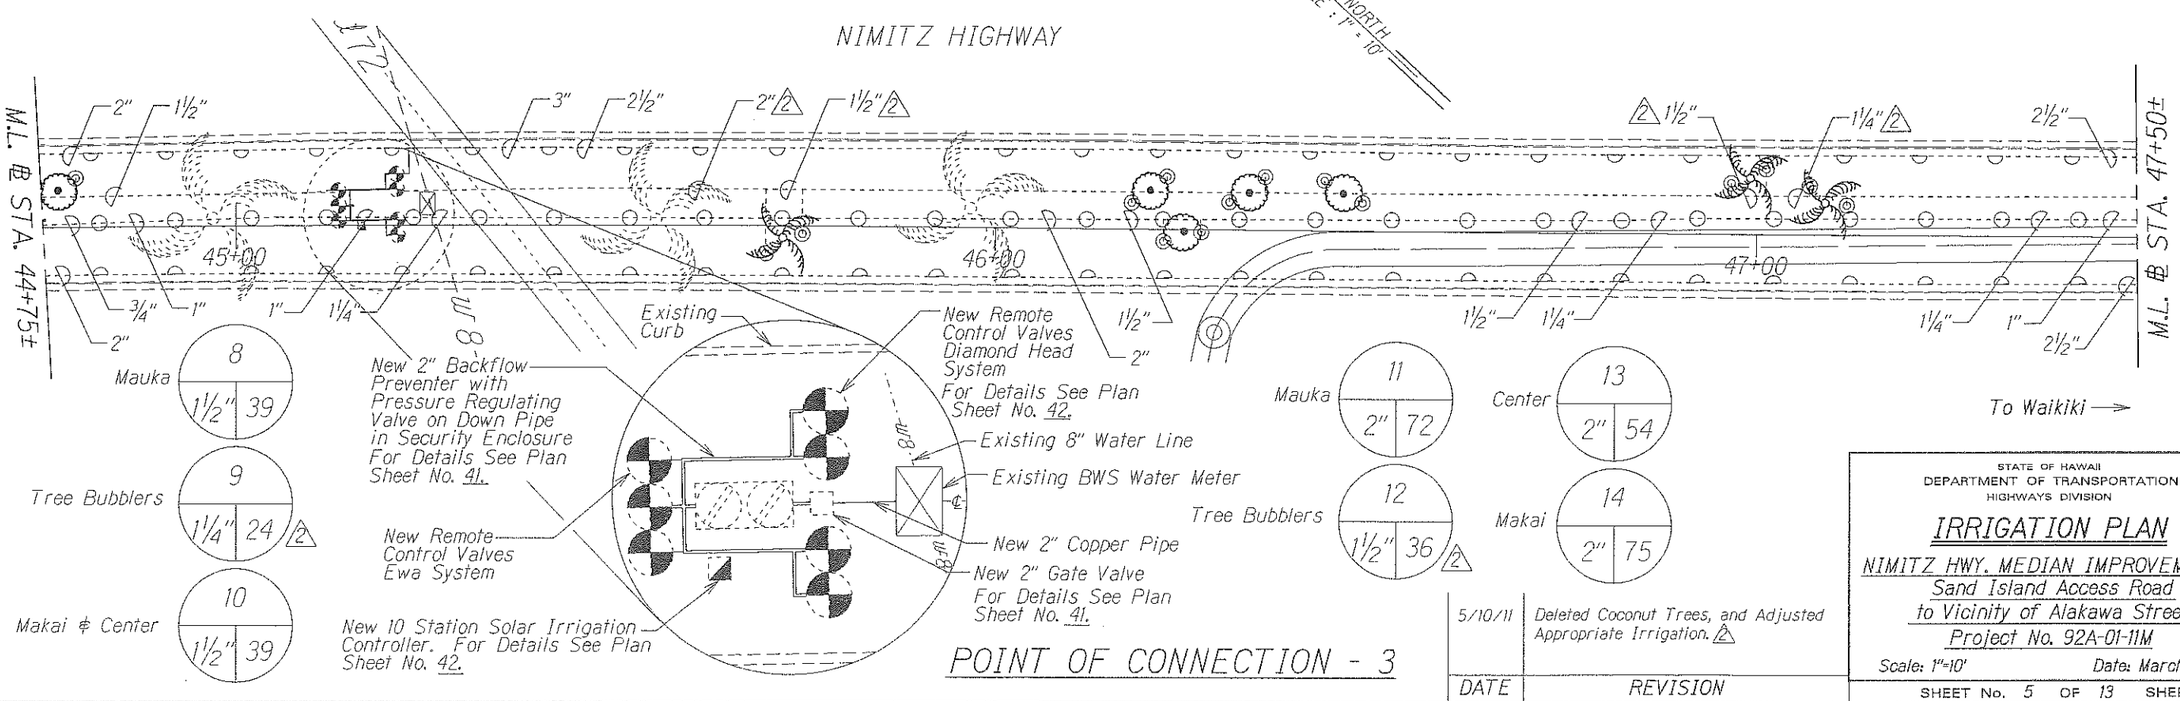

DATE	REVISION
5/10/11	Deleted Coconut Trees, and Adjusted Appropriate Irrigation. △2

STATE OF HAWAII
DEPARTMENT OF TRANSPORTATION
HIGHWAYS DIVISION

IRRIGATION PLAN

NIMITZ HWY. MEDIAN IMPROVEMENTS
Sand Island Access Road
to Vicinity of Alakawa Street
Project No. 92A-01-11M

Scale: 1"=10' Date: March, 2011

SHEET No. 5 OF 13 SHEETS

ADD.30

ORIGINAL PLAN | SURVEY PLOTTED BY | DRAWN BY | TRACED BY | DESIGNED BY | QUANTITIES BY | CHECKED BY | DATE | NOTE BOOK | 9nimdlr.pdb | N. .dgn