FED. ROAD DIST. NO.	STATE	PROJ. NO.	FISCAL YEAR	SHEET NO.	TOTAL SHEETS
HAWAII	HAW.	92A-02-86M	1985	1	12

INDEX TO DRAWINGS

SHEET NO.	DESCRIPTION
1	TITLE SHEET
2-5	PLANTING PLANS & PLANT LIST
6-11	IRRIGATION PLANS & DETAILS
12 & ADD 12S-1	STANDARD DETAILS

STATE OF HAWAII

DEPARTMENT OF TRANSPORTATION

HIGHWAYS DIVISION

HONOLULU, HAWAII

"AS-BUILT"

PLANS FOR THE HONOLULU GATEWAY BEAUTIFICATION PROJECT

ON NIMITZ HIGHWAY

SAND ISLAND ACCESS ROAD TO KALIHI STREET

PROJECT NO. 92A-02-86M

DISTRICT OF HONOLULU
ISLAND OF OAHU

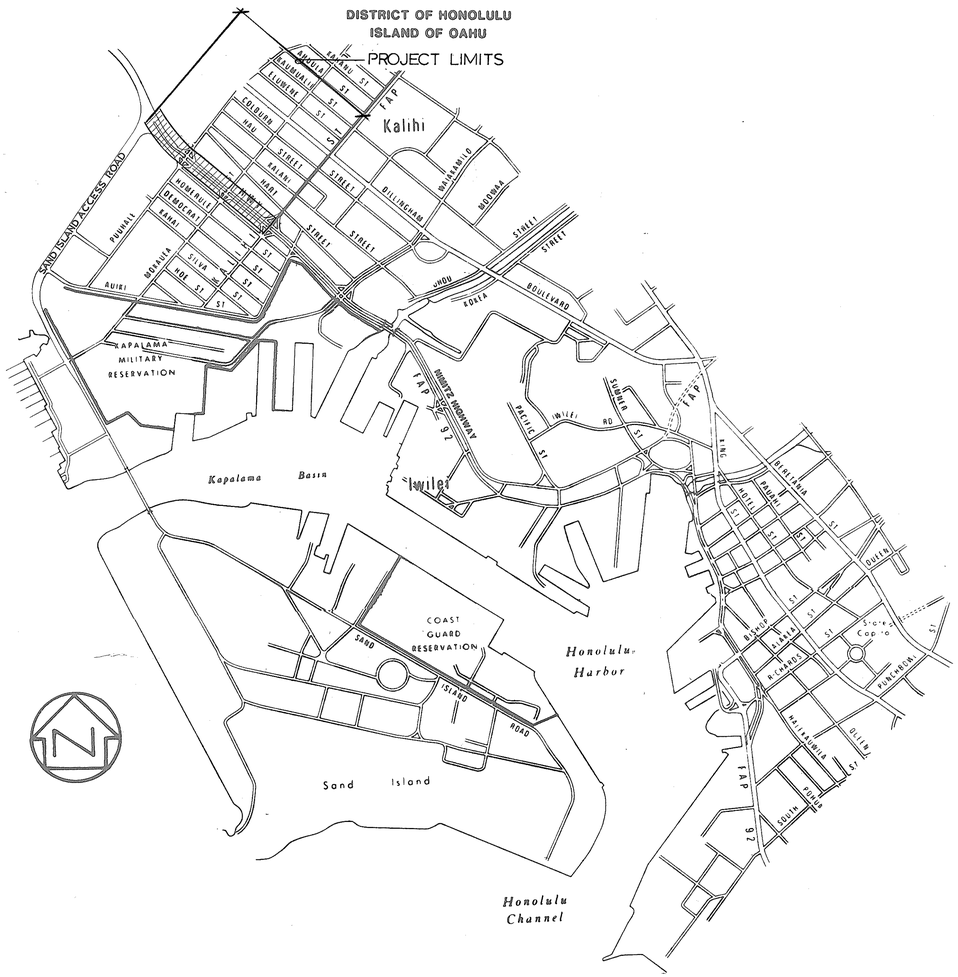

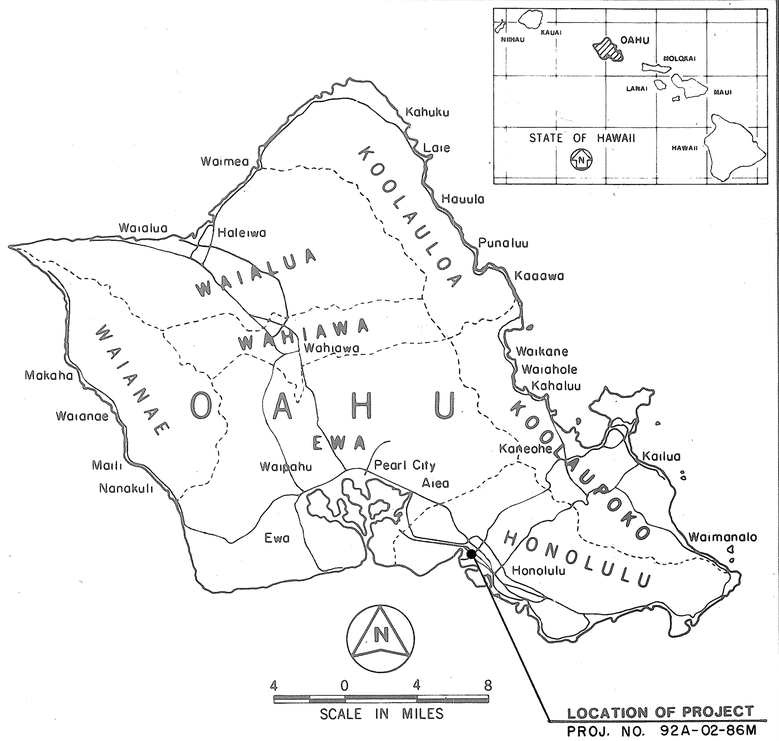

CHANGES MADE DURING CONSTRUCTION HAVE BEEN INCORPORATED ON THESE PLANS EXCEPT CHANGES IN THE ORIGINAL THEORETICAL QUANTITIES. FOR ACTUAL QUANTITIES, REFER TO PROJECT LEDGER AND/OR COMPUTATION BOOK.

Michael Dinisca — 1/6/87
RESIDENT ENGINEER — DATE

DEPARTMENT OF TRANSPORTATION
STATE OF HAWAII

APPROVED:

Jonathan K. Shiroma — 6-13-85
DIR. OF TRANSPORTATION — DATE

PHILLIPS BRANDT REDDICK — DESIGNED BY
H. TAO — P. S. & E. BY
548-6132 — PHONE
JUNE, 1985 — DATE

D.O.B. 7-8-8