FED. ROAD DIST. NO.	STATE	FED. AID PROJ. NO.	FISCAL YEAR	SHEET NO.	TOTAL SHEETS
HAWAII	HAW.	02A-01-86M	1986	4	5

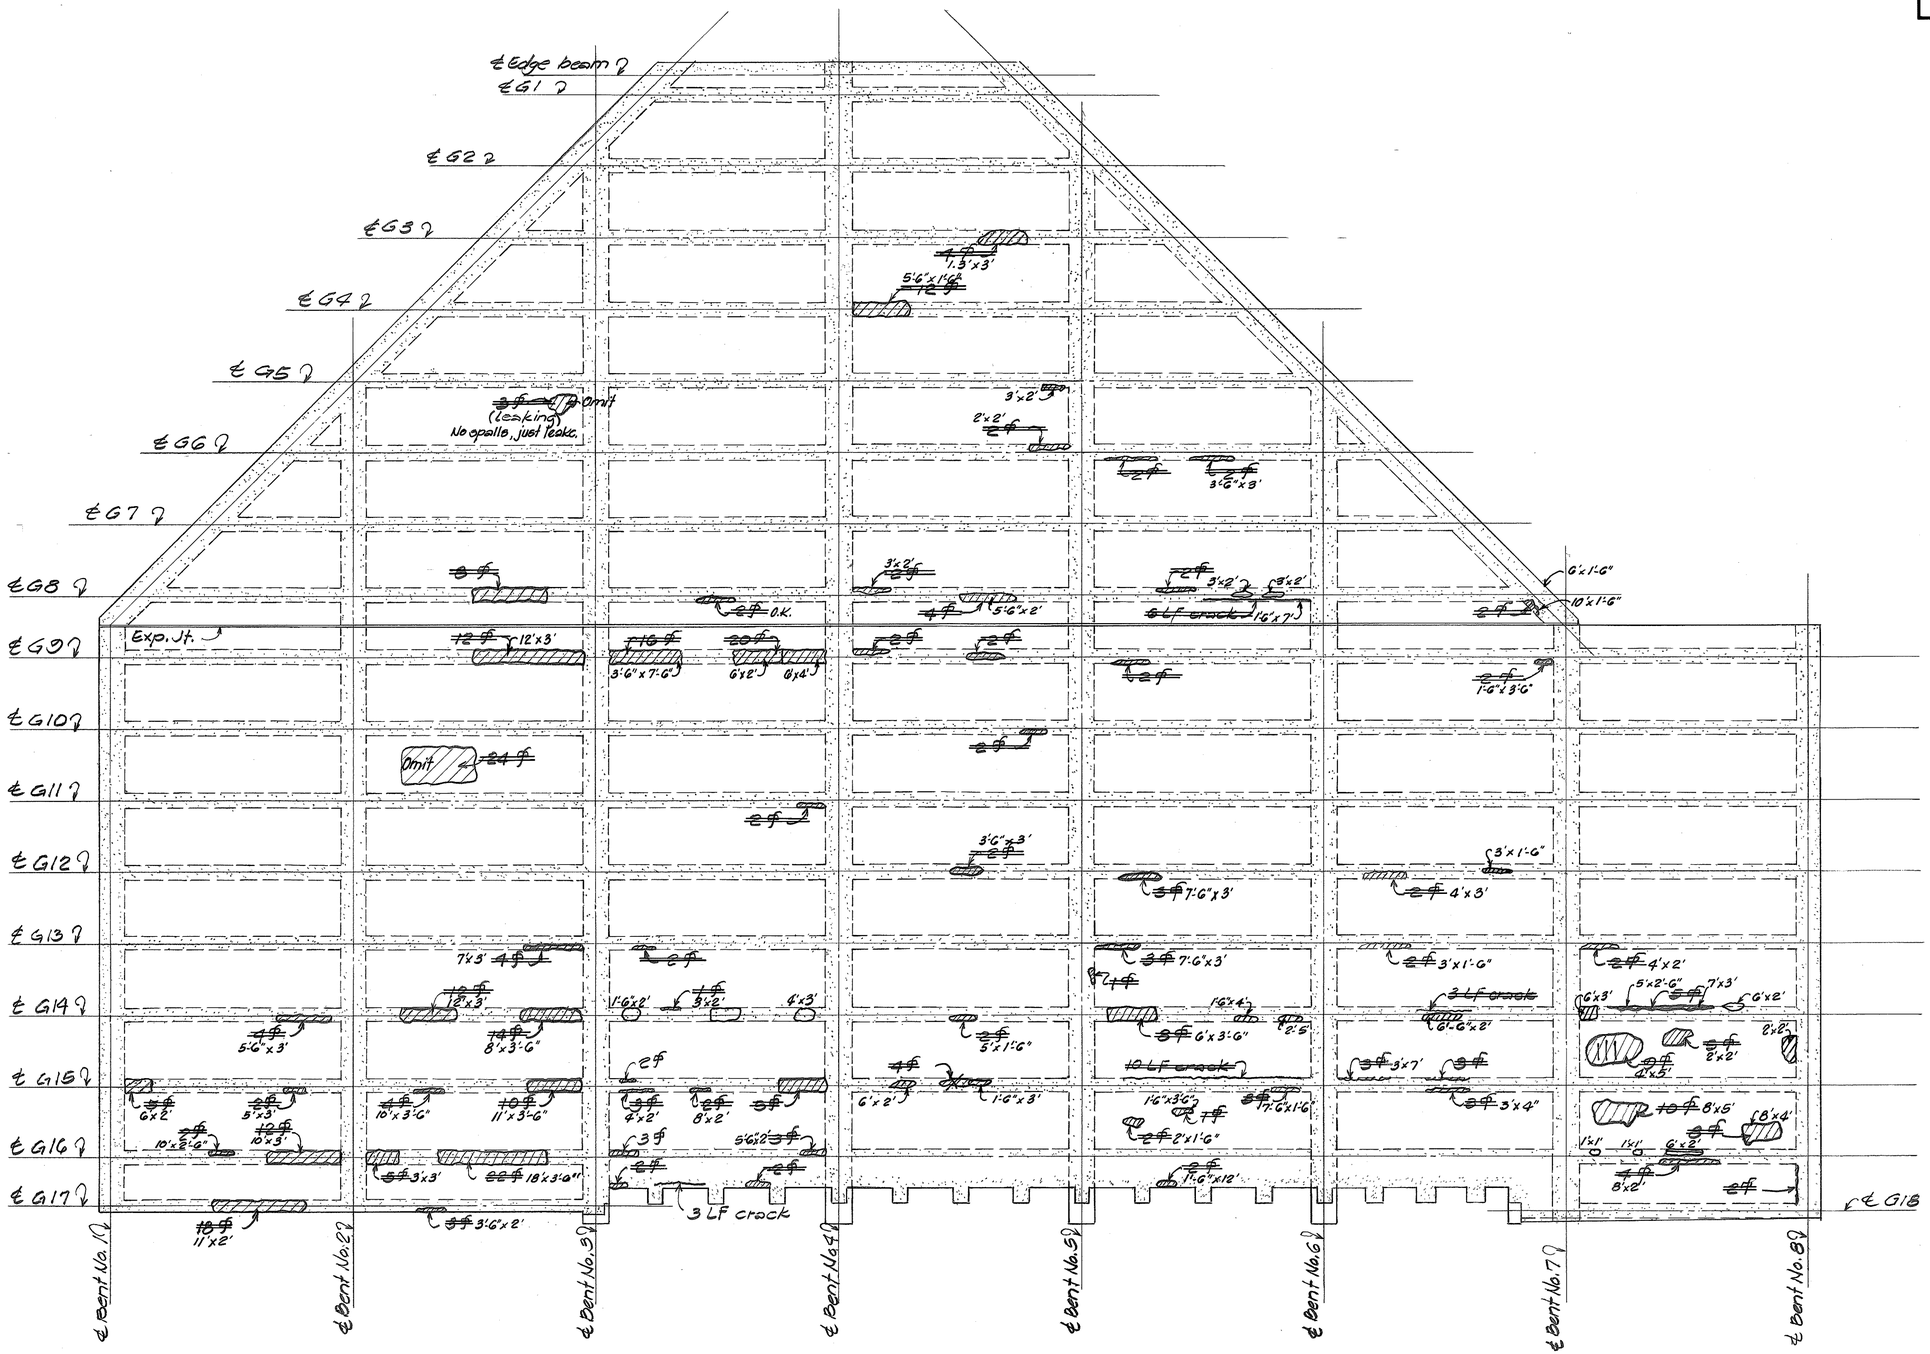

REFLECTED CEILING PLAN

SLIP COVER AT SUMNER STREET

ORIGINAL PLAN	SURVEY PLOTTED BY	DATE
	DRAWN BY	9/86
	TRACED BY	
NOTE BOOK	DESIGNED BY	9/86
	QUANTITIES BY	9/86
No.	CHECKED BY	9/86

STATE OF HAWAII
DEPARTMENT OF TRANSPORTATION
HIGHWAYS DIVISION

SLIP COVER AT SUMNER STREET

NIMITZ HIGHWAY SLIP COVERS
REPAIR SPALLED CONCRETE

Proj. No. 02A-01-86M

Scale: 1/8" = 1'-0" Date: Sept. 1985

SHEET No. 3 OF 4 SHEETS