FED. ROAD DIST. NO.	STATE	PROJ. NO.	FISCAL YEAR	SHEET NO.	TOTAL SHEETS
HAWAII	HAW.	92A-01-88M	1988	1	9

INDEX TO DRAWINGS

SHEET NO.	DESCRIPTION
1	TITLE SHEET
2	STANDARD PLANS SUMMARY
3	GENERAL NOTES & TYPICAL
	TYPICAL DETAILS
4 - 7	ROADWAY PLANS
8 - 9	TRAFFIC LEGEND, NOTES,
	DETAIL & SCHEDULE

STATE OF HAWAII

DEPARTMENT OF TRANSPORTATION

HIGHWAYS DIVISION

HONOLULU, HAWAII

"AS-BUILT"

PLANS FOR

ALA MOANA BOULEVARD RECONSTRUCTION

AHUI STREET TO HOBRON LANE

PROJECT NO. 92A-01-88M

DISTRICT OF HONOLULU

ISLAND OF OAHU

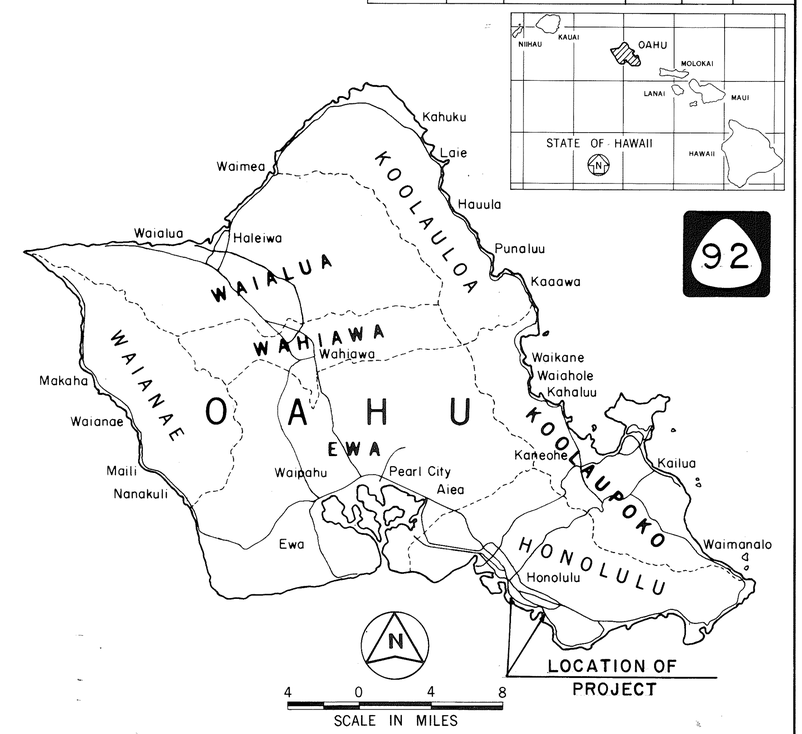

NO SIGNIFICANT CHANGES WERE MADE DURING CONSTRUCTION ON THESE PLANS EXCEPT CHANGES IN THE ORIGINAL THEORETICAL QUANTITIES.

Howard C. Y. Young — RESIDENT ENGINEER

2-5-91 — DATE

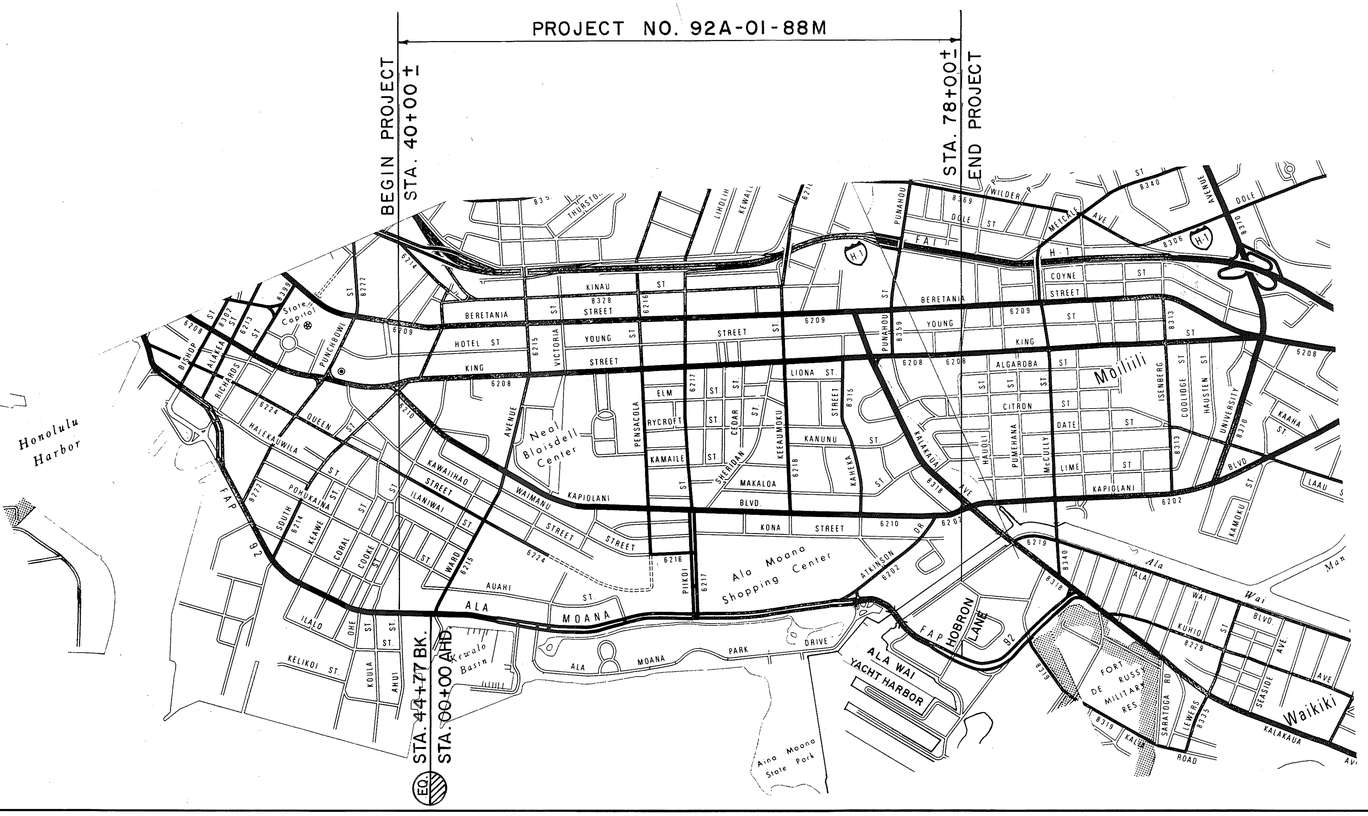

LAYOUT PLAN

1000 0 1000 2000 3000

SCALE IN FEET

GROSS LENGTH = 1.57 MI.

DESIGN UNIT C — DESIGNED BY

A. TAKESHITA — P. S. & E. BY

548-7537 — PHONE

APRIL 1988 — DATE

DEPARTMENT OF TRANSPORTATION
STATE OF HAWAII

APPROVED:

Edward Hirata — DIR. OF TRANSPORTATION

5/17/88 — DATE

DD-D-4-5