TRIM LINE

FED. ROAD DIST. NO.	STATE	PROJ. NO.	FISCAL YEAR	SHEET NO.	TOTAL SHEETS
HAWAII	HAW.	92AB-01-92M	1992	1	32

92

INDEX TO DRAWINGS

SHEET NO.	DESCRIPTION
1	TITLE SHEET
2	STANDARD PLANS SUMMARY
3	GENERAL NOTES, WATER NOTES,
	P.C.C. PAVEMENT NOTES AND LEGEND
4 – 5	TYPICAL SECTIONS
6	MISCELLANEOUS DETAILS
① 7 – 12	ROADWAY PLANS
② 13 – 29	PAVEMENT MARKINGS, SIGNING, LEGEND,
	DETAILS & NOTES
③ 30 – 32	DRAINAGE DETAILS

SHEET NOS. ① C.0.12S-1, ② C.0.19S-1 and ③ 31S-1 ARE SUPPLEMENTARY SHEETS TO THIS PROJECT. TOTAL SHEET COUNT AFTER "AS-BUILT" POSTING 35 SHTS.

STATE OF HAWAII

DEPARTMENT OF TRANSPORTATION

HIGHWAYS DIVISION

HONOLULU, HAWAII

"AS-BUILT"

PLANS FOR

ALA MOANA BOULEVARD RESURFACING

KEAWE STREET TO KALAKAUA AVENUE

PROJECT NO. 92AB-01-92M

DISTRICT OF HONOLULU

ISLAND OF OAHU

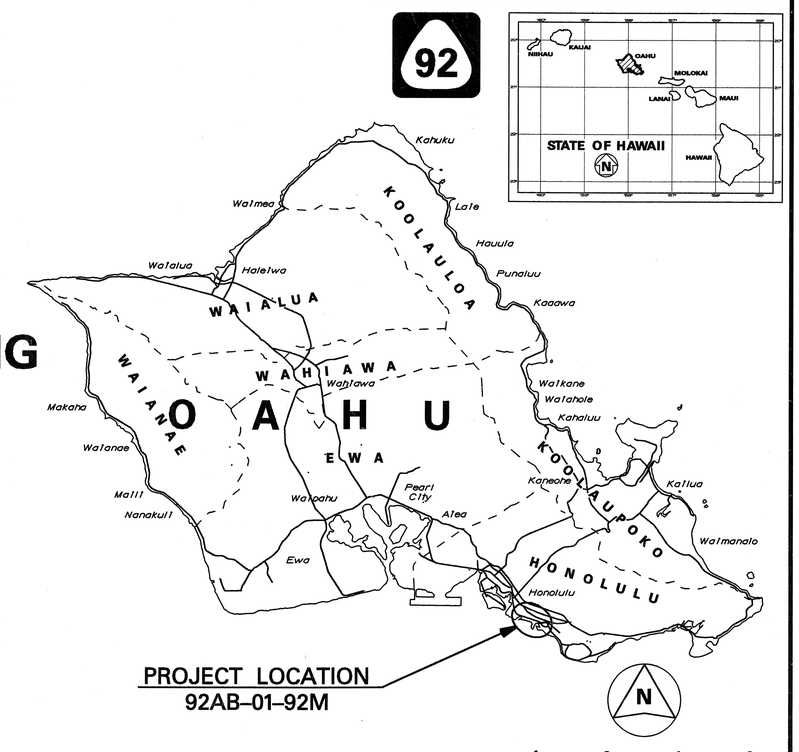

MILE POST 7.00 TO MILE POST 9.16

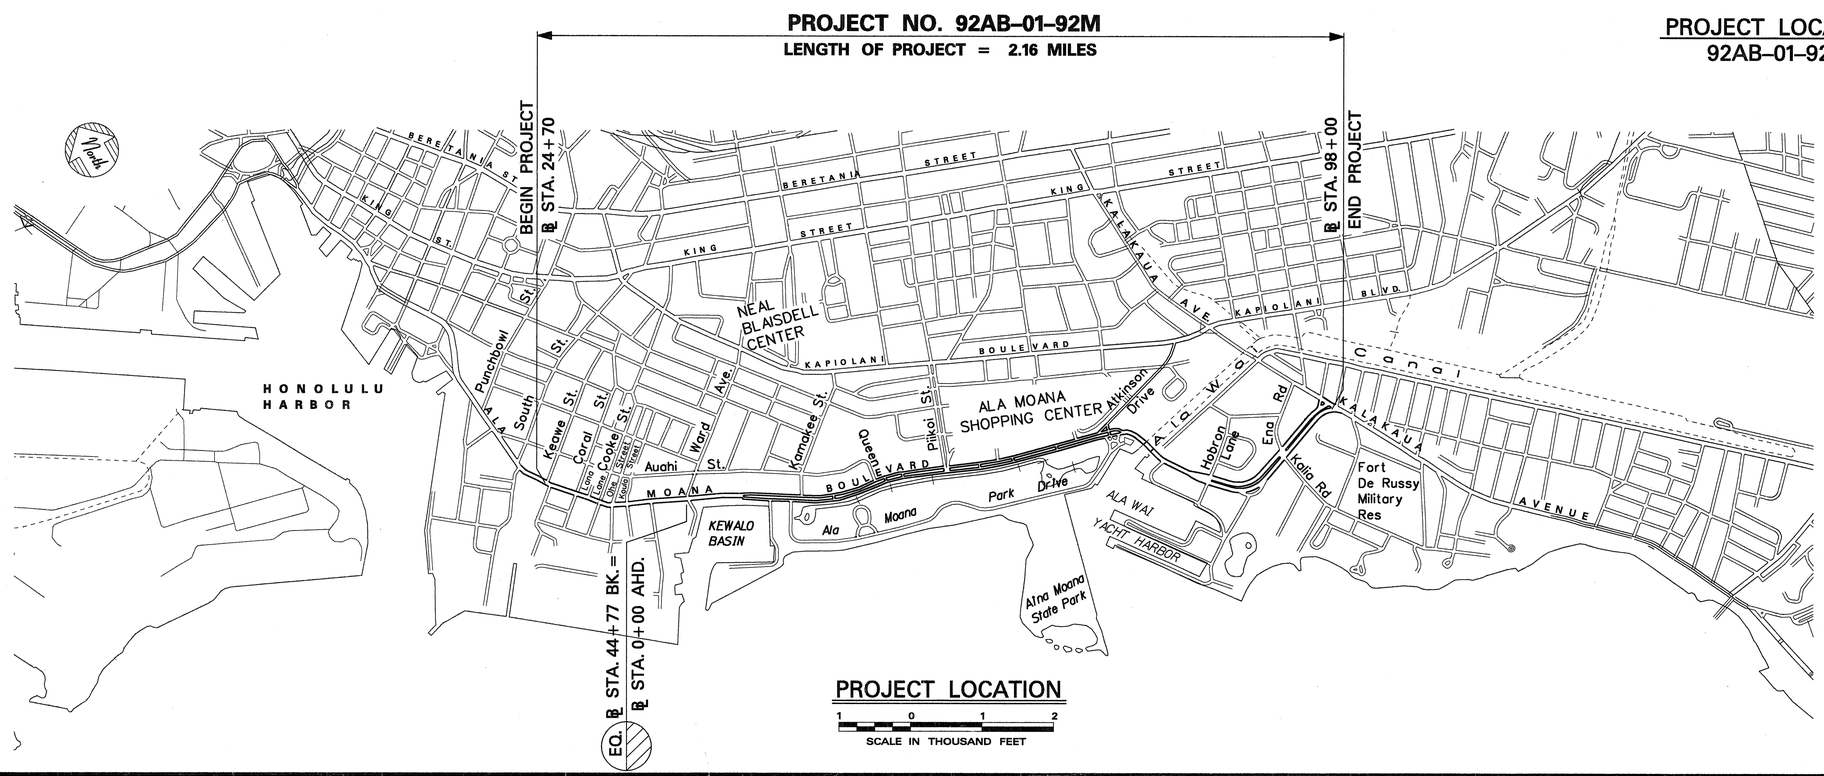

CHANGES MADE DURING CONSTRUCTION HAVE BEEN INCORPORATED ON THESE PLANS EXCEPT CHANGES IN THE ORIGINAL THEORETICAL QUANTITIES. FOR ACTUAL QUANTITIES, REFER TO PROJECT LEDGER AND/OR COMPUTATION BOOK.

RESIDENT ENGINEER 5/3/02 DATE

DEPARTMENT OF TRANSPORTATION
STATE OF HAWAII

APPROVED:

FOR DIR. OF TRANSPORTATION 4/15/92 DATE

UNIT "E"	R. TAKAESU	587-2249	SEPT.,1991
DESIGNED BY	P. S. & E. BY	PHONE	DATE

TRIM LINE

1ambdtsht.dgn 4-14-92