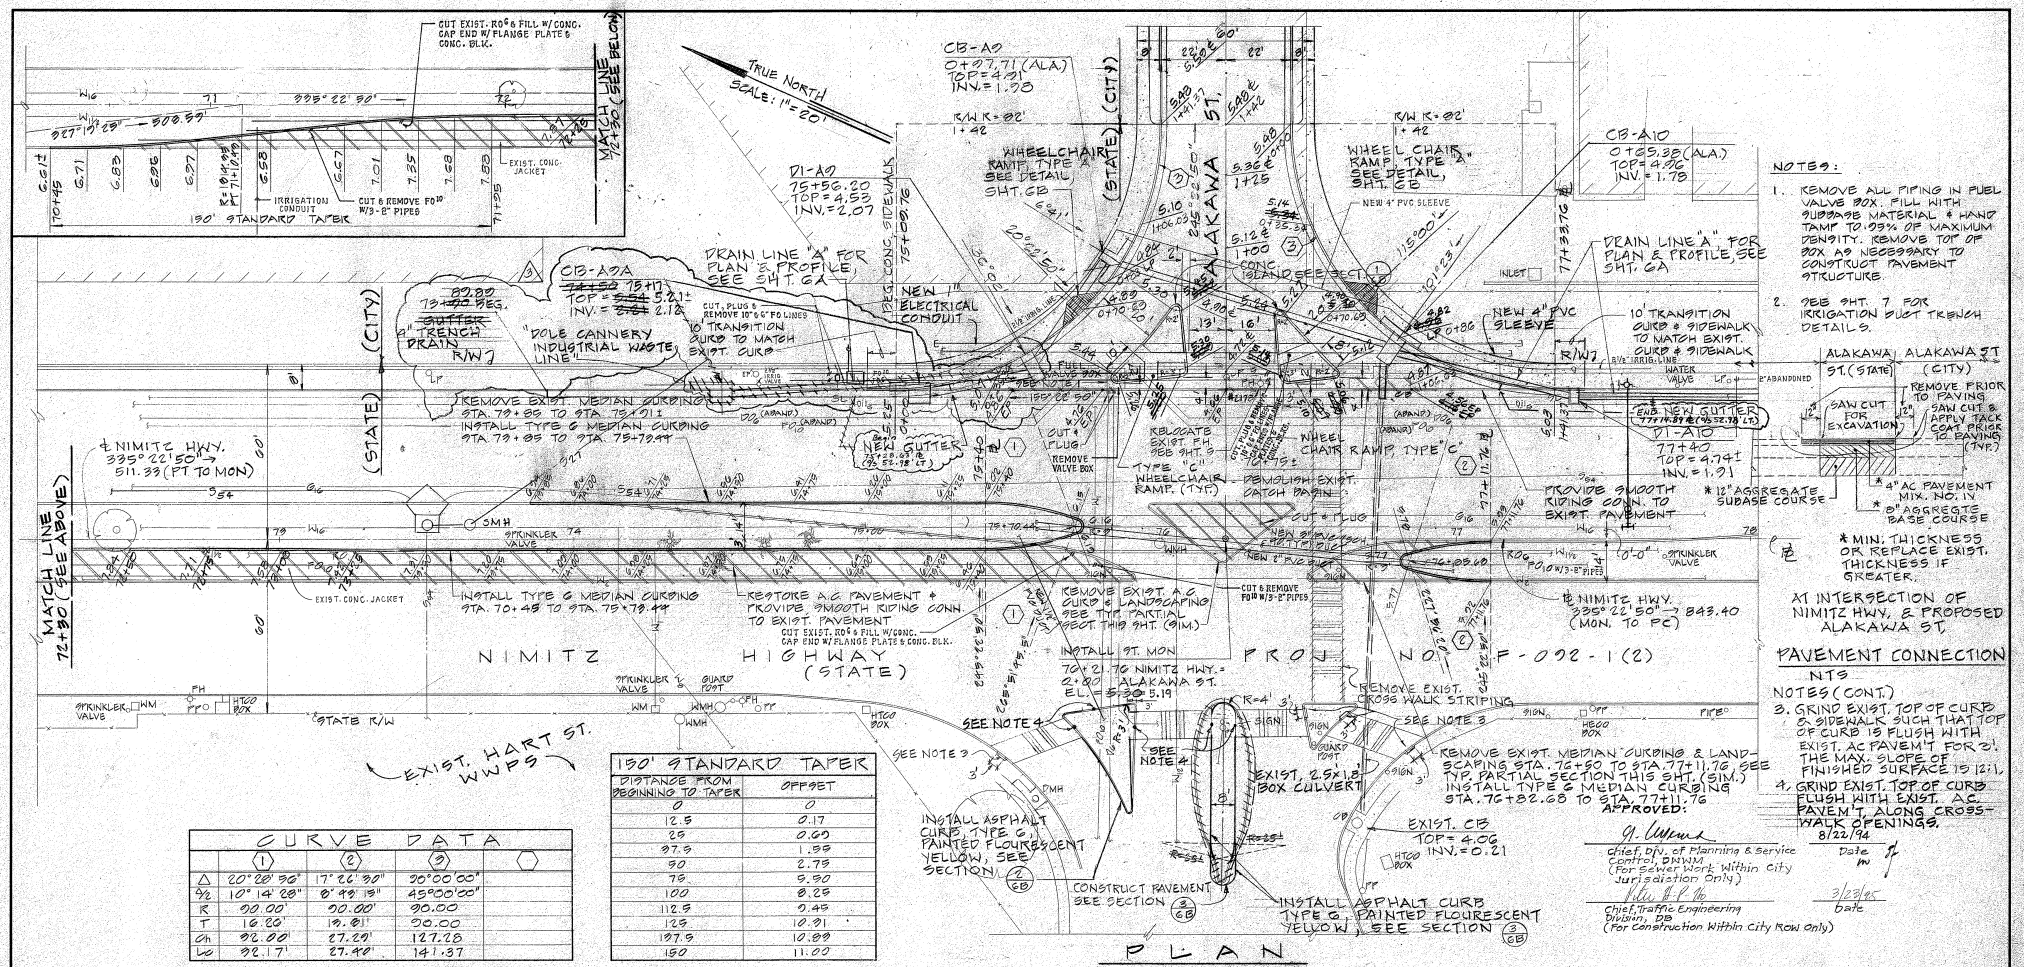

CURVE DATA				
	1	2	3	
Δ	20° 20' 30"	17° 26' 30"	90° 00' 00"	
Δ/2	10° 14' 28"	8° 43' 15"	45° 00' 00"	
R	00.00'	00.00'	00.00	
T	16.20'	13.81'	00.00	
Ch	32.00'	27.29'	127.28	
Lc	32.17'	27.40'	141.37	

150' STANDARD TAPER	
DISTANCE FROM BEGINNING TO TAPER	OFFSET
0	0
12.5	0.17
25	0.69
37.5	1.55
50	2.75
75	5.50
100	8.25
112.5	9.45
125	10.31
137.5	10.88
150	11.00