FED. ROAD DIST. NO.	STATE	FED. AID PROJ. NO.	FISCAL YEAR	SHEET NO.	TOTAL SHEETS
HAWAII	HAW.	STP-092-1(24)	2000	1	57

INDEX TO DRAWINGS

SHEET NO.	DESCRIPTION
1	TITLE SHEET
2	STANDARD PLAN SUMMARY
3	GENERAL NOTES & LEGEND
4	UTILITY NOTES
5–6	TYPICAL PAVEMENT SECTIONS
7	PAVEMENT TRANSITIONS
8	PAVEMENT TRANSITIONS & BIKEWAY DETAILS
9–14	ROADWAY PLAN
15	PAVEMENT MARKING LEGEND, DETAILS & NOTES
16	PAVEMENT MARKING DETAILS
17–22	SIGNING & PAVEMENT MARKING PLAN
23	PANEL LAYOUTS & GENERAL NOTES
24–25	PANEL LAYOUTS
26	PANEL LAYOUT & FRAME LAYOUT DETAILS
27	TRAFFIC SIGN SUMMARY AND FRAME LAYOUT DETAILS
28	TRAFFIC SIGN & PAVEMENT MARKING SUMMARIES
29	DESTINATION SIGN SUMMARY
30	DESTINATION AND CONSTRUCTION SIGN SUMMARIES
31–36	INTERSECTION PLAN
37	TRAFFIC SIGNAL NOTES & LEGEND
38–43	TRAFFIC SIGNAL MODIFICATION PLAN
44–45	NPDES POLLUTANT CONTROL GENERAL NOTES
46–47	EROSION CONTROL PLAN
48–49	CURB RAMP DETAILS
50	CURB RAMP DETAILS AND MISCELLANEOUS DETAILS
51–53	MISCELLANEOUS DETAILS
54	LOOP DETECTOR DETAILS
55	MISCELLANEOUS DETAILS
56	GENERAL NOTES FOR PULLBOX & COVER
57	PULLBOX & COVER DETAILS

STATE OF HAWAII

DEPARTMENT OF TRANSPORTATION

HIGHWAYS DIVISION

HONOLULU, HAWAII

"AS-BUILT"

PLANS FOR

NIMITZ HIGHWAY RESURFACING

RODGERS BOULEVARD TO AHUA STREET

FEDERAL AID PROJECT NO. STP-092-1(24)

DISTRICT OF HONOLULU

ISLAND OF OAHU

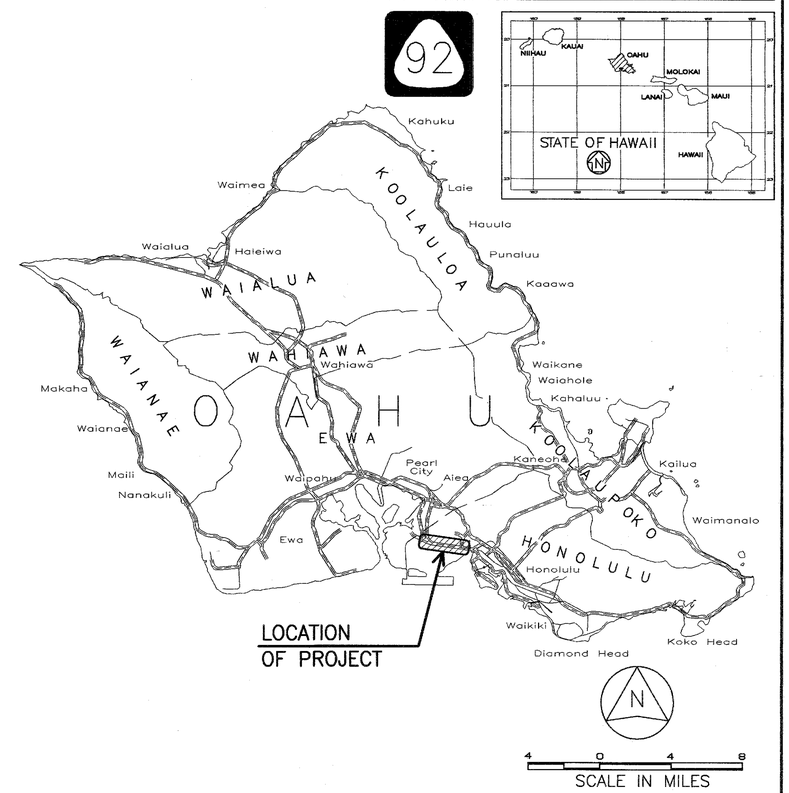

FEDERAL AID PROJECTS PREVIOUSLY CONSTRUCTED OR UNDER CONSTRUCTION

MILE POST 1.85 TO MILE POST 3.07

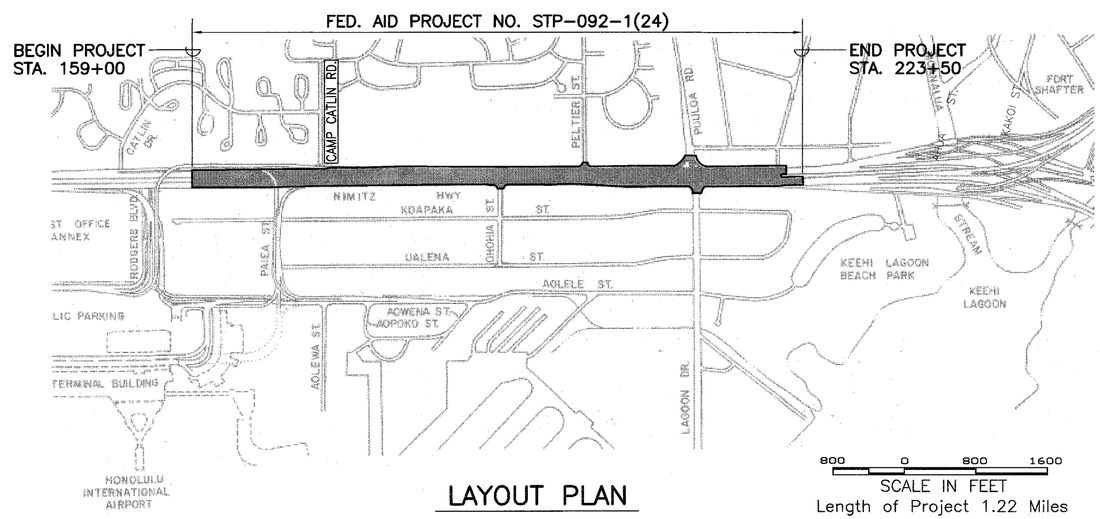

LAYOUT PLAN

Length of Project 1.22 Miles

DESIGN DESIGNATION

	RODGERS BLVD. TO LAGOON DR.	LAGOON DR. TO AHUA ST.	SERVICE RD.
ADT (1999)	36,280	61,840	2610
ADT (2009)	38,940	67,380	2960
DHV	3,330	5,830	265
D	55/45	55/45	–
T	4.0	6.0	2.0
V	40	40	30

CHANGES MADE DURING CONSTRUCTION HAVE BEEN INCORPORATED ON THESE PLANS EXCEPT CHANGES IN THE ORIGINAL THEORETICAL QUANTITIES. FOR ACTUAL QUANTITIES, REFER TO PROJECT LEDGER AND/OR COMPUTATION BOOK.

RESIDENT ENGINEER — DATE 10/16/2013

DEPARTMENT OF TRANSPORTATION
STATE OF HAWAII

APPROVED:

DIR. OF TRANSPORTATION — DATE 11/18/99

WILSON OKAMOTO & ASSOCIATES
DESIGNED BY STEVEN UECHI 587-2626
P. S. & E. BY PHONE
DATE