FED. ROAD DIST. No.	STATE	PROJ. No.	FISCAL YEAR	SHEET No.	TOTAL SHEETS
HAWAII	HAW	B-900-01-60	1960	4	8

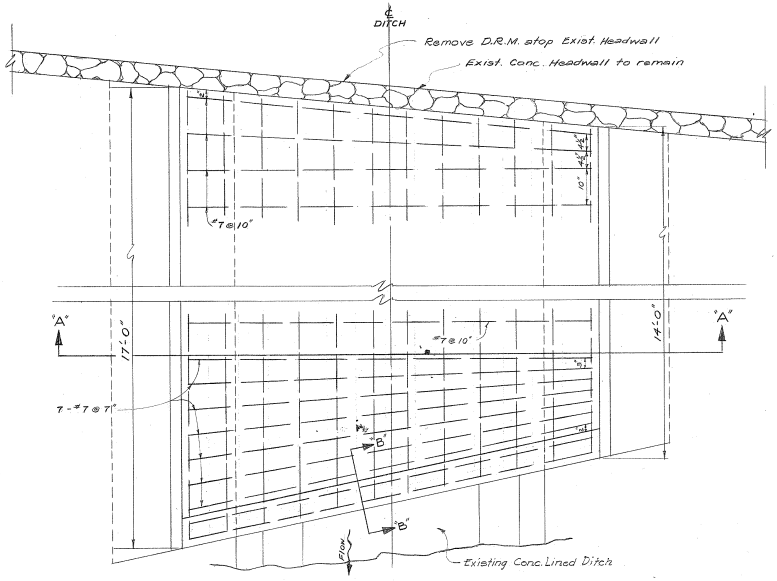

PLAN
BOTTOM REINFORCING
Scale: 3/8" = 1'-0"

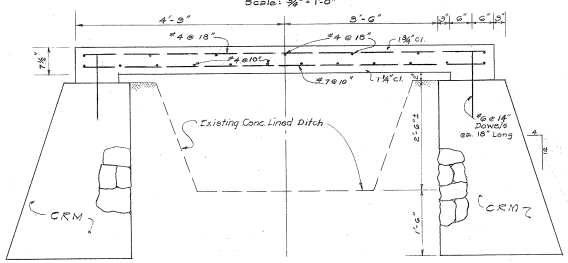

SECTION "A-A"
Scale: 3/8" = 1'-0"

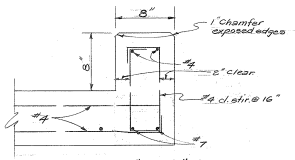

SECTION "B-B"
Scale: 1 1/2" = 1'-0"

OUTLET

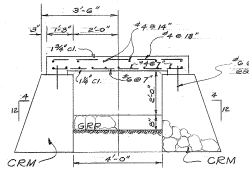

SECTION "A-A"

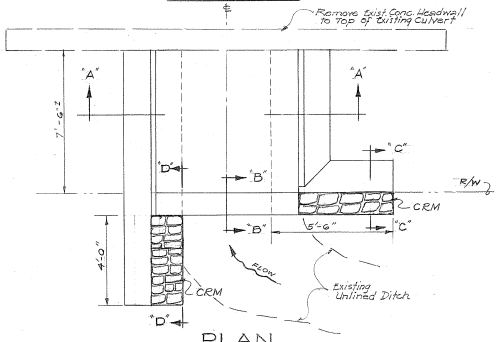

PLAN
Scale: 3/8" = 1'-0"

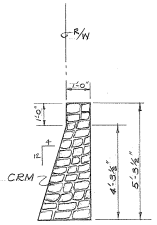

SECTION "C-C"

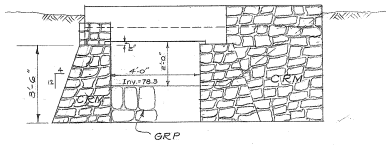

ELEVATION
Scale: 3/8" = 1'-0"

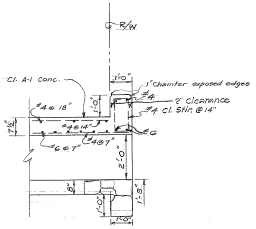

SECTION "B-B"

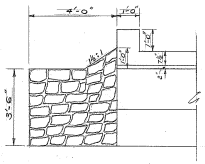

SECTION "D-D"
Scale: 3/8" = 1'-0"

INLET

DEPARTMENT OF TRANSPORTATION
STATE OF HAWAII

CULVERT EXTENSION DETAIL
PROJECT No. B-900-01-60

SCALE: AS NOTED — JUNE, 1960

SHEET No. 4 OF 8 SHEETS

ORIGINAL PLAN	SURVEY PLOTTED BY	DATE
	DESIGNED BY	
	DRAWN BY	
	TRACED BY	
NOTE BOOK No.	QUANTITIES CHECKED BY	
	CHECKED BY	

PRINTED ON DIEPO 1000H CLEARPRINT