FED. ROAD DIST. No.	STATE	PROJ. No.	FISCAL YEAR	SHEET No.	TOTAL SHEETS
HAWAII	HAW.	B-900-01-60	1960	3	8

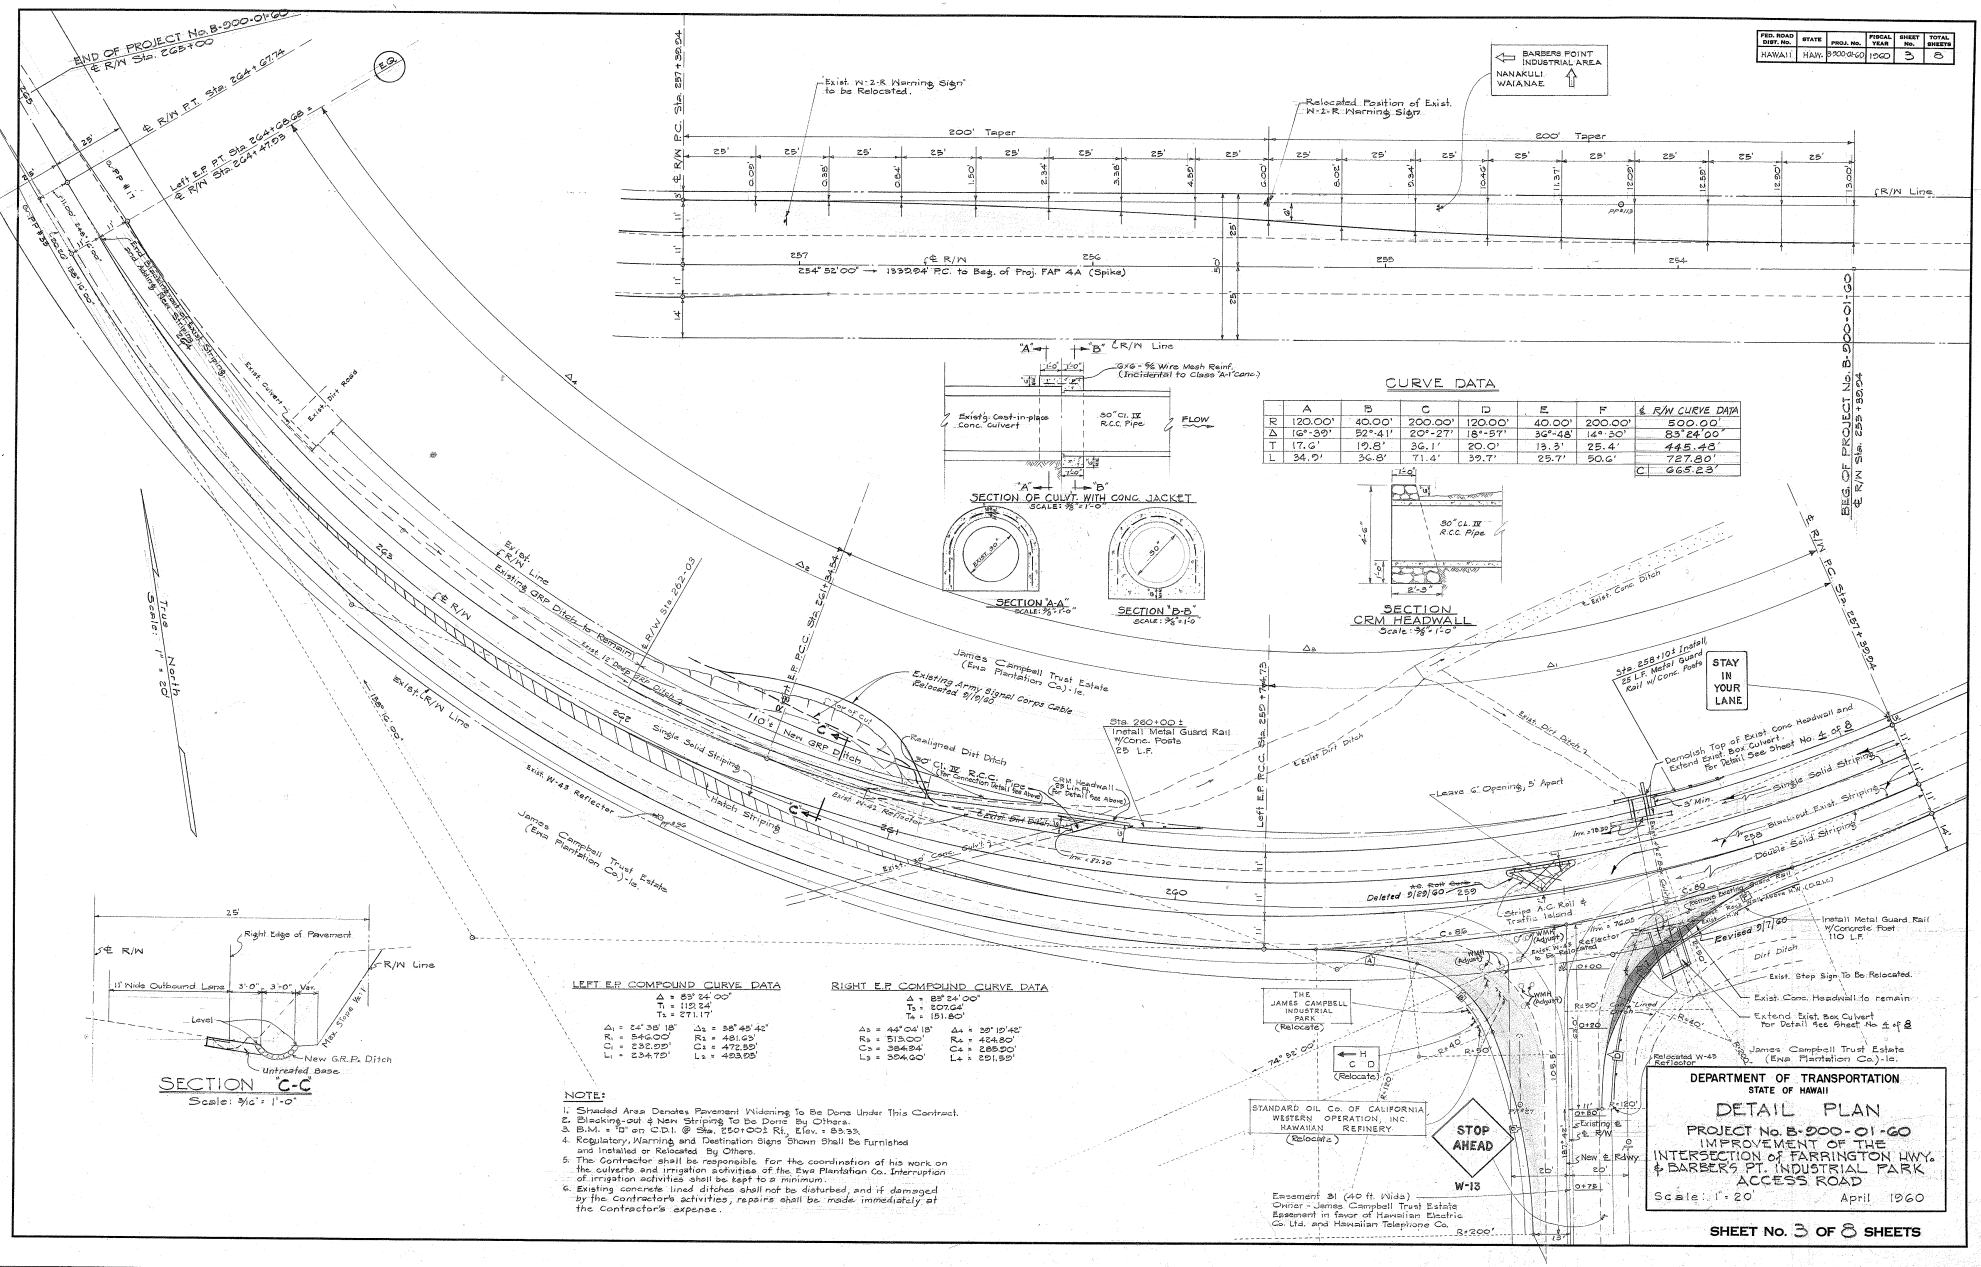

PRINTED ON DIEPO 1000H CLEARPRINT