

STATE	FISCAL YEAR	SHEET NO.	TOTAL SHTS.
HAWAII	1967	64	76

PROJECT NO. B-900-01-64 UNIT I

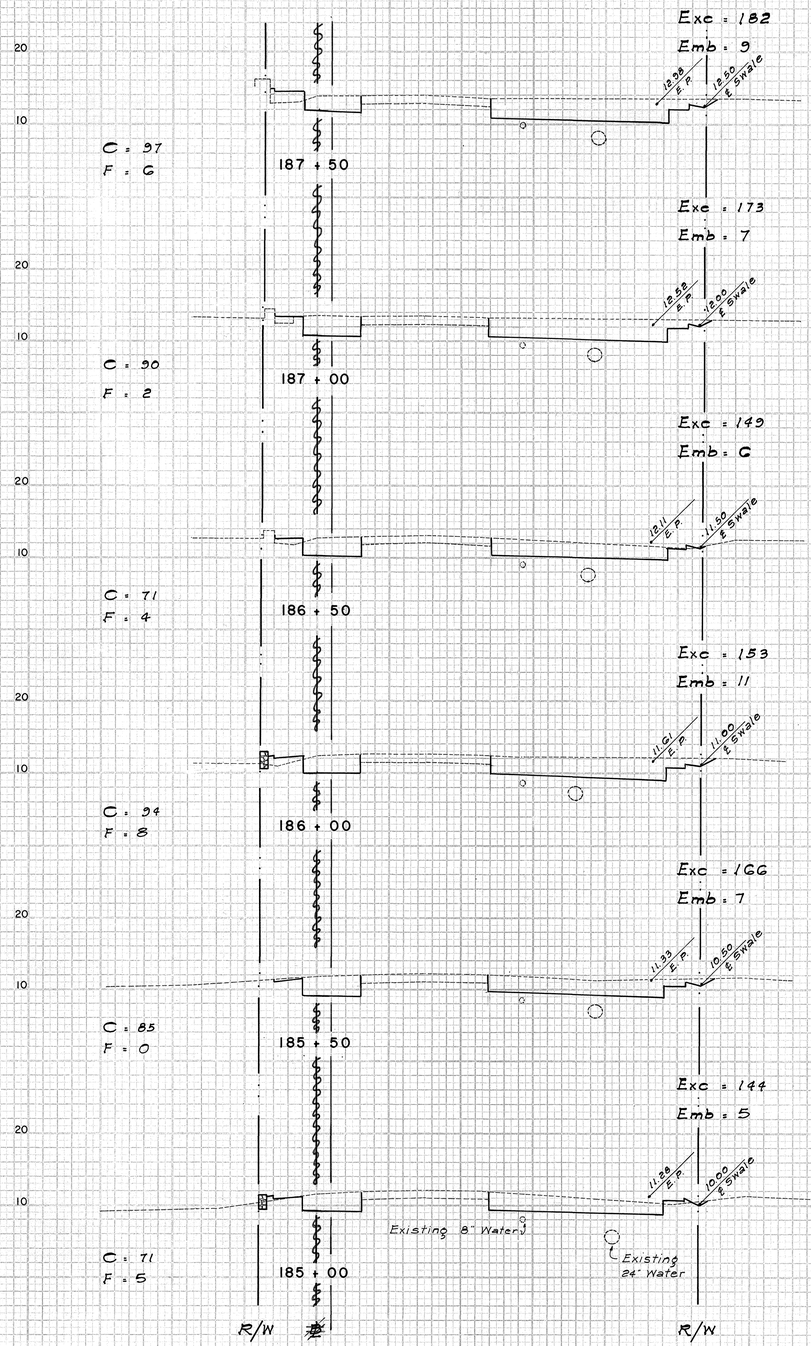

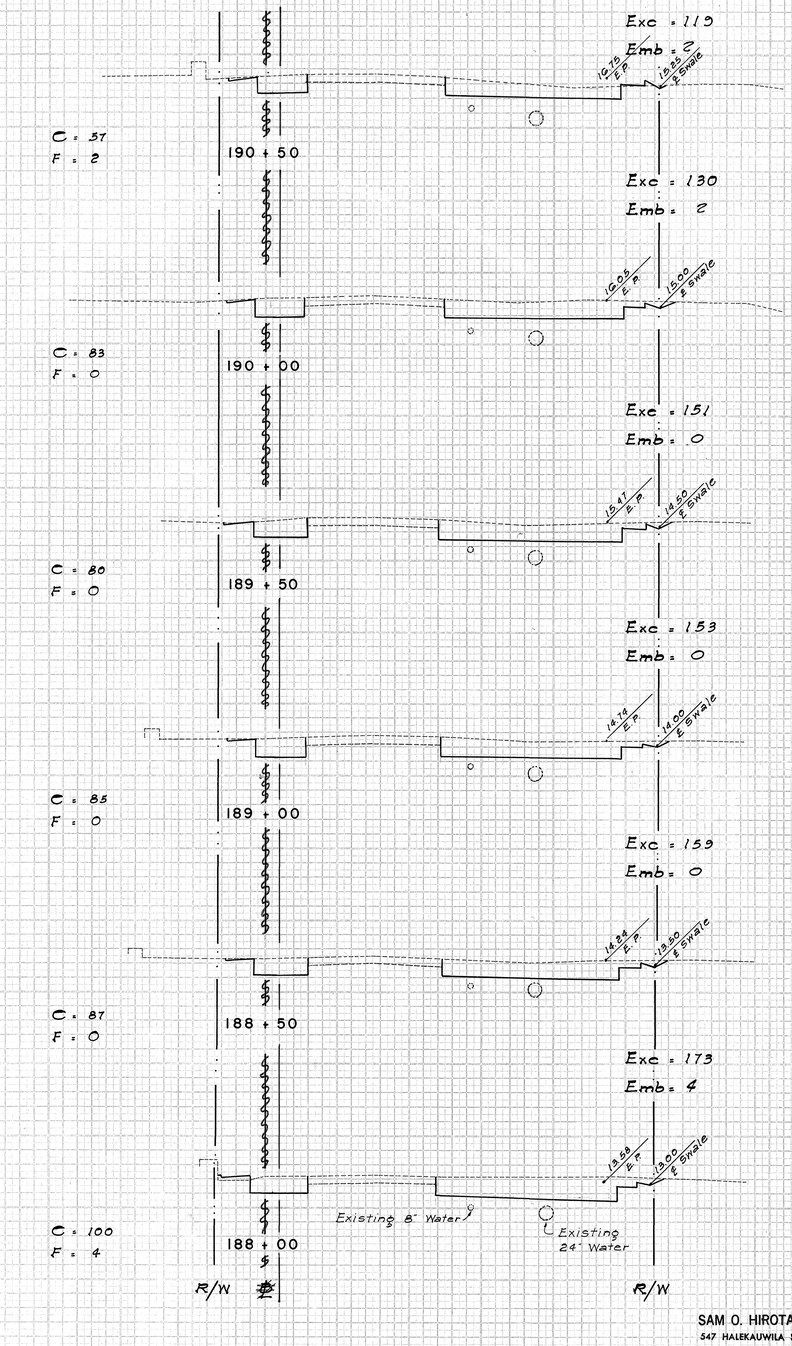

℄ is 10' from R/W

SAM O. HIROTA
REGISTERED PROFESSIONAL ENGINEER & SURVEYOR
No. 610-ES
HAWAII, U.S.A.

THIS WORK WAS PREPARED BY ME OR UNDER MY SUPERVISION.

Sam O. Hirota

SAM O. HIROTA, P. E. - - CIVIL ENGINEERS & SURVEYORS
547 HALEKAUWILA ST. • ROOM 204 • HONOLULU, HAWAII 96813

64

SHEET No. 1 OF 9 SHEETS

FINAL SURVEY — SURVEYED, PLOTTED, TRANSLATE, NOTE BOOK, AREAS, NO., AREAS CHECKED, BY, DATE


ORIGINAL SURVEY — SURVEYED, PLOTTED, TRANSLATE, NOTE BOOK, AREAS, NO., AREAS CHECKED, BY, DATE


STATE	FISCAL YEAR	SHEET NO.	TOTAL SHTS.
HAWAII	1967	65	76

PROJECT NO. B-900-01-64 UNIT I

FINAL SURVEY — SURVEYED, PLOTTED, TEMPLATE, AREAS, AREAS CHECKED, NOTE BOOK, NO., BY, DATE

ORIGINAL SURVEY — SURVEYED, PLOTTED, TEMPLATE, AREAS, AREAS CHECKED, NOTE BOOK, NO., BY, DATE

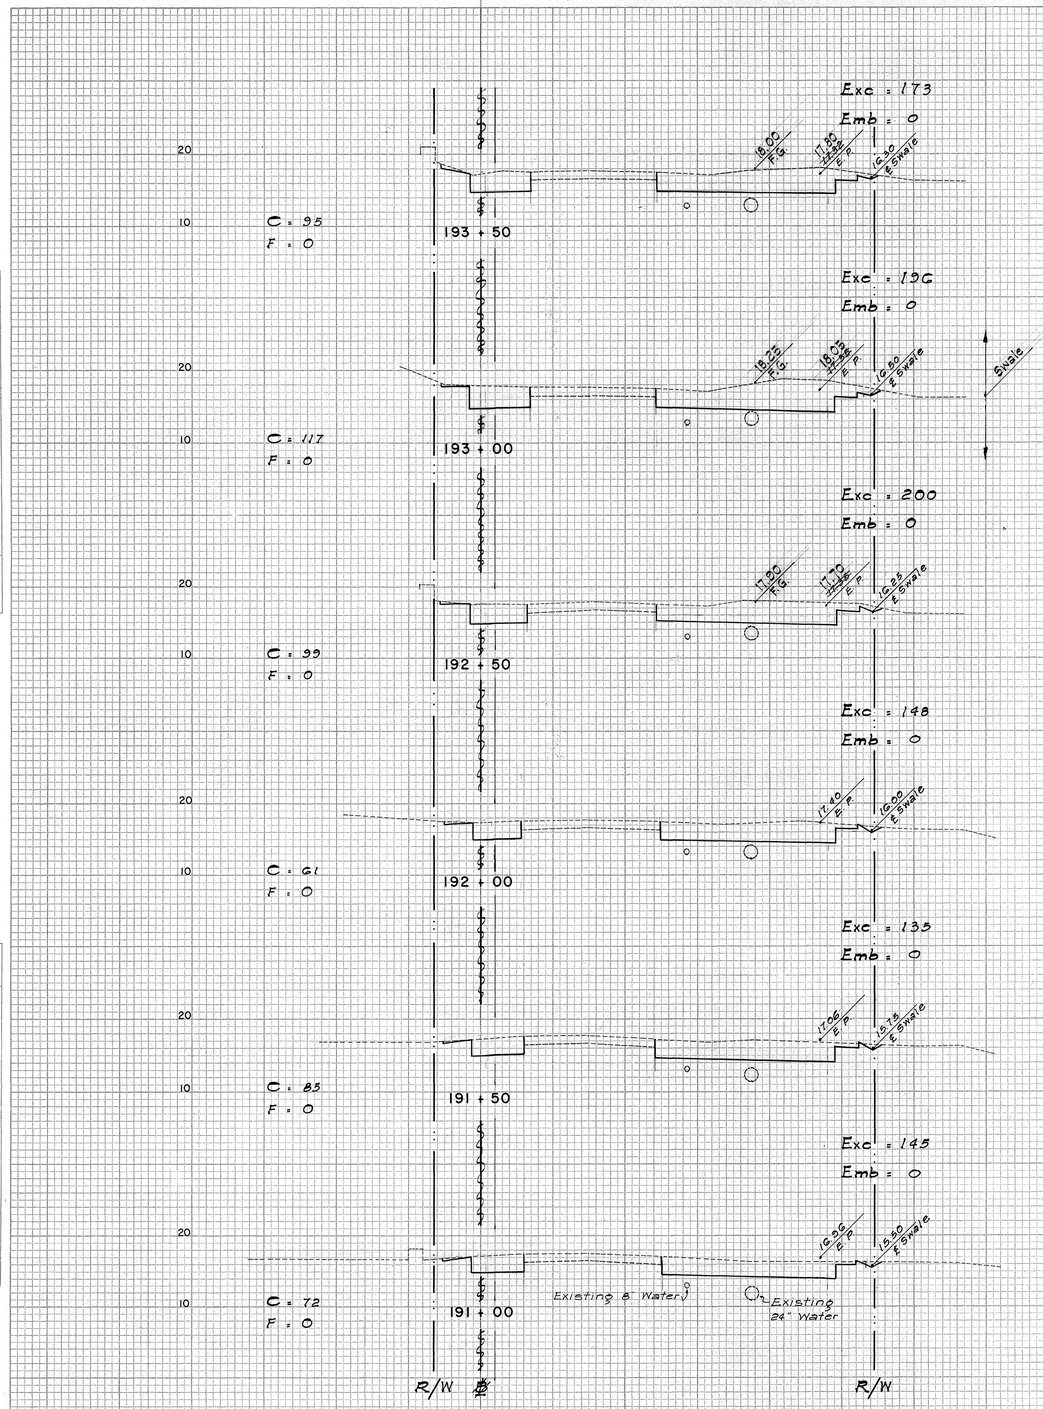

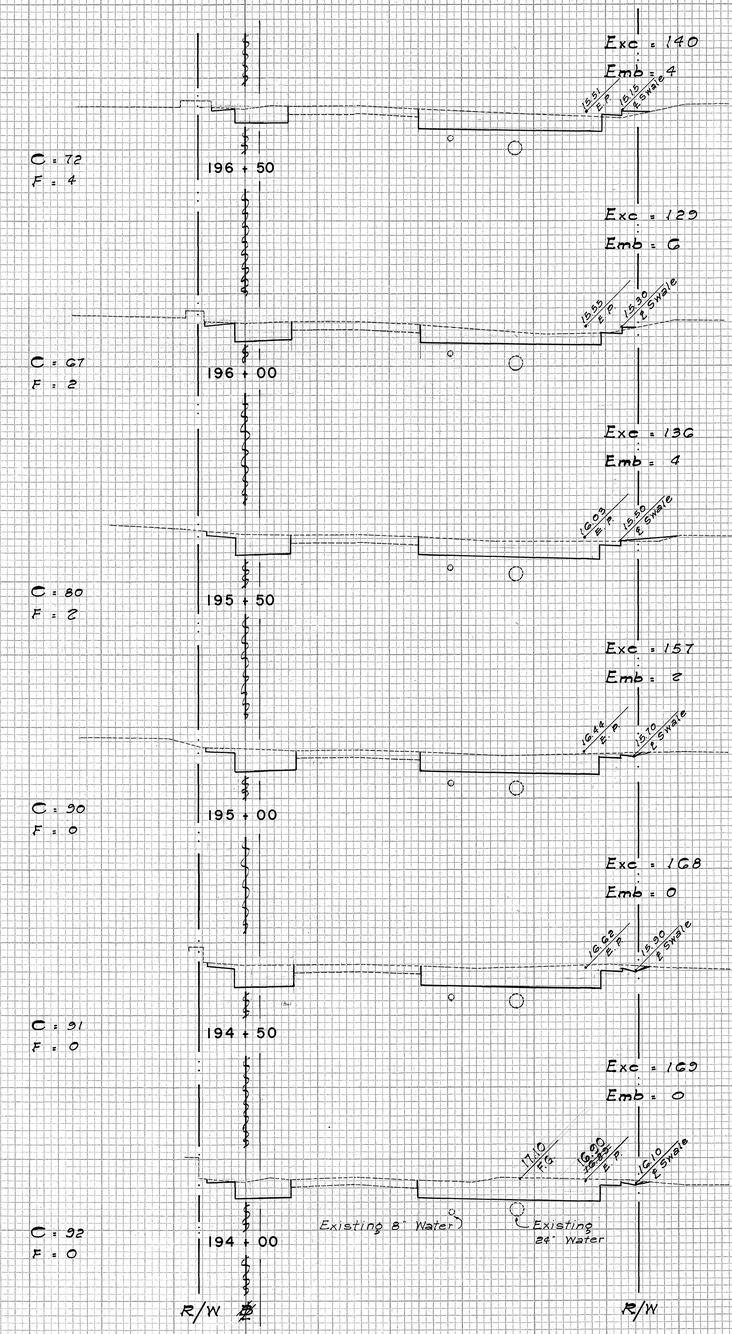

℄ is 10' from R/W

PLATE 3 - CROSS SECTION O. P. R. & R. E. STANDARD
KEUFFEL & ESSER CO., NEW YORK.

65


SHEET No 2 OF 9 SHEETS


STATE	FISCAL YEAR	SHEET NO.	TOTAL SHTS.
HAWAII	1967	66	76

PROJECT NO. B-900-01-64 UNIT I

FINAL SURVEY — SURVEYED, PLOTTED, TEMPLATE, AREAS, AREAS CHECKED, NOTE BOOK, NO., BY, DATE

ORIGINAL SURVEY — SURVEYED, PLOTTED, NOTE BOOK, AREAS, AREAS CHECKED, BY, DATE

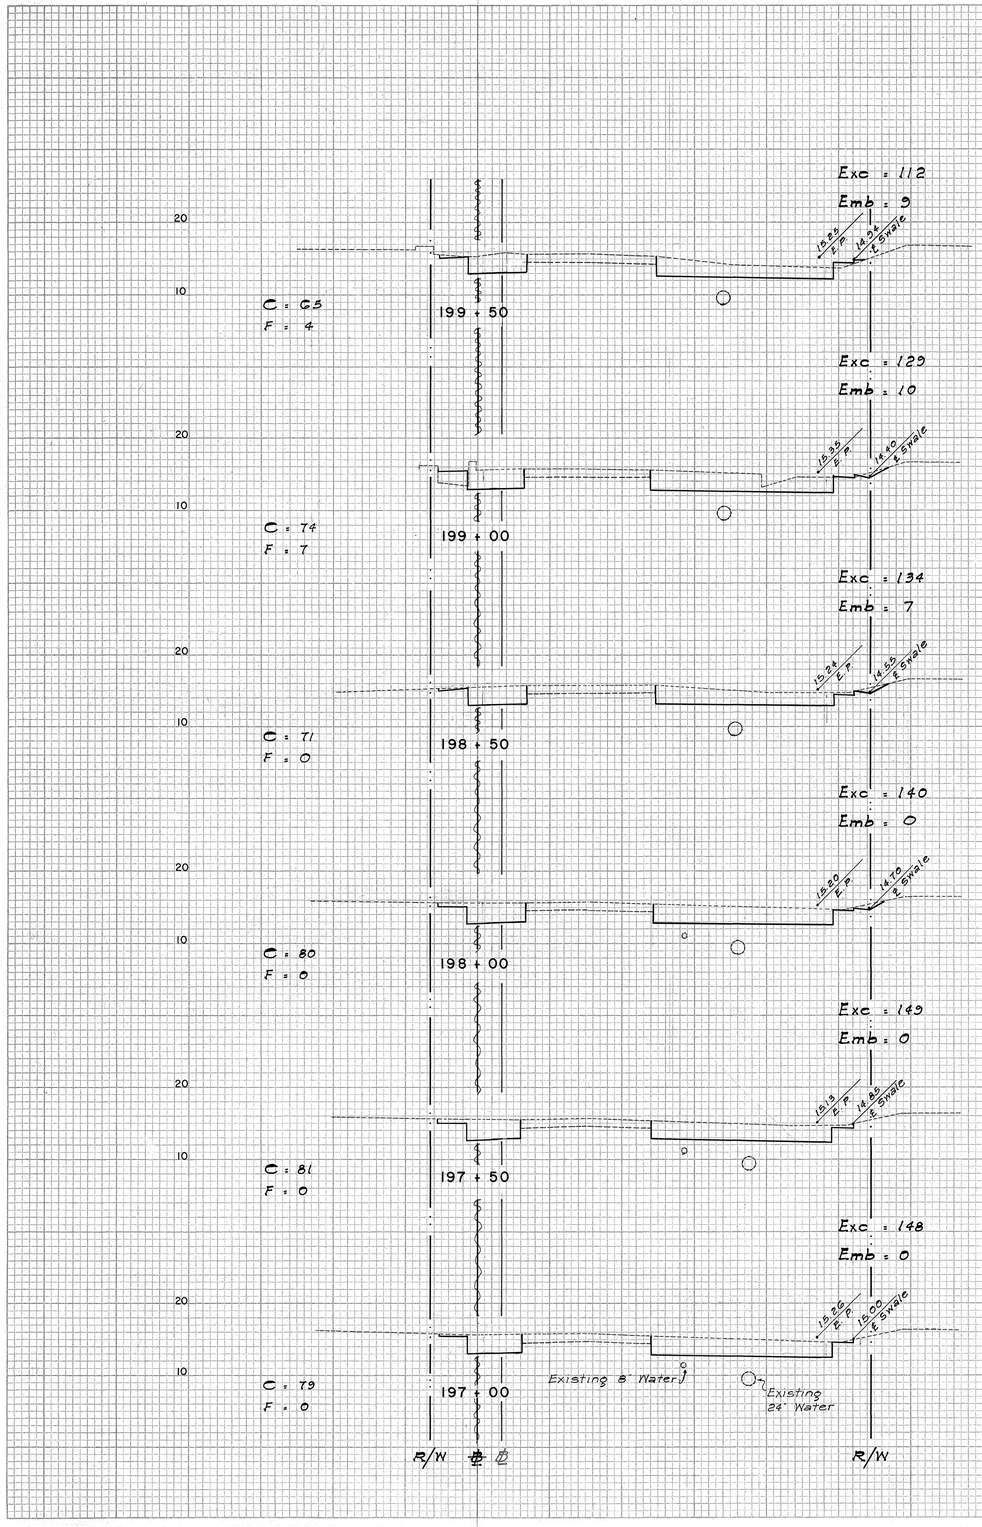

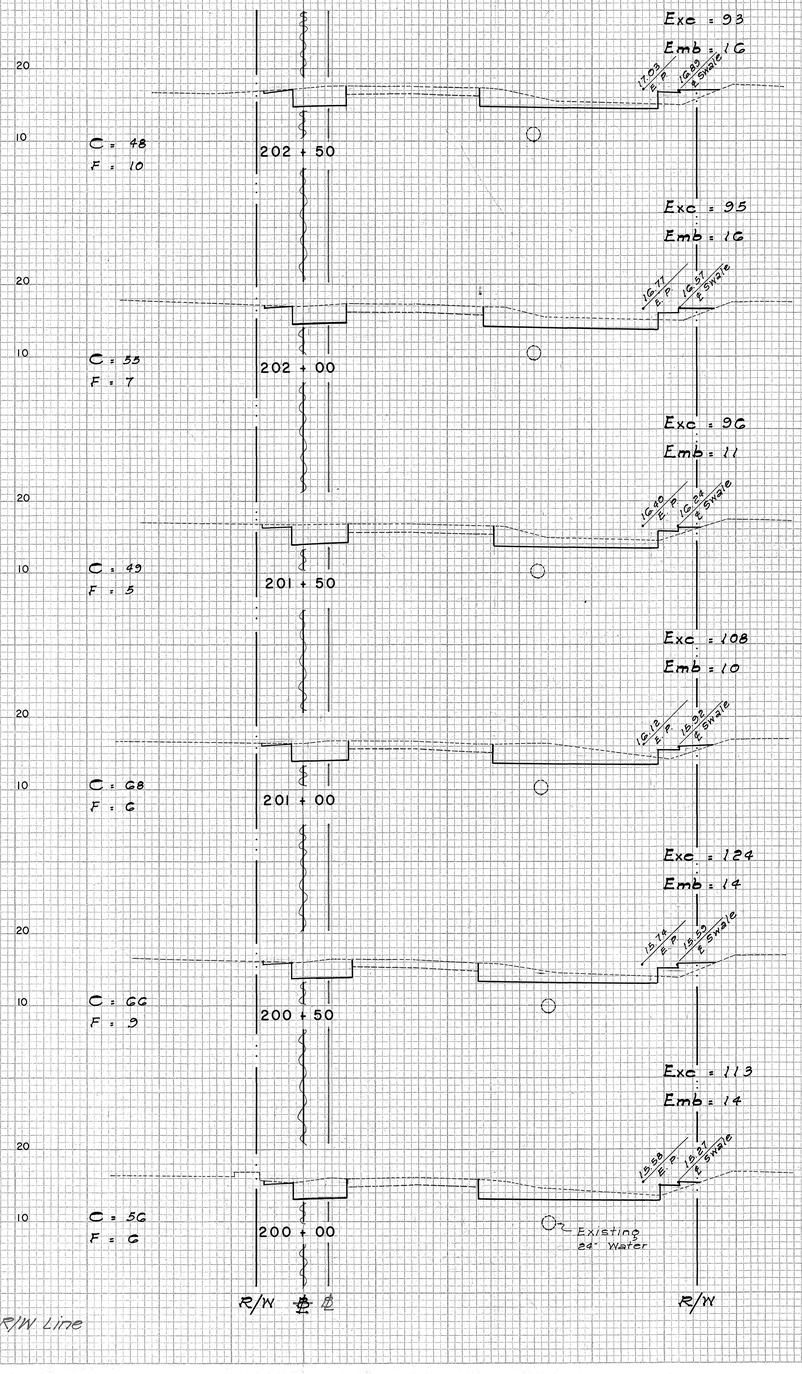

NOTE:
℄ is 10' from R/W Line

PLATE 3 - CROSS SECTION O. P. R. & R. E. STANDARD
KEUFFEL & ESSER CO., NEW YORK


SHEET No 3 OF 9 SHEETS


STATE	FISCAL YEAR	SHEET NO.	TOTAL SHTS.
HAWAII	1967	67	76

PROJECT NO. B-900-01-64 UNIT I

FINAL SURVEY — SURVEYED, PLOTTED, TEMPLATE, AREAS CHECKED — NOTE BOOK — NO. — BY — DATE

ORIGINAL SURVEY — SURVEYED, PLOTTED, TEMPLATE, AREAS CHECKED — NOTE BOOK — NO. — BY — DATE

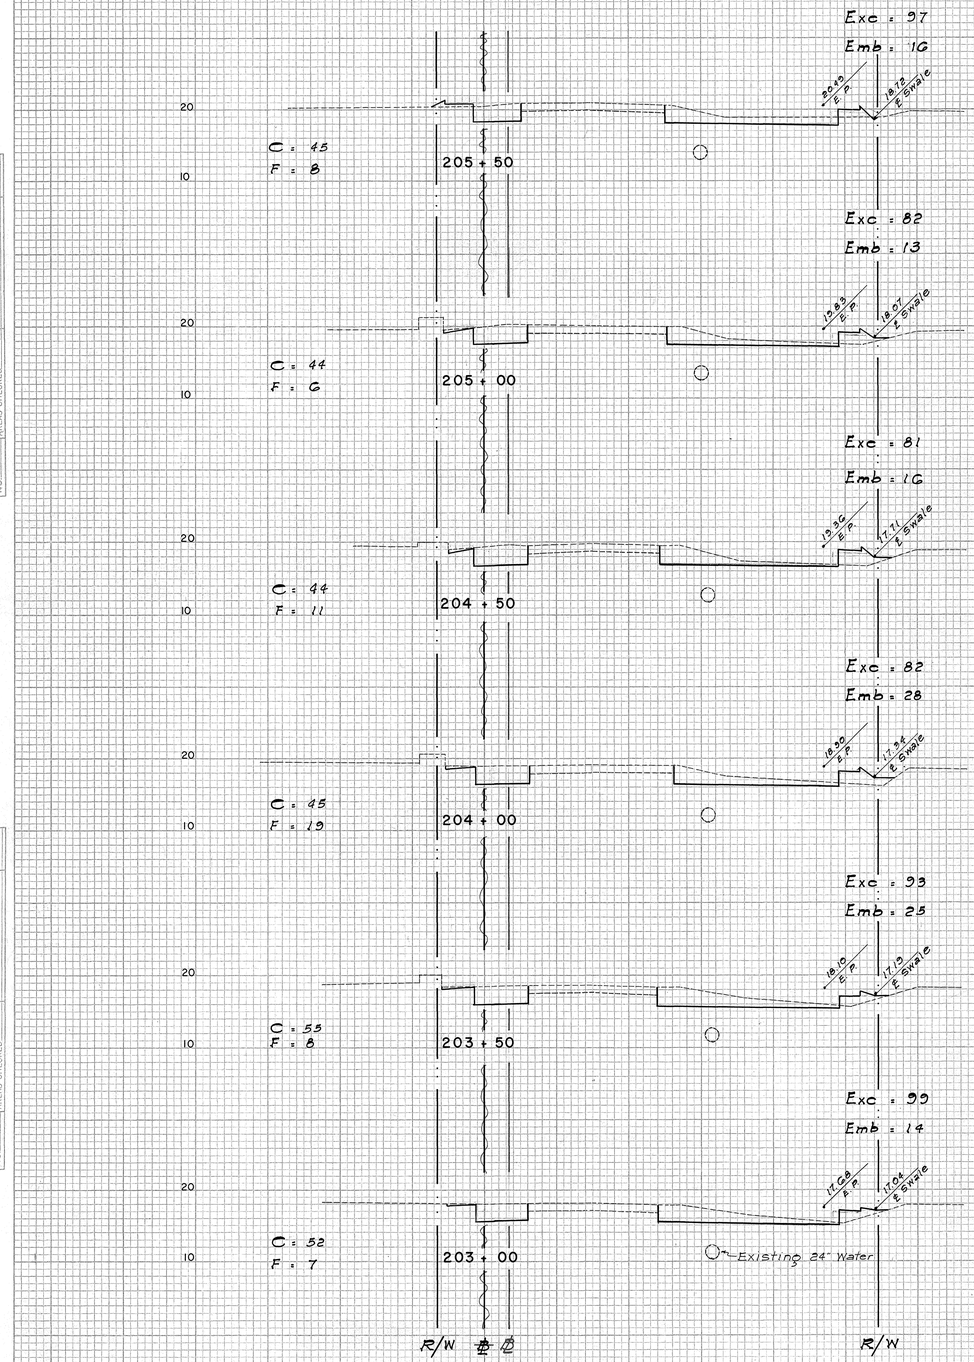

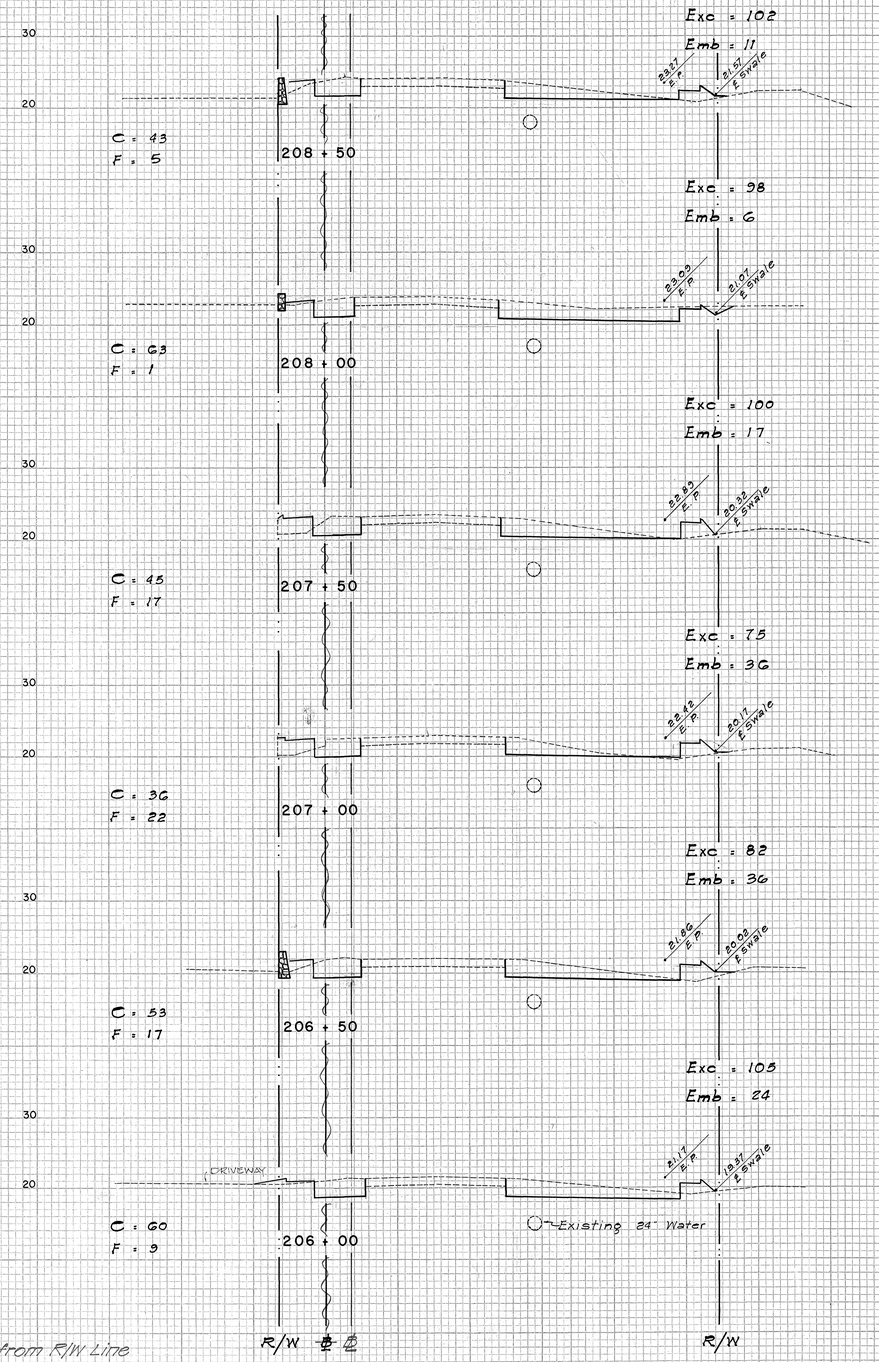

NOTE:
℄ is 10' from R/W Line

PLATE 3 - CROSS SECTION O. P. III & R. E. STANDARD
KEUFFEL & ESSER CO., NEW YORK.

67


SHEET No. 4 OF 9 SHEETS


STATE	FISCAL YEAR	SHEET NO.	TOTAL SHTS.
HAWAII	1967	68	76

PROJECT NO. B-900-01-64 UNIT I

FINAL SURVEY — SURVEYED, PLOTTED, TEMPLATE, AREAS, AREAS CHECKED — NOTE BOOK — NO. — BY — DATE

ORIGINAL SURVEY — SURVEYED, PLOTTED, TEMPLATE, AREAS, AREAS CHECKED — NOTE BOOK — NO. — BY — DATE

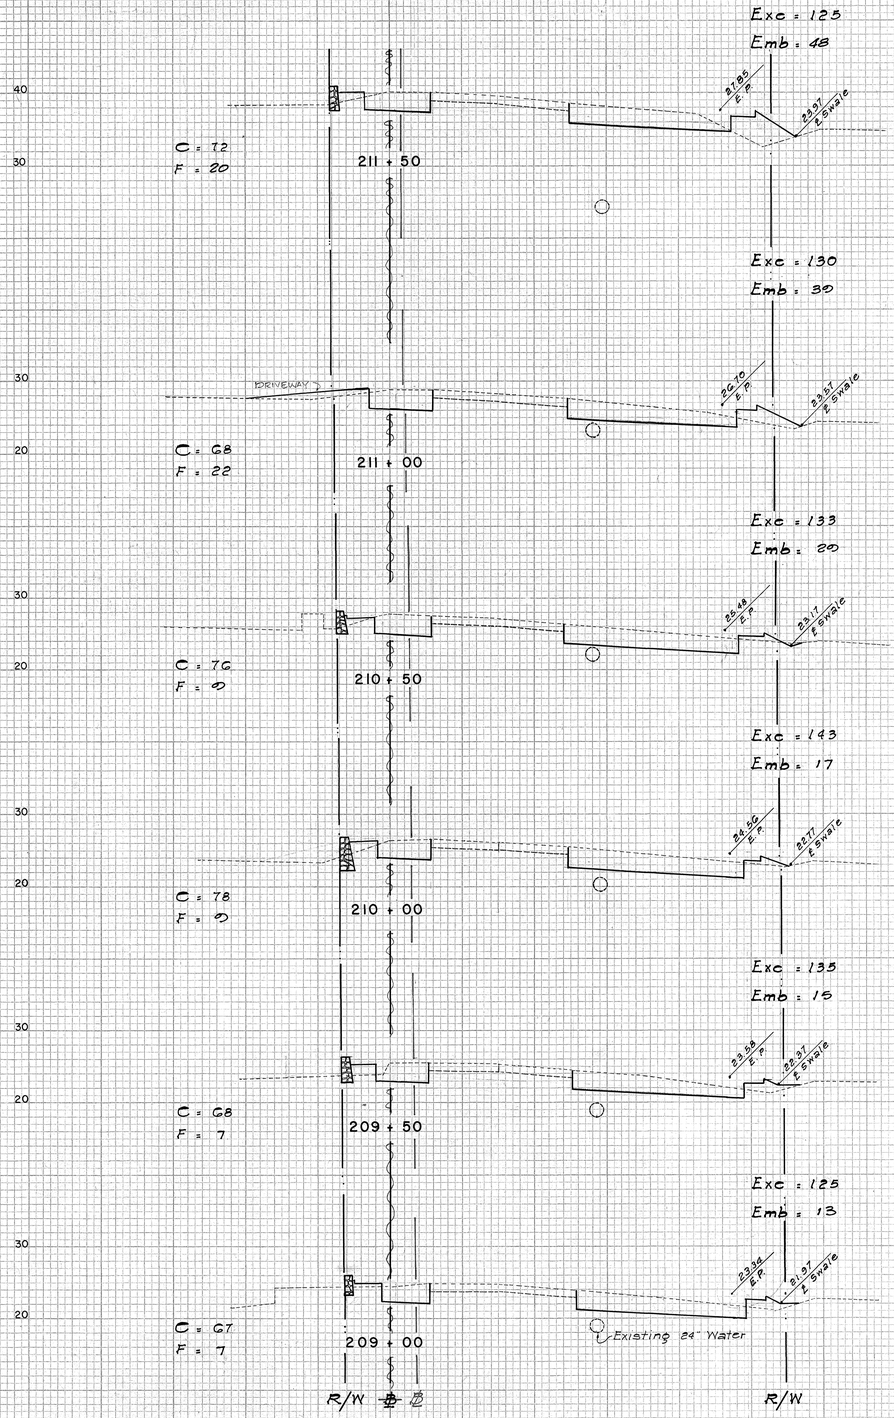

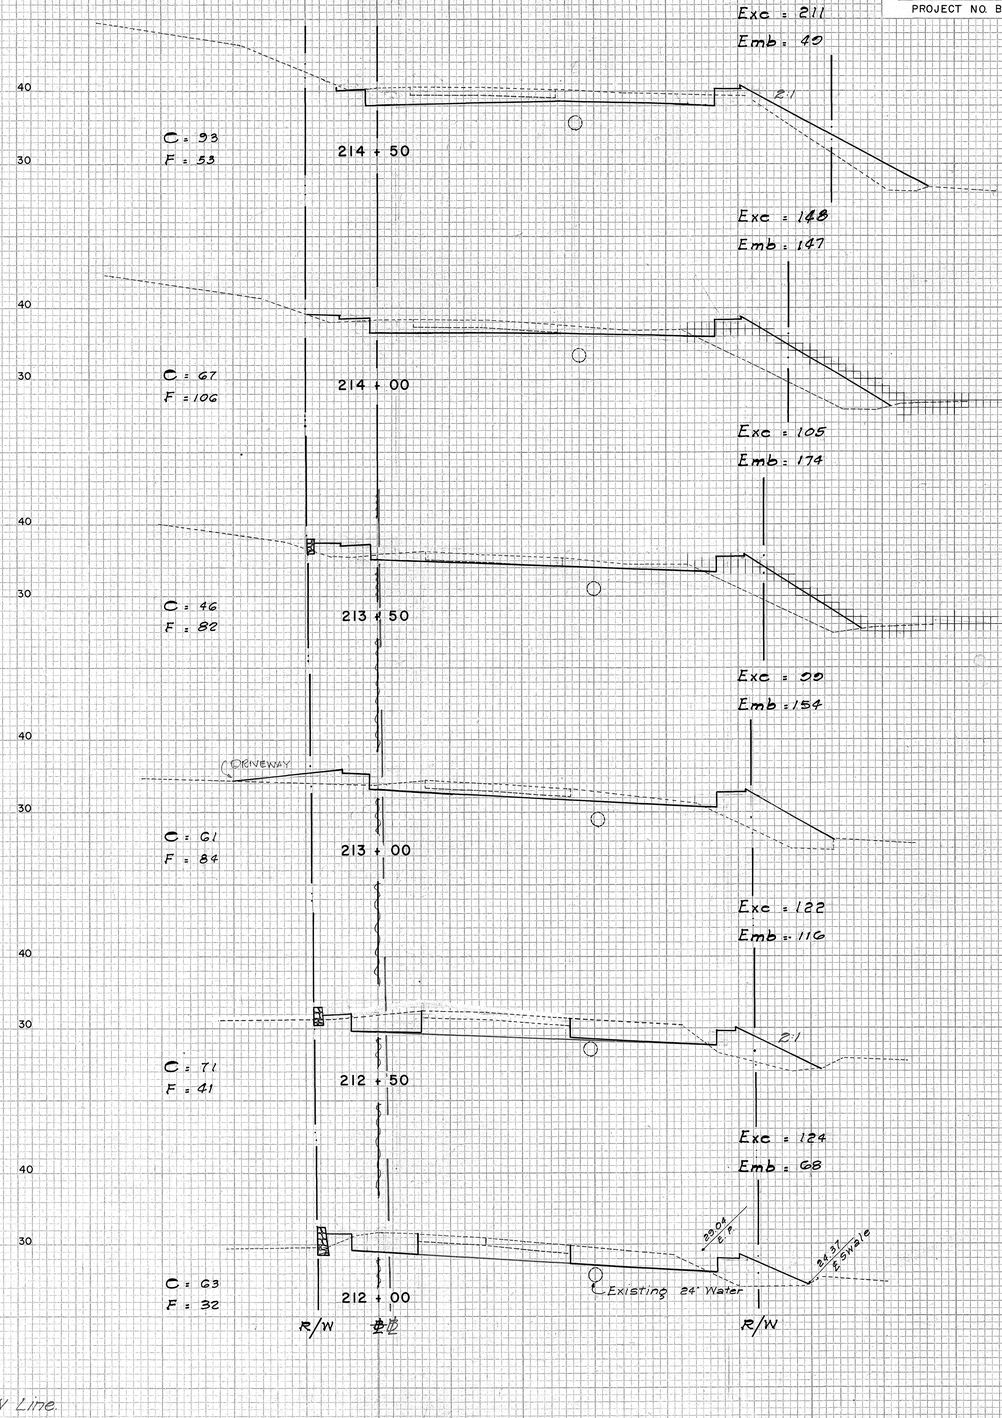

NOTE:
℄ is 10' from R/W Line.

PLATE 3- CROSS SECTION O. P. R. & R. E. STANDARD
KEUFFEL & ESSER CO., NEW YORK.

SHEET No. 5 OF 9 SHEETS

STATE	FISCAL YEAR	SHEET NO.	TOTAL SHTS.
HAWAII	1967	69	76

PROJECT NO. B-900-01-64 UNIT I

FINAL SURVEY — NOTE BOOK NO. — SURVEYED — PLOTTED — TRACED — AREAS — CHECKED — BY — DATE

ORIGINAL SURVEY — NOTE BOOK NO. — SURVEYED — PLOTTED — TRACED — AREAS — CHECKED — BY — DATE

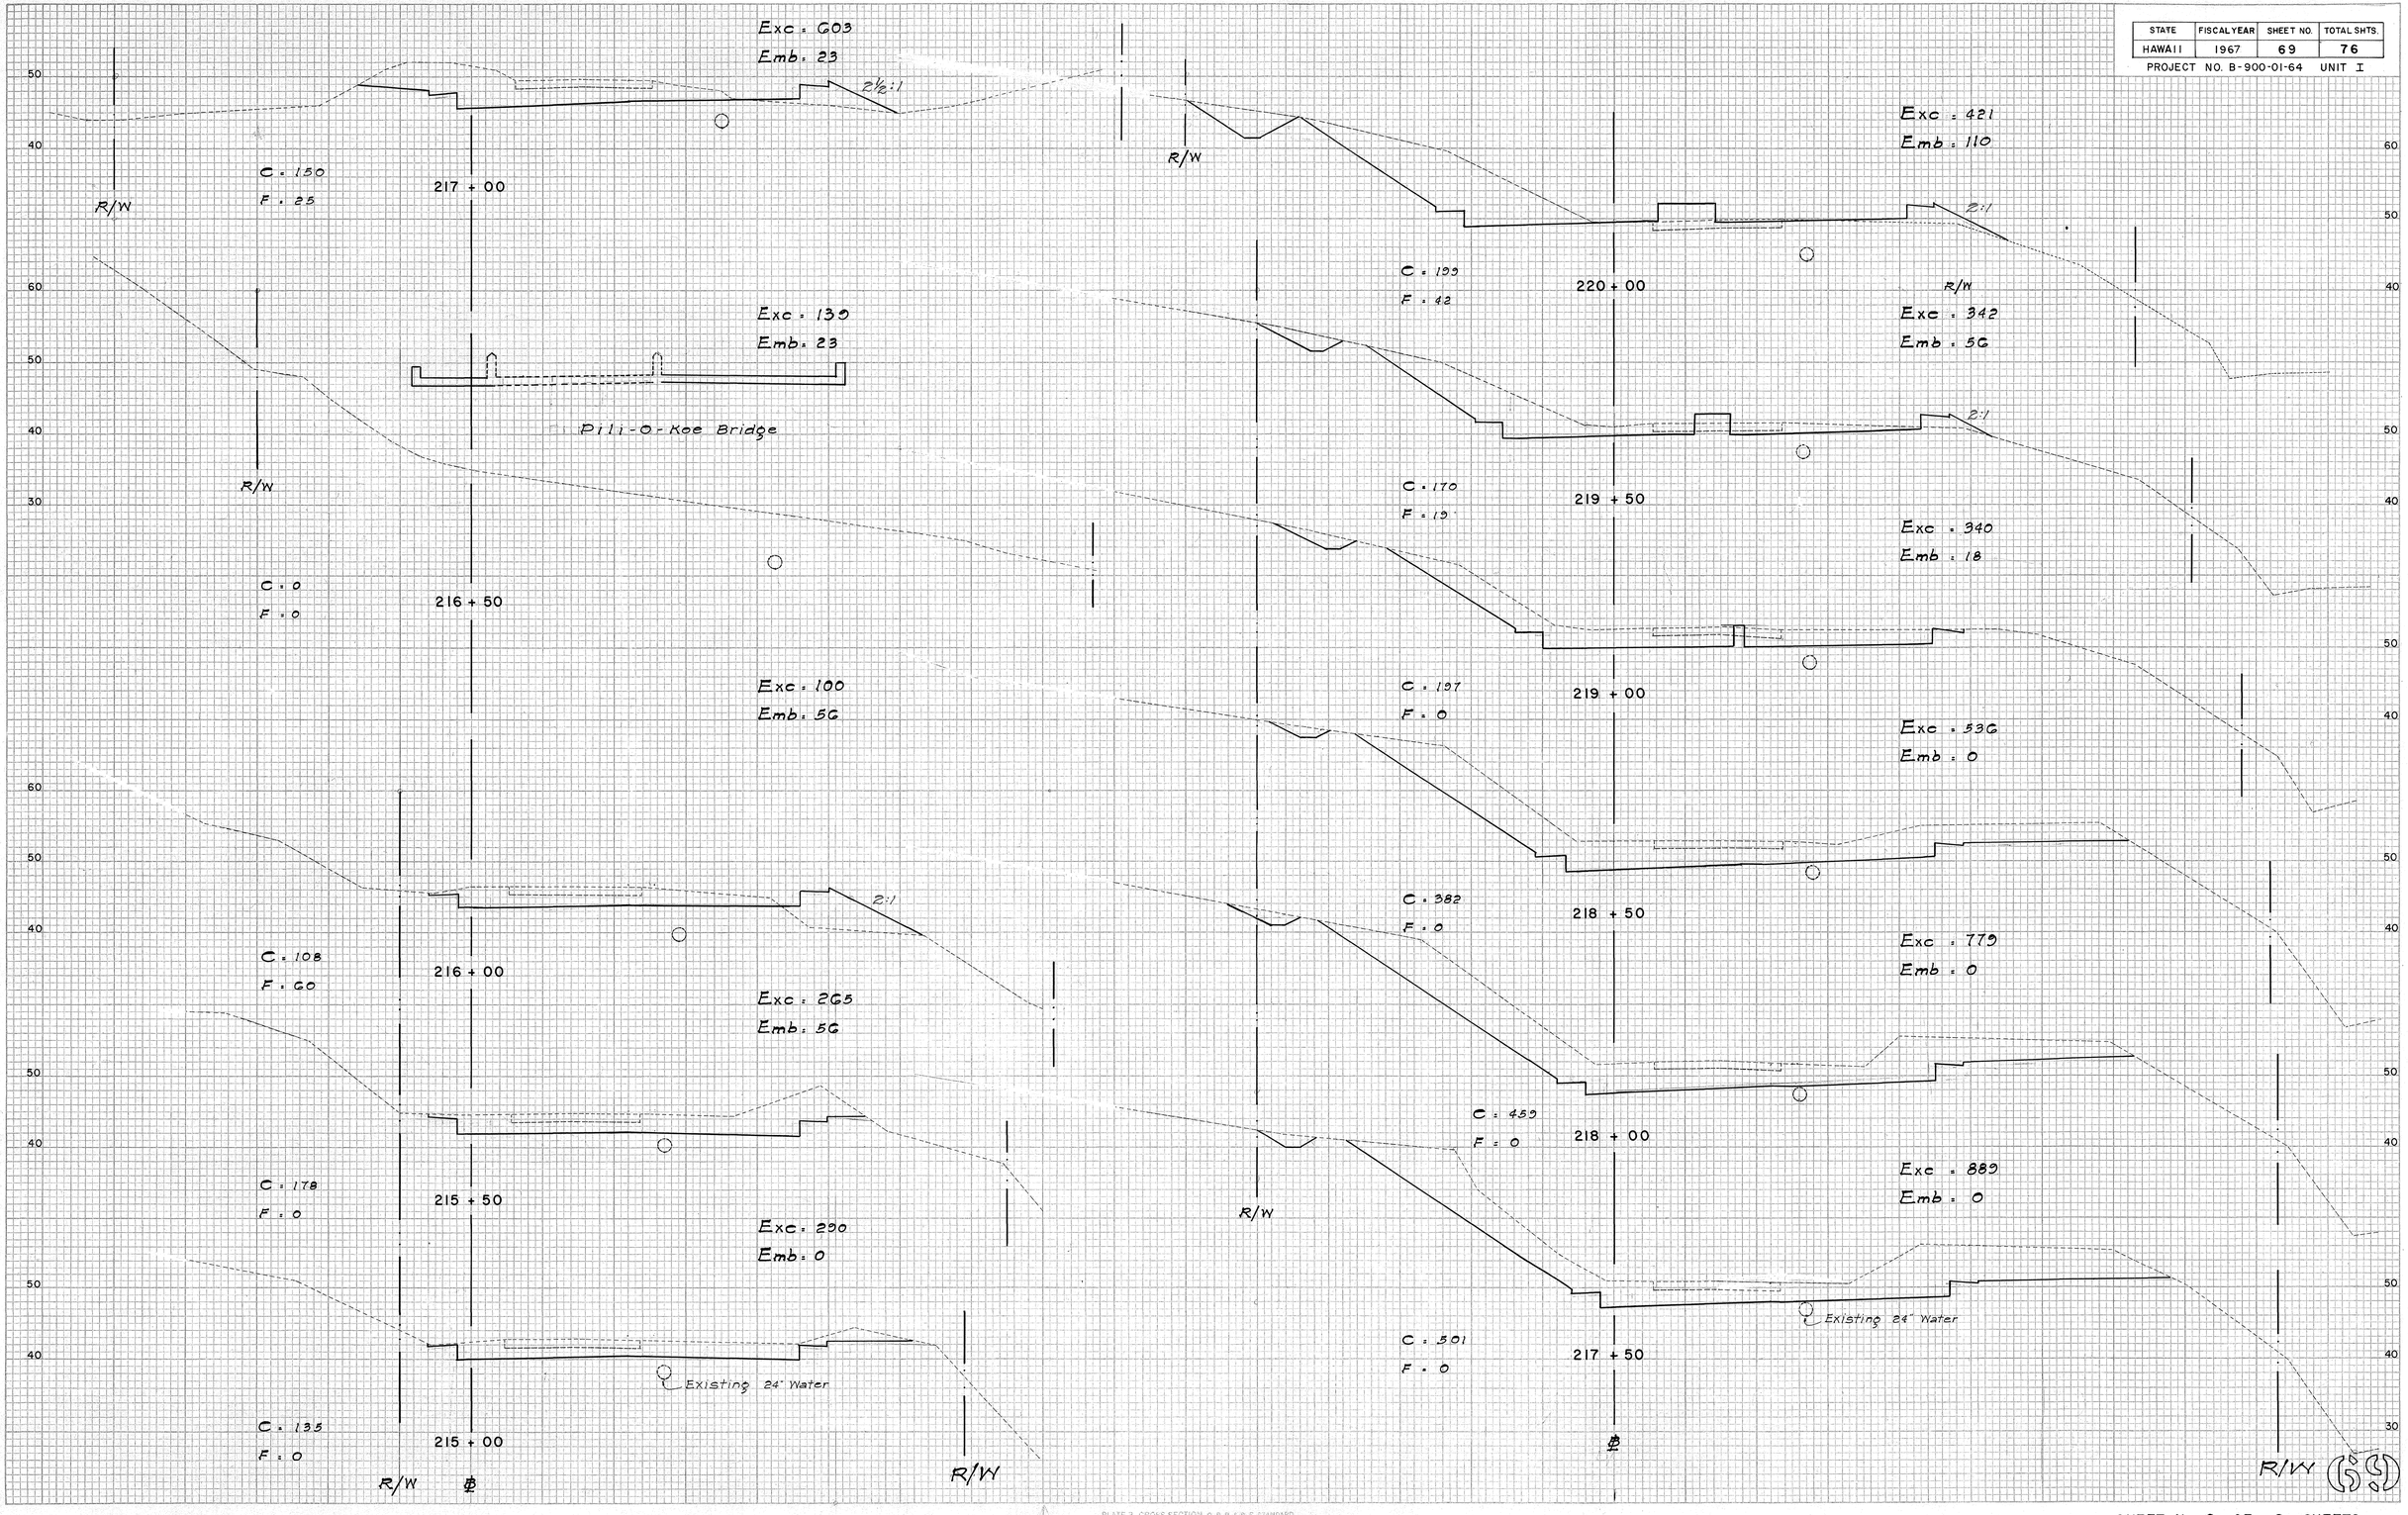


PLATE 3 - CROSS SECTION - O. P. R. & R. E. STANDARD
KEUFFEL & ESSER CO., NEW YORK.

SHEET No. 6 OF 9 SHEETS

STATE	FISCAL YEAR	SHEET NO.	TOTAL SHTS.
HAWAII	1967	70	76

PROJECT NO. B-900-01-64 UNIT I

FINAL SURVEY — NOTE BOOK — NO. — SURVEYED — PLOTTED — TEMPLATE — AREAS — AREAS CHECKED — BY — DATE

ORIGINAL SURVEY — NOTE BOOK — NO. — SURVEYED — PLOTTED — TEMPLATE — AREAS — AREAS CHECKED — BY — DATE

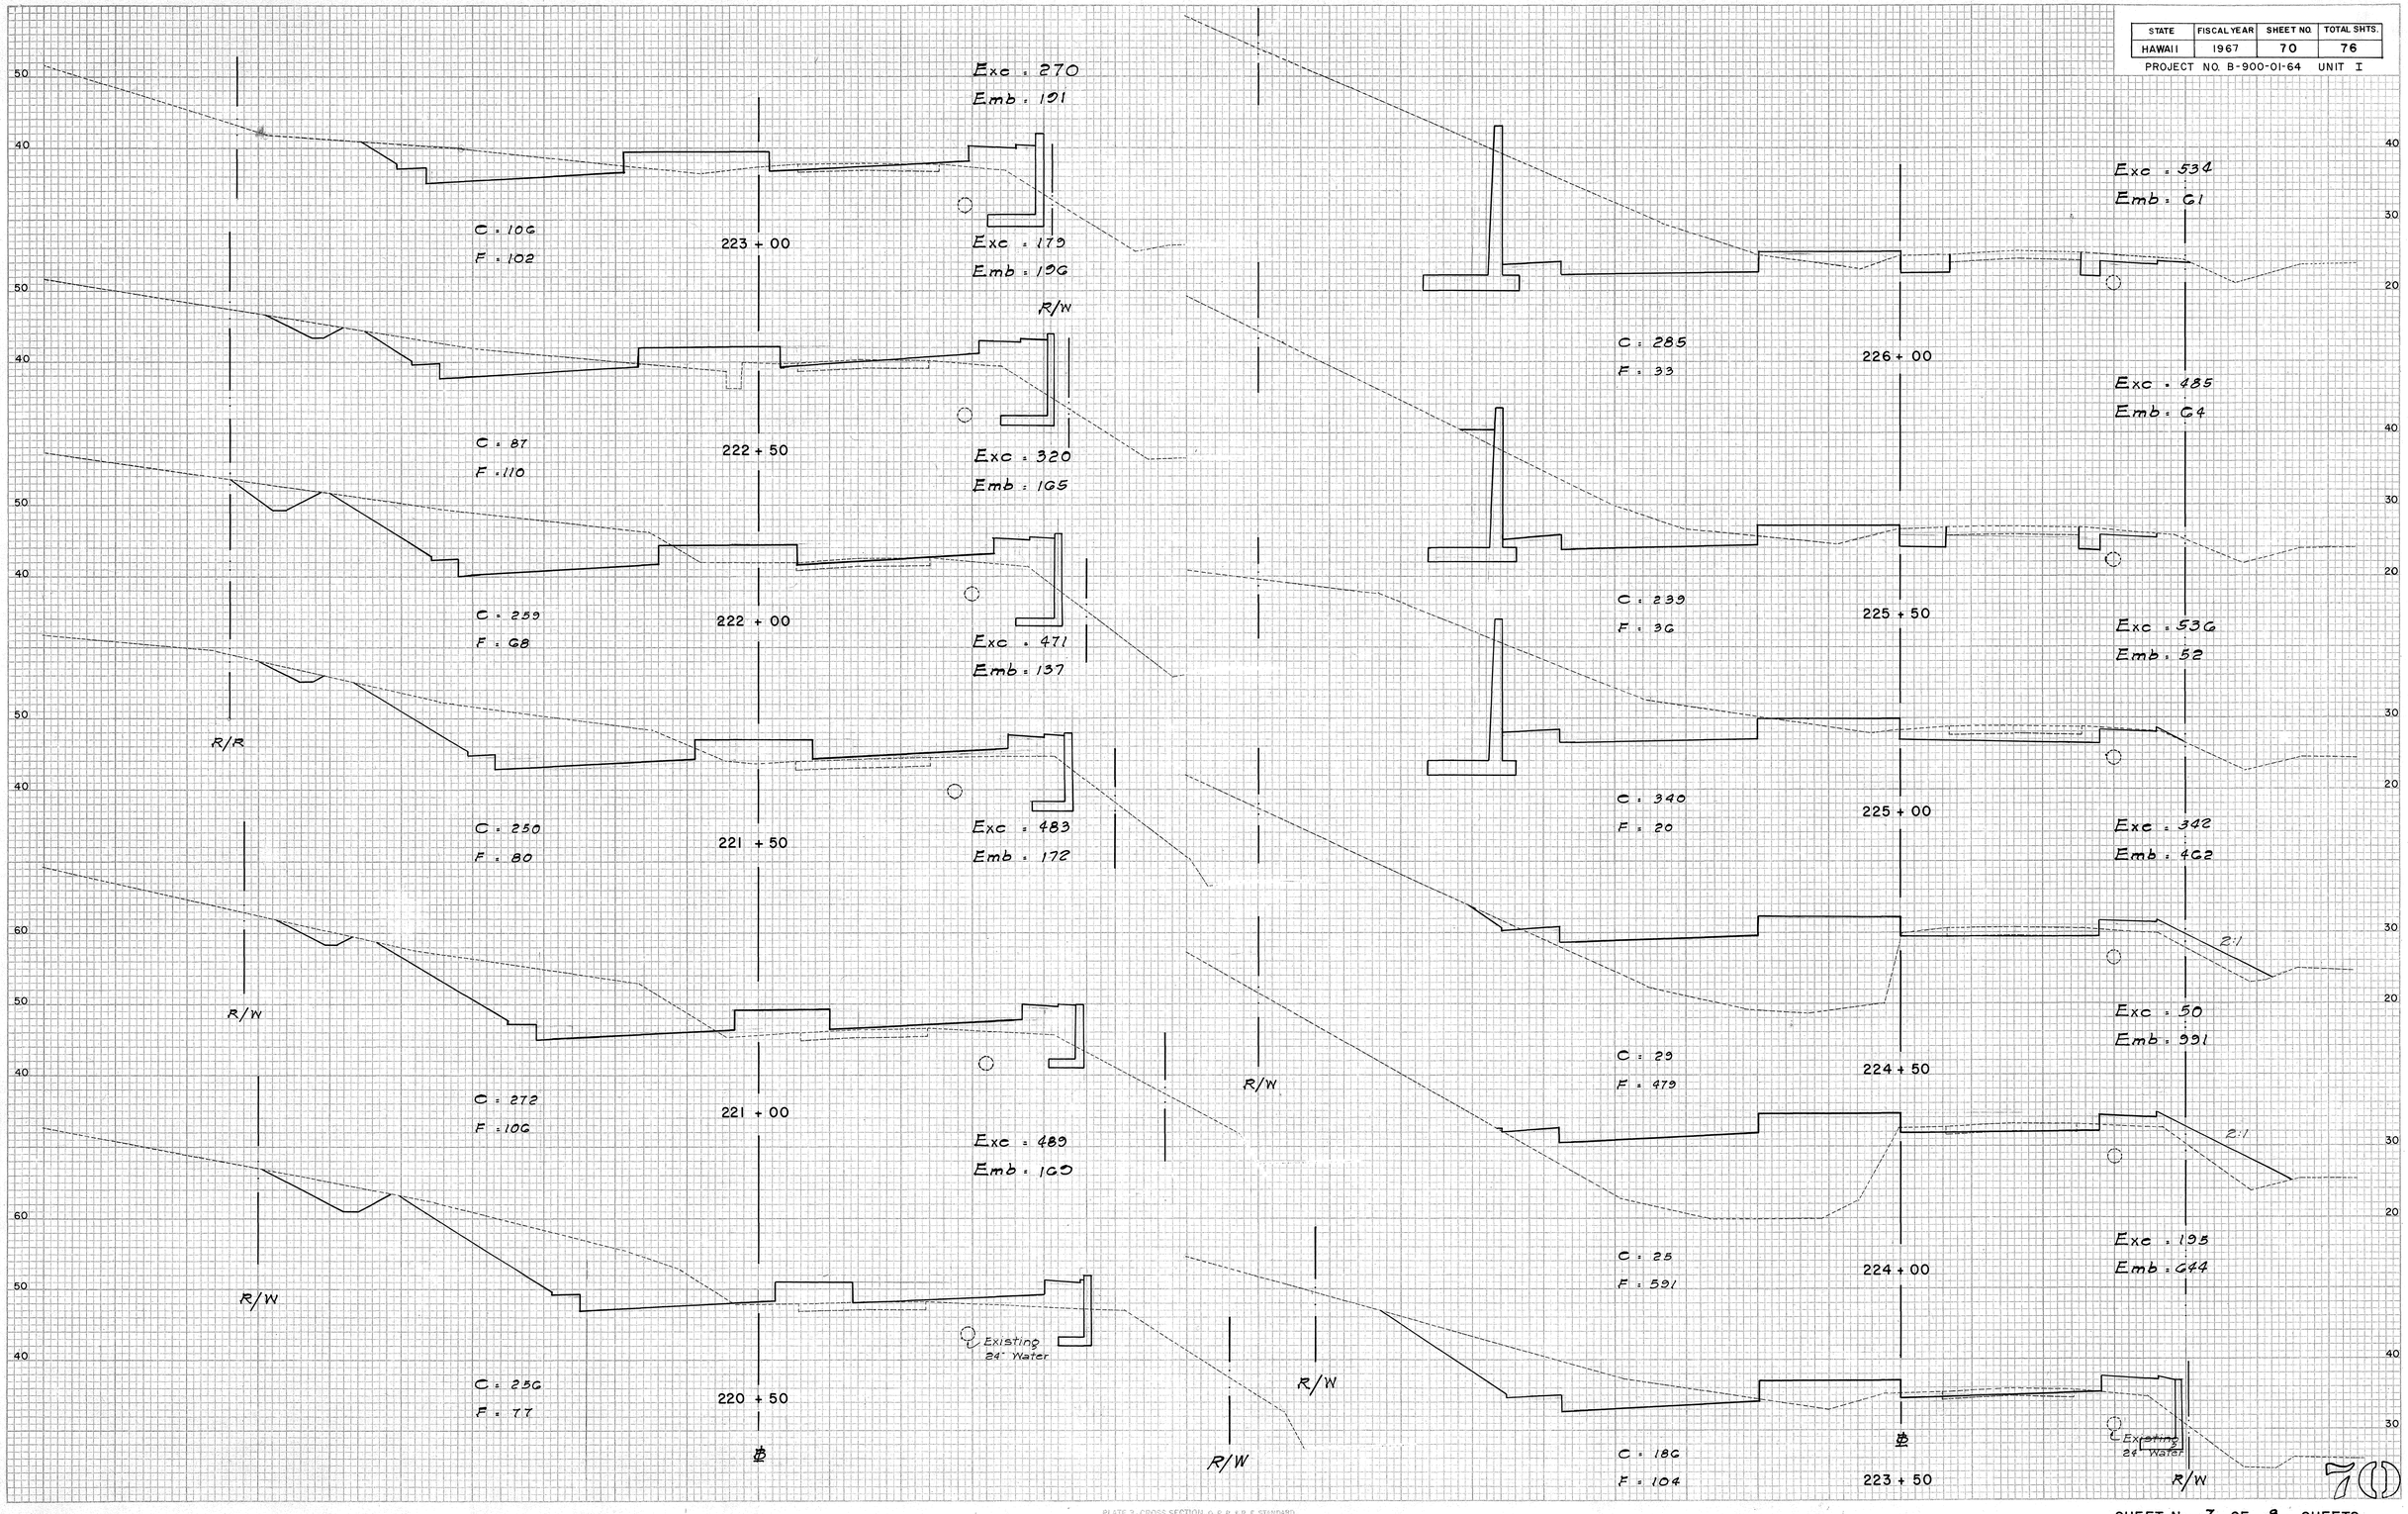


PLATE 3 - CROSS SECTION O. P. R. & P. E. STANDARD
KEUFFEL & ESSER CO., NEW YORK.

SHEET No. 7 OF 9 SHEETS


70


STATE	FISCAL YEAR	SHEET NO.	TOTAL SHTS.
HAWAII	1967	71	76

PROJECT NO. B-900-01-64 UNIT I

FINAL SURVEY — DATE, BY, SURVEYED, PLOTTED, CHECKED, NOTE BOOK, AREAS, AREAS CHECKED, NO.

ORIGINAL SURVEY — DATE, BY, SURVEYED, PLOTTED, CHECKED, NOTE BOOK, AREAS, AREAS CHECKED, NO.

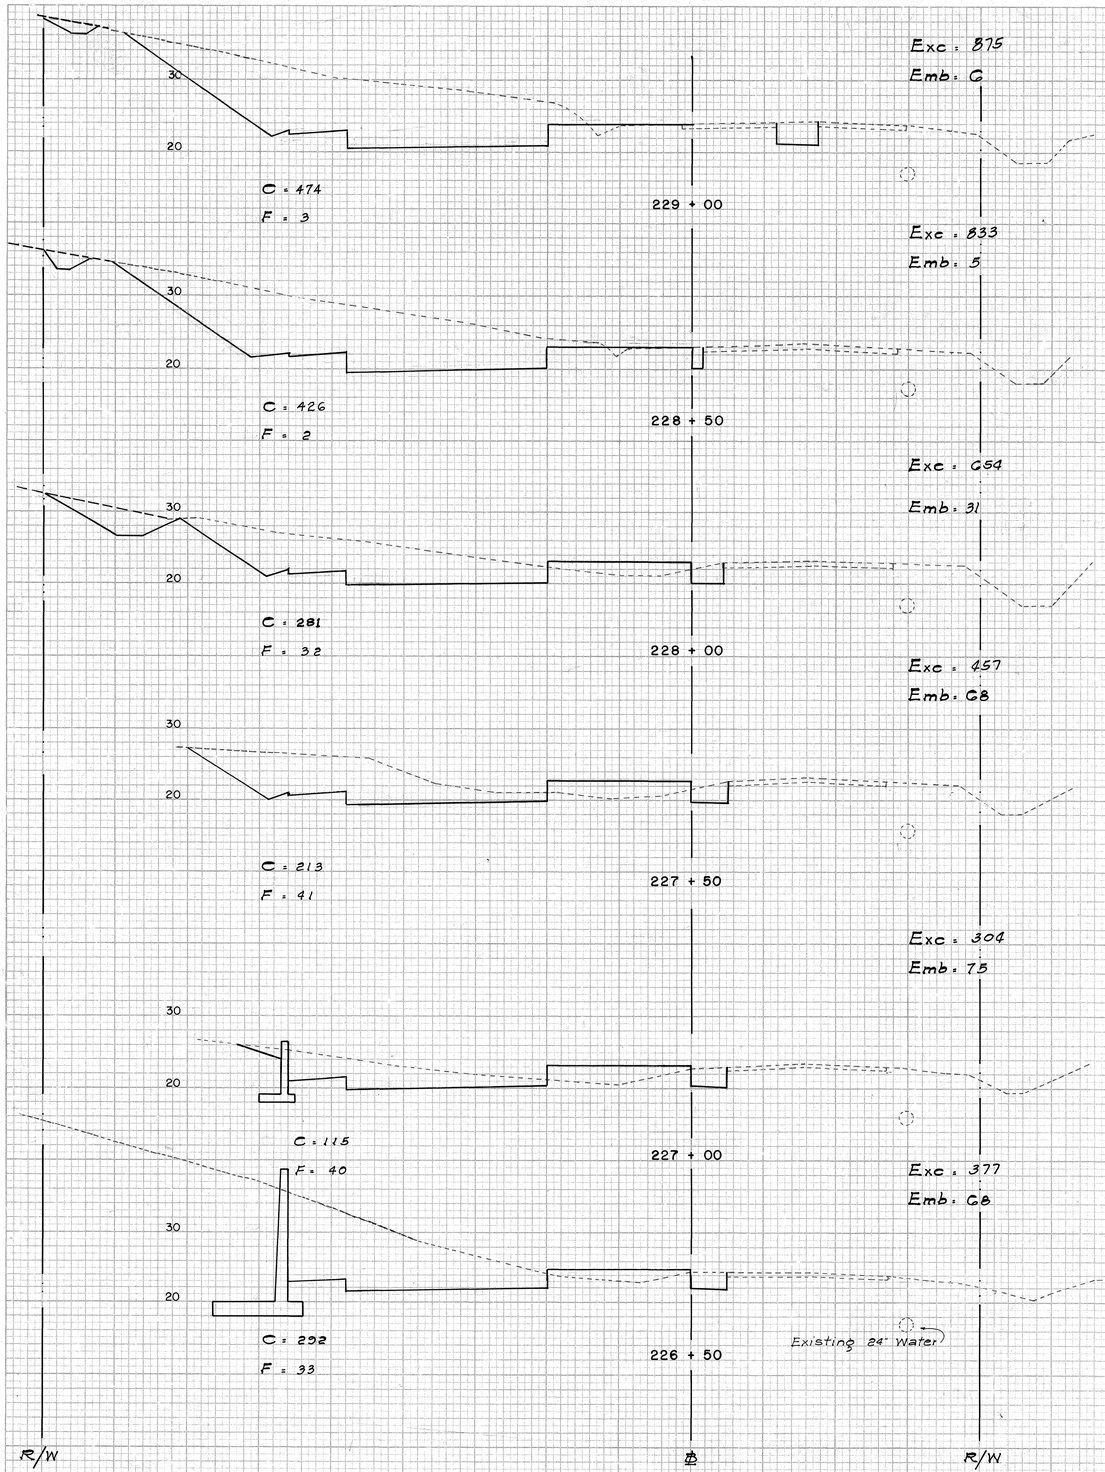

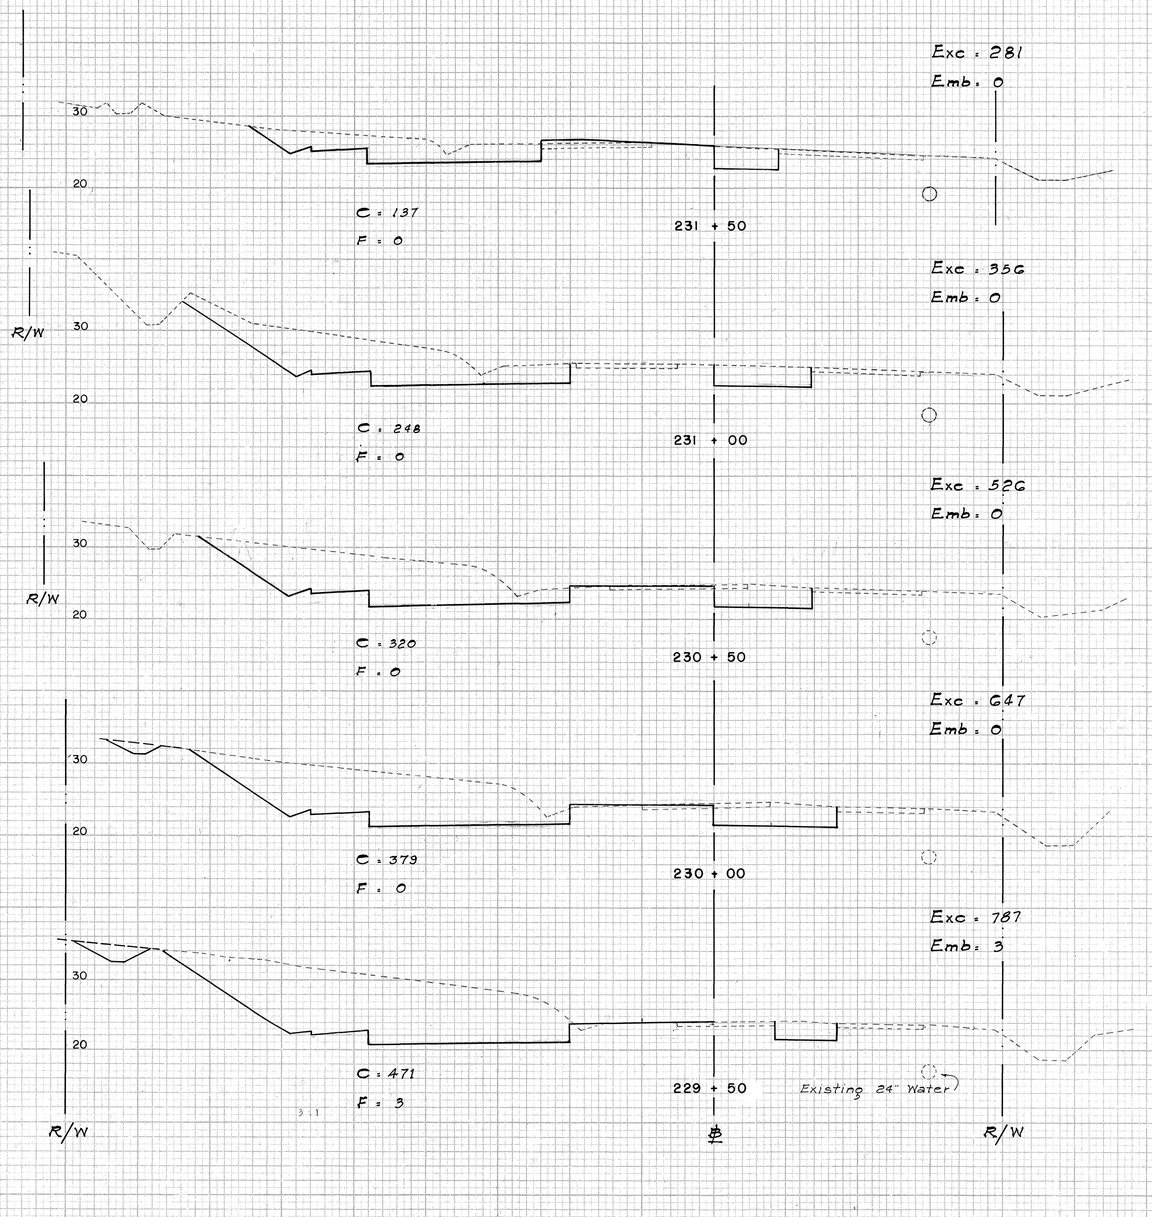

3.1

PLATE 3-CROSS SECTION O. P. R. & R. E. STANDARD
NATIONAL TRACING PAPER DIVISION
I. B. P. I. CO. INC. INDIANAPOLIS, INDIANA

71


SHEET No. 8 OF 9 SHEETS

STATE	FISCAL YEAR	SHEET NO.	TOTAL SHTS.
HAWAII	1967	72	76

PROJECT NO. B-900-01-64 UNIT I

FINAL SURVEY — DATE, BY, SURVEYED, PLOTTED, TEMPLATE, AREAS, AREAS CHECKED, NOTE BOOK, NO

ORIGINAL SURVEY — DATE, BY, SURVEYED, PLOTTED, TEMPLATE, AREAS, AREAS CHECKED, NOTE BOOK, NO

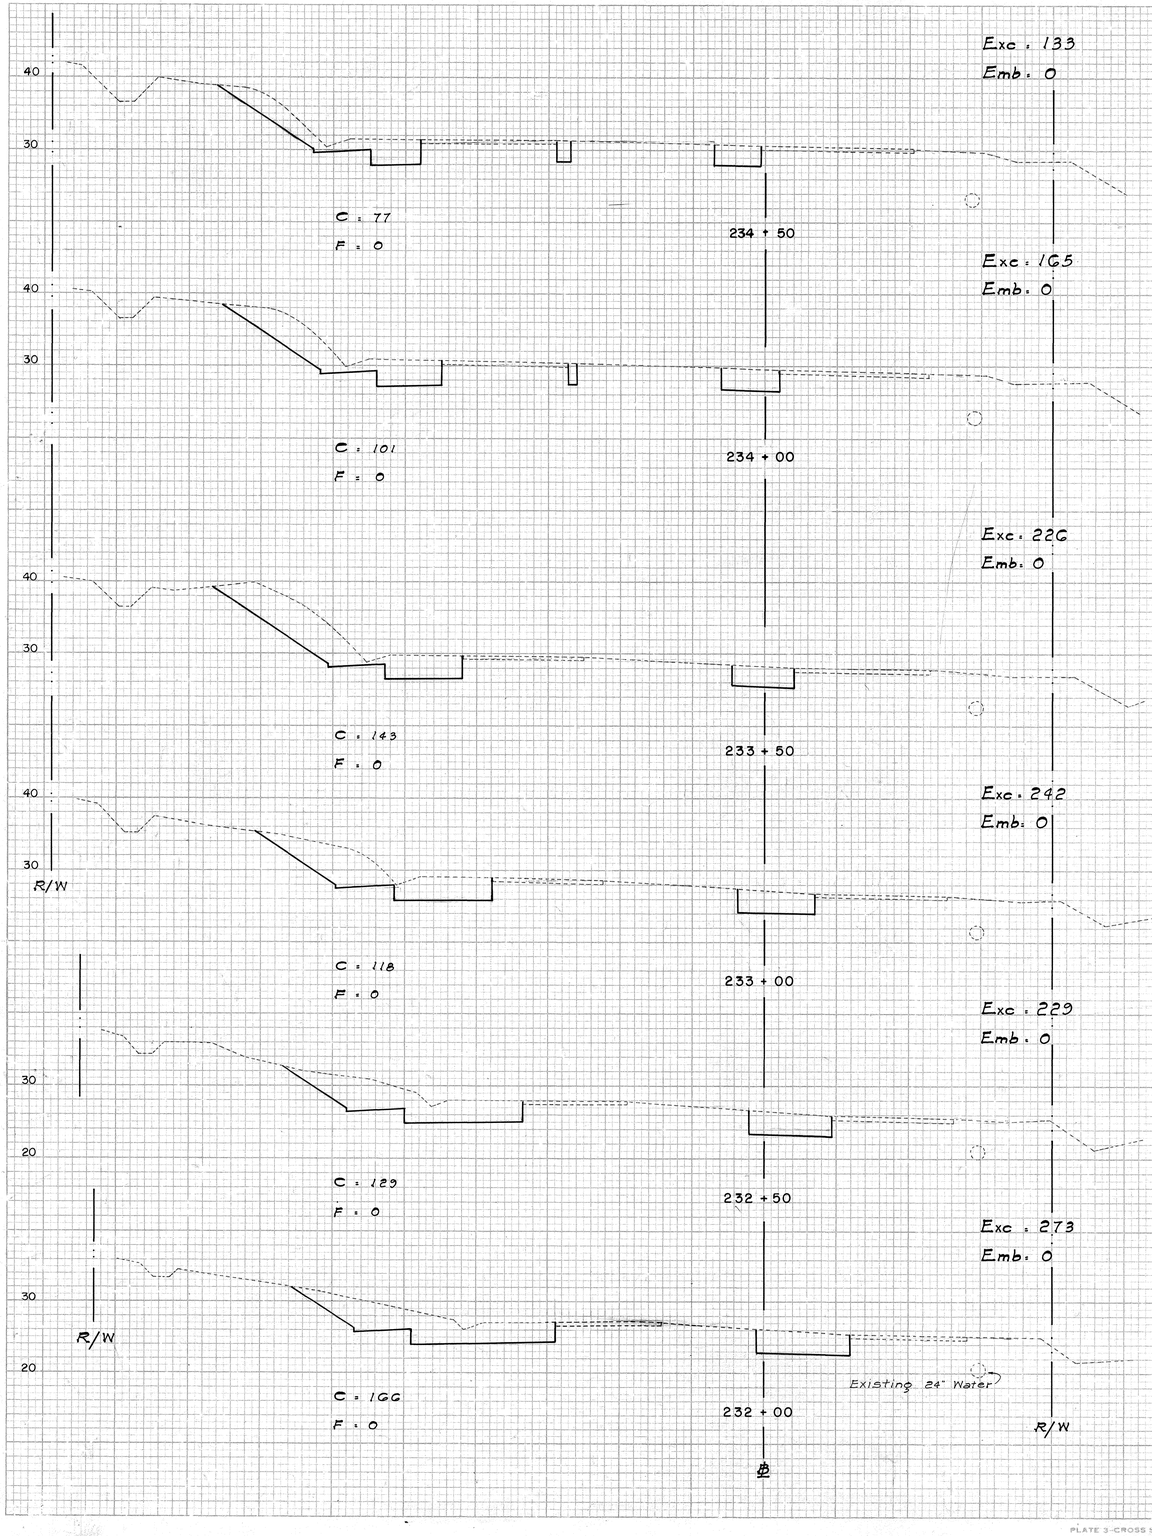

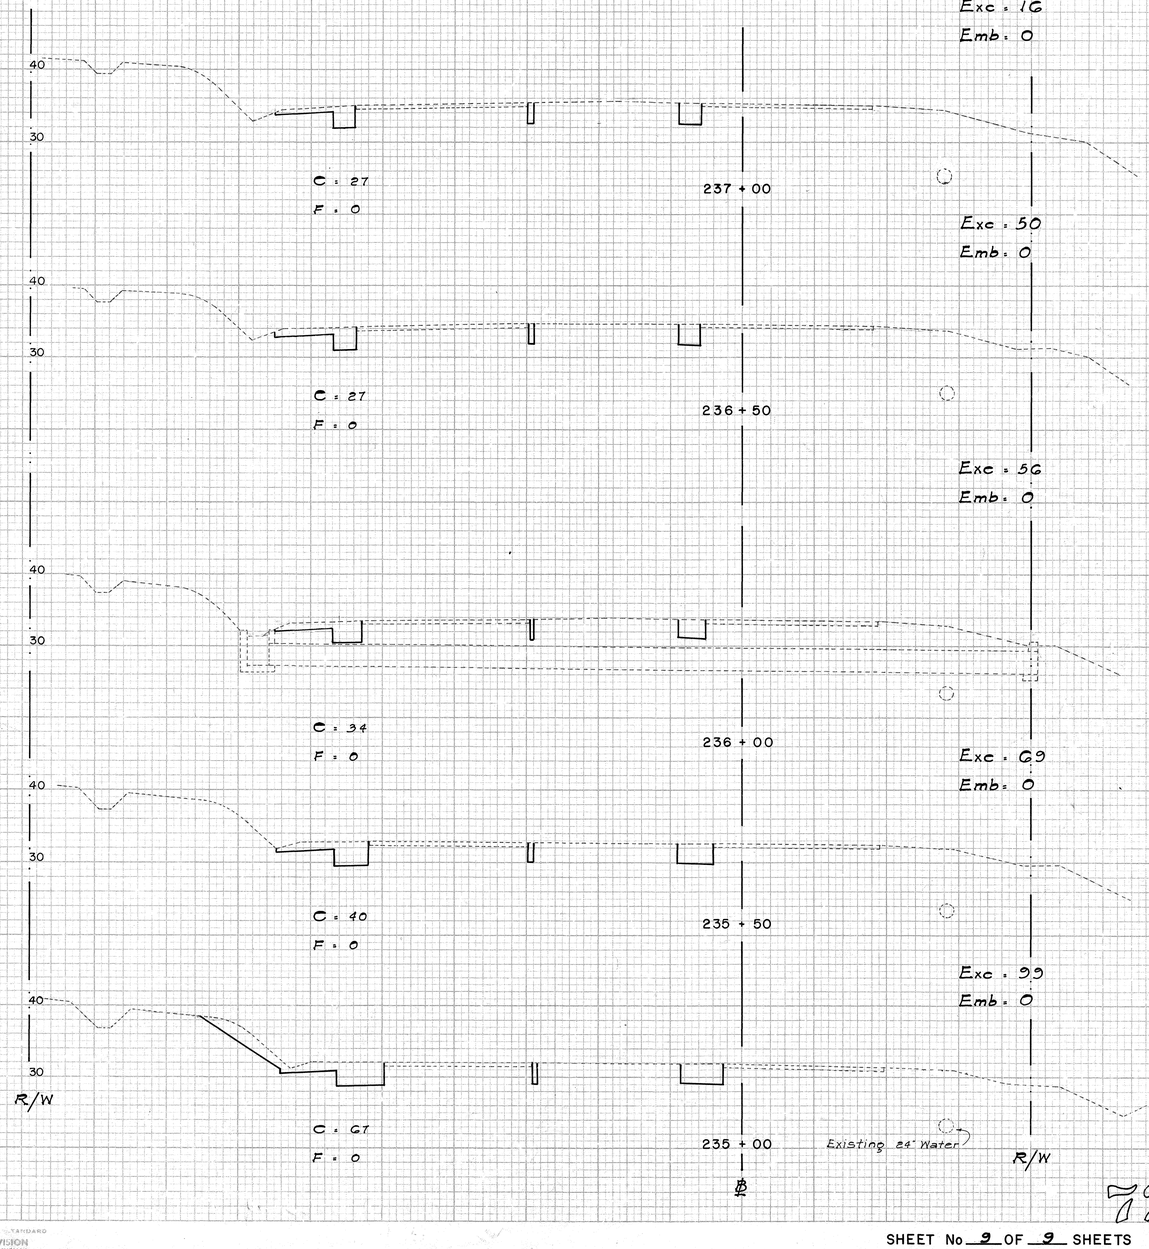


PLATE 3-CROSS SECTION O. P. R. & R. L. STANDARD
NATIONAL TRACING PAPER DIVISION
I. B. P. S. L. CO., INC. INDIANAPOLIS, INDIANA

72

SHEET No 9 OF 9 SHEETS