FED. ROAD DIST. NO.	STATE	PROJ. NO.	FISCAL YEAR	SHEET NO.	TOTAL SHEETS
HAWAII	HAW.	93A-01-78	1977	1	4

INDEX TO DRAWINGS

SHEET NO.	DESCRIPTION
1	TITLE SHEET
2	BUS STOP LIGHTING PLAN
3	BUS STOPS LIGHTING PLAN
4	MISCELLANEOUS DETAILS

STATE OF HAWAII

DEPARTMENT OF TRANSPORTATION

LAND TRANSPORTATION FACILITIES DIVISION

"AS BUILT"

PLANS FOR

FARRINGTON HIGHWAY
STREET LIGHTS AT BUS STOPS
KAHE TO WAIOMEA STREET
PROJECT NO. 93A-01-78

DISTRICT OF EWA

ISLAND OF OAHU

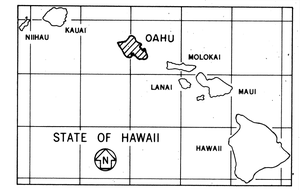

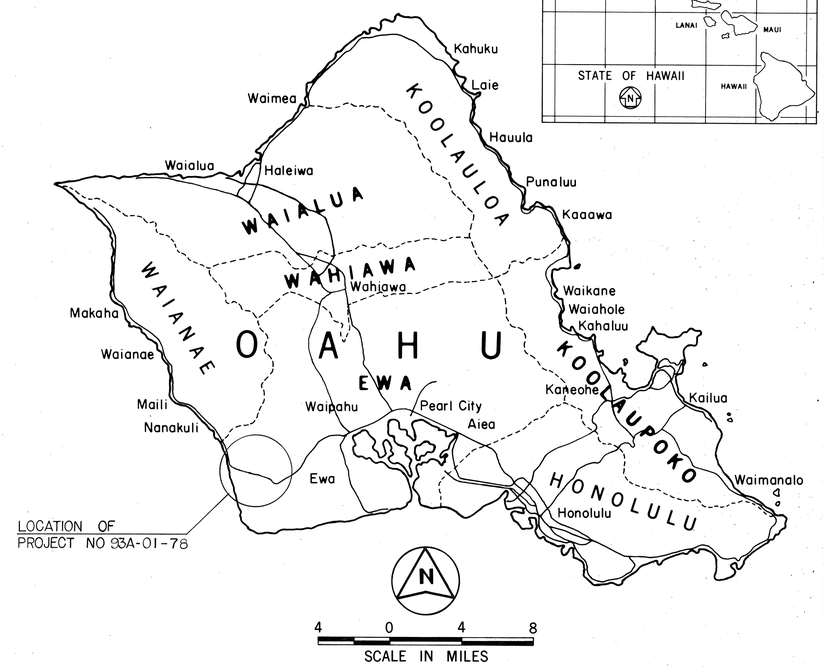

APPROVED:

HAWAIIAN ELECTRIC COMPANY — DATE 10/26/77

HAWAIIAN TELEPHONE COMPANY — DATE 11-9-77

NOTE:

ALL CHANGES MADE DURING CONSTRUCTION HAVE BEEN INCORPORATED ON THESE PLANS IN RED EXCEPT CHANGES IN THE ORIGINAL THEORETICAL QUANTITIES.

PROJECT ENGINEER — DATE 2/27/79

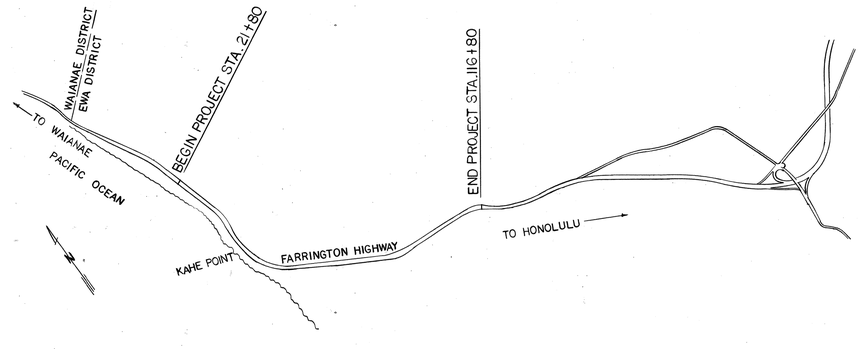

LOCATION MAP

SCALE: 1" = 2000'-0"

DEPARTMENT OF TRANSPORTATION
STATE OF HAWAII

APPROVED:

for R Higashionna — DIR. OF TRANSPORTATION — DATE 11/22/77

ALBERT CHONG ASSOC. — DESIGNED BY

JAMES SUGIHARA P. S. & E. BY — 549-6932 PHONE — NOV. 1977 DATE

6/53-2/22

01-8-0-00