FED. ROAD DIST. NO.	STATE	PROJ. NO.	FISCAL YEAR	SHEET NO.	TOTAL SHEETS
HAWAII	HAW.	93A-01-79	1979	1	13

INDEX TO DRAWINGS	
SHEET NO.	DESCRIPTION
1	TITLE SHEET
2	ROADWAY CONSTRUCTION PLAN
	AND TYPICAL SECTIONS
3	SIGNING AND PAVEMENT
	MARKING PLAN
4-13	STANDARD DETAILS

STATE OF HAWAII

DEPARTMENT OF TRANSPORTATION

LAND TRANSPORTATION FACILITIES DIVISION

HONOLULU, HAWAII

"AS BUILT"

PLANS OF

FARRINGTON HIGHWAY

MEDIAN OPENING AT WAIOMEA STREET, HONOKAI HALE

PROJECT NO. 93A-01-79

DISTRICT OF EWA
ISLAND OF OAHU

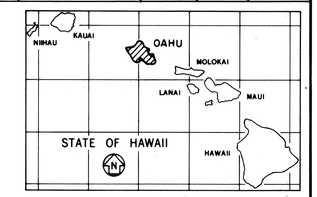

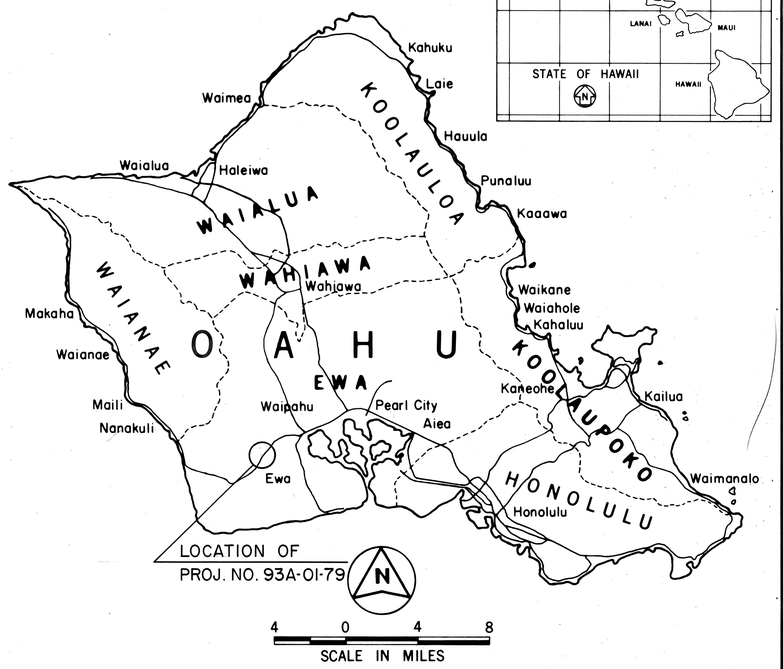

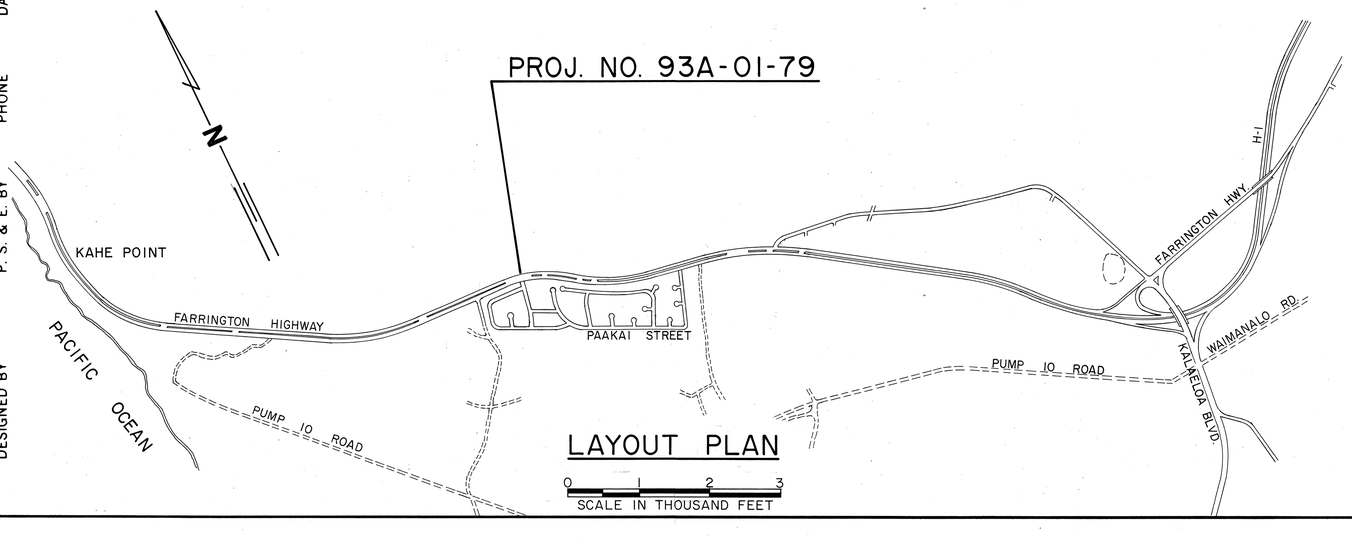

DESIGN UNIT "A" — DESIGNED BY R. MIKAMI — P. S. & E. BY — 548-7534 PHONE — Feb. 21, 1979 DATE

ALL CHANGES MADE DURING CONSTRUCTION HAVE BEEN INCORPORATED ON THESE PLANS EXCEPT CHANGES IN THE ORIGINAL THEORETICAL QUANTITIES

Robert Y. Omai — RESIDENT ENGINEER — 10/15/80 DATE

DEPARTMENT OF TRANSPORTATION
STATE OF HAWAII

APPROVED:

Ryokichi Higashionna — DIR. OF TRANSPORTATION — 2/21/79 DATE

C-8-9