FED. ROAD DIST. NO.	STATE	PROJ. NO.	FISCAL YEAR	SHEET NO.	TOTAL SHEETS
HAWAII	HAW.	HWY-0-02-82M	1982	1	3

INDEX TO DRAWINGS

SHEET NO.	DESCRIPTION
1	TITLE SHEET, LOCATION MAP & GENERAL NOTES
2÷3	STANDARD DETAILS

STATE OF HAWAII

DEPARTMENT OF TRANSPORTATION

HONOLULU, HAWAII

"AS BUILT"

PLANS FOR

FARRINGTON HIGHWAY

Termite Treatment of Various Wooden Bridges, Makaha to Makua

PROJECT NO. HWY-0-02-82M

DISTRICT OF WAIANAE
ISLAND OF OAHU

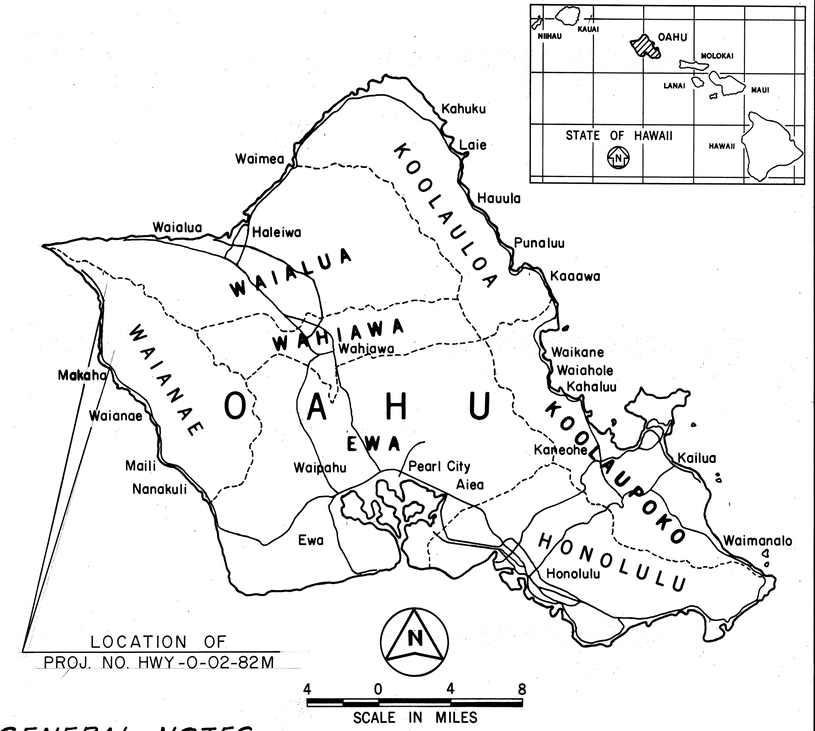

PROJECT NO. HWY-0-02-82M

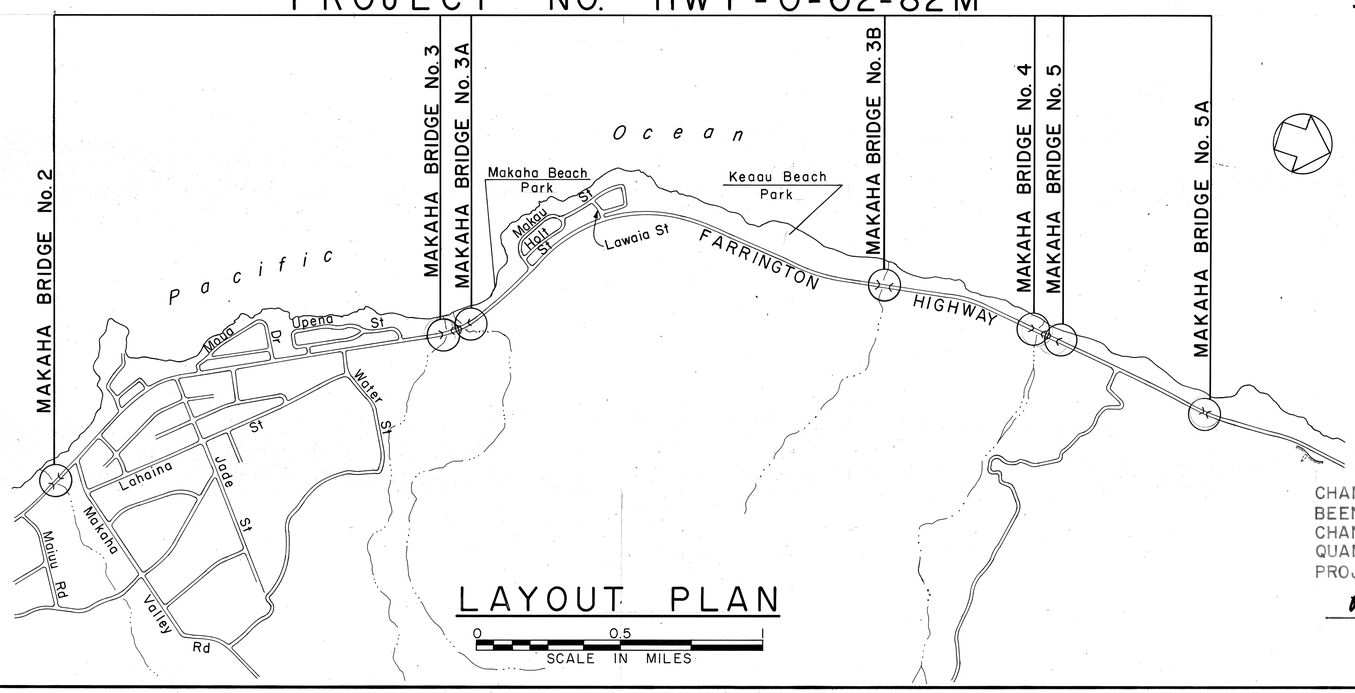

LAYOUT PLAN

GENERAL NOTES:

1. The project consists of preservative termite treatment with ~~PE~~ PI Creosote Oil to seven timber bridges on Farrington Highway, Makaha to Makua. Ground treatment will not be required.
2. The Contractor shall be a licensed pest control applicator under the Hawaii Pesticide Law.
3. All debris, empty crates, waste, material drippings, etc. shall be removed by the Contractor at the end of each work day, and the grounds below the timber structures shall be left clean.
4. No supply of pest material or equipment shall be kept at the site when the Contractor is not at the site.
5. The Contractor shall furnish a written unconditional guarantee to the Engineer certifying that the treatment will prevent reinfestation by termites for a period of five (5) years from the date of acceptance of the work by the State. If termite infestation should occur to the treated areas within the five year guarantee period, the Contractor shall re-treat the infestations without cost to the State. The warranty shall be provided before Final payment is made.

CHANGES MADE DURING CONSTRUCTION HAVE BEEN INCORPORATED ON THESE PLANS EXCEPT CHANGES IN THE ORIGINAL THEORETICAL QUANTITIES. FOR ACTUAL QUANTITIES, REFER TO PROJECT LEDGER AND/OR COMPUTATION BOOK.

Robert Y. Omai — 8/22/83
ROBERT Y. OMAI — DATE
RESIDENT ENGINEER

DEPARTMENT OF TRANSPORTATION
STATE OF HAWAII
APPROVED:
James R. Carras — 5/26/82
DIR. OF TRANSPORTATION — DATE

Unit "E" — DESIGNED BY
A. Yamaguchi — P. S. & E. BY
548-4125 — PHONE
May, 1982 — DATE

D-8-10