FED. ROAD DIST. NO.	STATE	FED. AID PROJ. NO.	FISCAL YEAR	SHEET NO.	TOTAL SHEETS
HAWAII	HAW.	F-093-1(6)	1983	1	51

INDEX TO DRAWINGS

SHEET NO.	DESCRIPTION
1	TITLE SHEET
2 - 6	GENERAL NOTES, TYPICAL SECTIONS, SCHEDULE & MISC. DETAILS
7 - 14	PLANS
15 - 19	DRAINAGE DETAILS
20 - 21	HIGHWAY LIGHTING TYPICAL DETAILS
22 - 24	GUARD RAIL CONNECTION DETAILS
25 - 30	GUARD RAIL STANDARD DETAILS
31 - 51	SIGNING & PAVEMENT MARKING PLANS AND DETAILS

STATE OF HAWAII

DEPARTMENT OF TRANSPORTATION

HIGHWAYS DIVISION

HONOLULU HAWAII

"AS-BUILT"

PLANS FOR

FARRINGTON HIGHWAY RESURFACING

VICINITY OF PILIOKOE BRIDGE TOWARDS PALAILAI INTERCHANGE

FEDERAL AID PROJECT NO. F-093-1(6)

DISTRICT OF EWA

ISLAND OF OAHU

CHANGES MADE DURING CONSTRUCTION HAVE BEEN INCORPORATED ON THESE PLANS EXCEPT CHANGES IN THE ORIGINAL THEORETICAL QUANTITIES. FOR ACTUAL QUANTITIES, REFER TO PROJECT LEDGER AND/OR COMPUTATION BOOK.

Robert Y. Omai — RESIDENT ENGINEER — 6/28/84 DATE

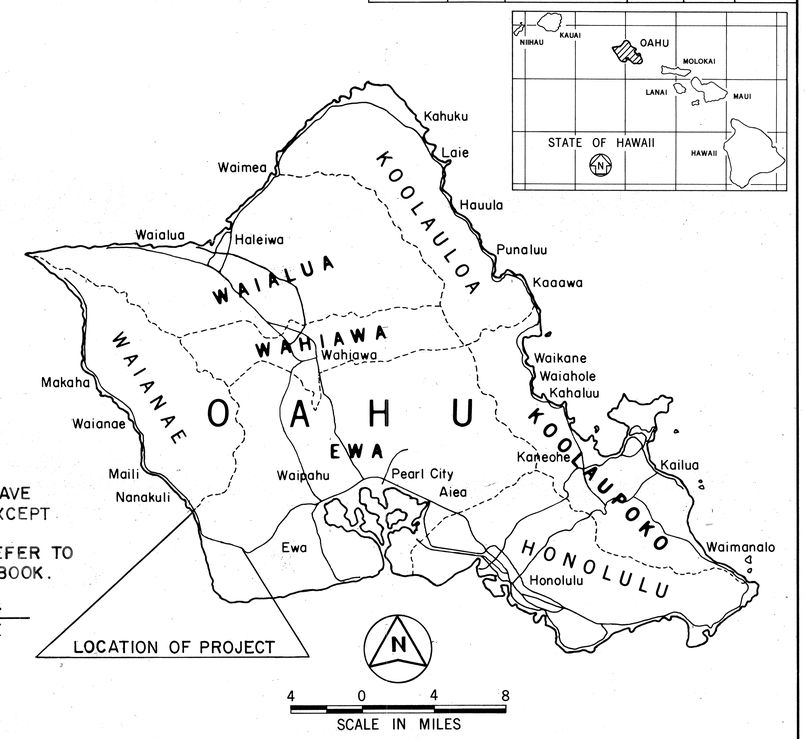

NOTE:

WHEREVER THE PROJECT NUMBER FR-093-1(6) APPEARS IN THESE PLANS, IT SHALL BE AMENDED TO READ F-093-1(6).

DATE: 5-16-83

FARRINGTON HIGHWAY RESURFACING

FED. AID PROJECT NO. F-093-1(6)

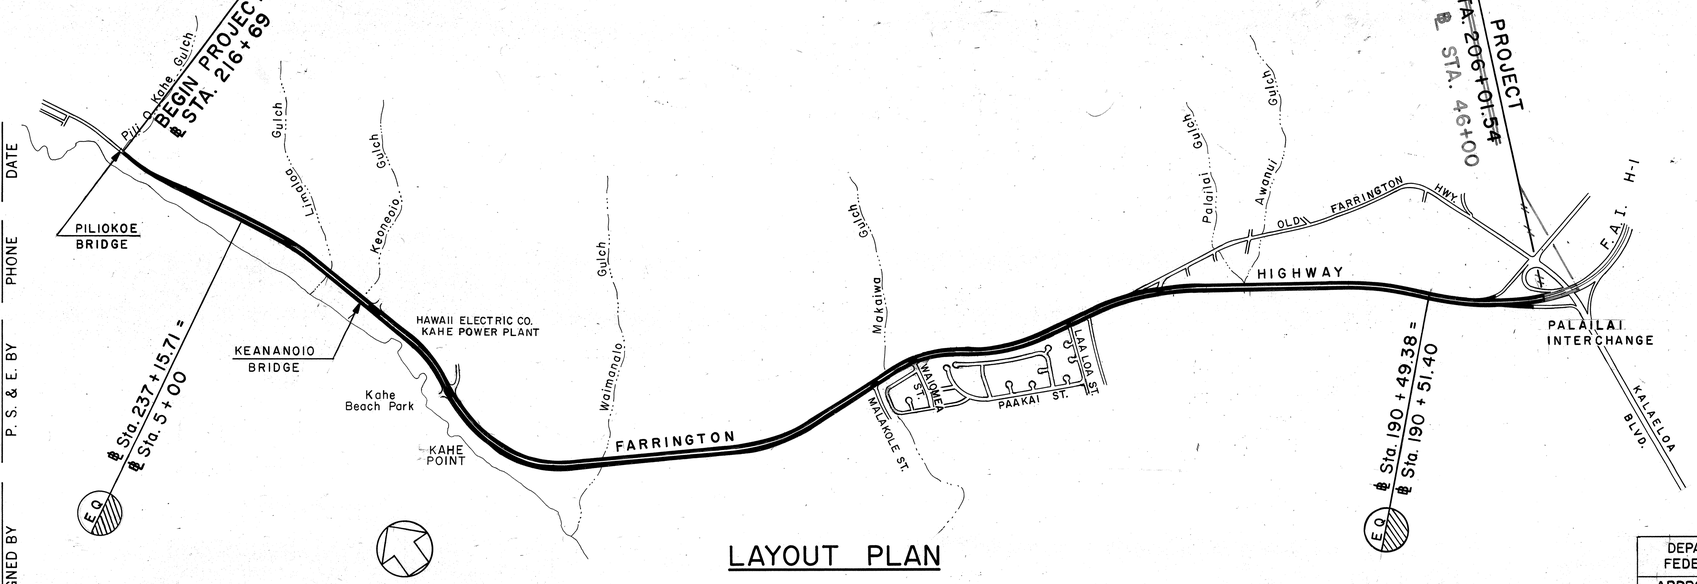

LAYOUT PLAN

GROSS LENGTH OF PROJECT	~~4.212~~ 4.307 MI.
LENGTH OF STRUCTURE	0.012 MI.
NET LENGTH OF ROADWAY	~~4.200~~ 4.295 MI.

DESIGN DESIGNATION

ADT (1982)	21,000
DESIGN ADT (1992)	27,000
DHV	2,970
D	65/35
T	4.0%
V	60 MPH

DEPARTMENT OF TRANSPORTATION
FEDERAL HIGHWAY ADMINISTRATION

APPROVED: 5-16-83

DIVISION ADMINISTRATOR — DATE

DEPARTMENT OF TRANSPORTATION
STATE OF HAWAII

APPROVED: R Higashionna — May 11, 83

DIR. OF TRANSPORTATION — DATE

A. NISHIMURA	DESIGNED BY
A. NISHIMURA	P. S. & E. BY
548-7490	PHONE
MAY 1983	DATE