FED. ROAD DIST. NO.	STATE	FED. AID PROJ. NO.	FISCAL YEAR	SHEET NO.	TOTAL SHEETS
HAWAII	HAW.	F-093-1(7)	1984	1	39

INDEX TO DRAWINGS

SHEET NO.	DESCRIPTION
1	TITLE SHEET
2 – 5	GENERAL NOTES, TRAFFIC SECTIONS AND MISC. DETAILS
6 – 10	PLANS
11 – 12	ROADWAY STANDARD DETAILS
13 – 18	GUARD RAIL CONNECTION PLANS AND DETAILS
19 – 23	GUARD RAIL STANDARD DETAILS
24 – 39	SIGNING, STRIPING, PAVEMENT MARKING AND WHEEL CHAIR RAMP PLANS AND DETAILS

STATE OF HAWAII

DEPARTMENT OF TRANSPORTATION

HIGHWAYS DIVISION

HONOLULU, HAWAII

"AS-BUILT"

PLANS FOR

FARRINGTON HIGHWAY RESURFACING

VICINITY OF ULEHAWA STREAM BRIDGE TOWARDS PILIOKOE BRIDGE

FEDERAL AID PROJECT NO. F-093-1(7)

DISTRICT OF EWA
ISLAND OF OAHU

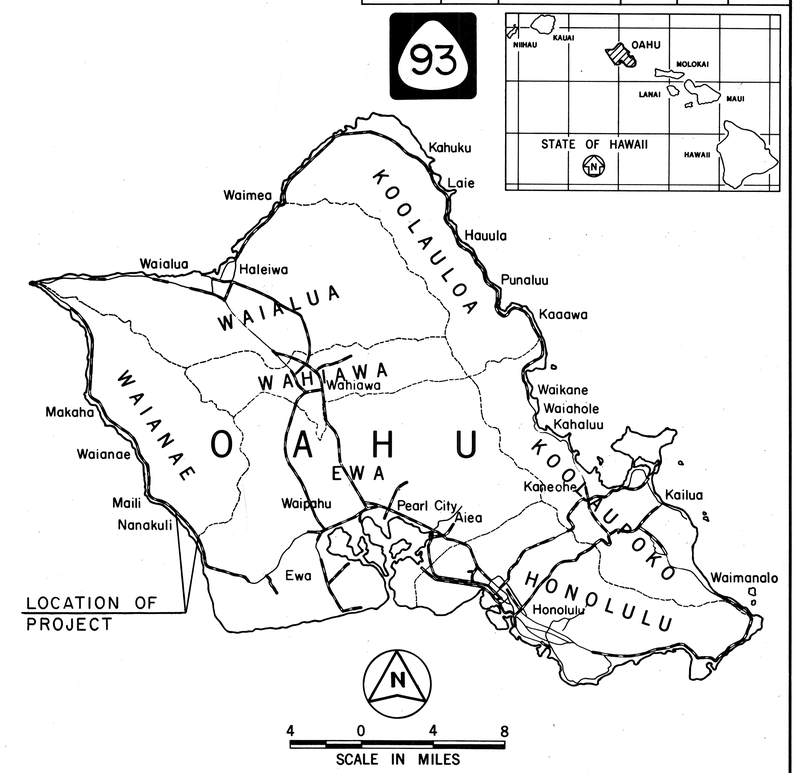

FEDERAL AID PROJECTS PREVIOUSLY CONSTRUCTED OR UNDER CONSTRUCTION

CHANGES MADE DURING CONSTRUCTION HAVE BEEN INCORPORATED ON THESE PLANS EXCEPT CHANGES IN THE ORIGINAL THEORETICAL QUANTITIES. FOR ACTUAL QUANTITIES, REFER TO PROJECT LEDGER AND/OR COMPUTATION BOOK.

Robert T. Kuki
for RESIDENT ENGINEER — 8-26-85 DATE

DESIGN DESIGNATION

ADT (1983)	24,450
DESIGN ADT (1995)	30,850
DHV	2,620
D	60/40
T	4.0%
V	50 MPH

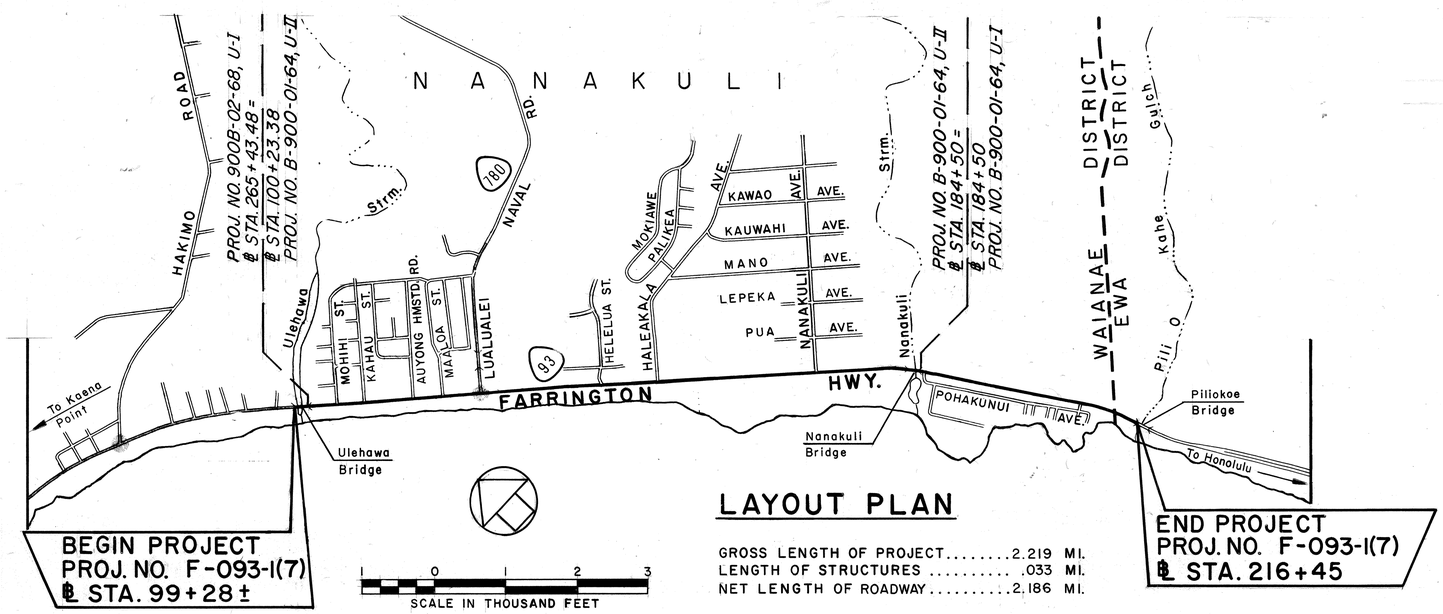

LAYOUT PLAN

GROSS LENGTH OF PROJECT	2.219 MI.
LENGTH OF STRUCTURES	.033 MI.
NET LENGTH OF ROADWAY	2.186 MI.

DEPARTMENT OF TRANSPORTATION FEDERAL HIGHWAY ADMINISTRATION	
APPROVED:	
DIVISION ADMINISTRATOR	5-7-84 DATE

DEPARTMENT OF TRANSPORTATION STATE OF HAWAII	
APPROVED:	
for DIR. OF TRANSPORTATION	3/28/84 DATE

A. NISHIMURA	A. NISHIMURA	548-7490	MAR., 1984
DESIGNED BY	P. S. & E. BY	PHONE	DATE

DD-13-1