INDEX TO DRAWINGS	
SHEET NO.	DESCRIPTION
1	TITLE SHEET
2	STANDARD PLANS SUMMARY
3	MAIPALAOA BRIDGE REPAIR DETAIL
4	TYPICAL BRIDGE REPAIR DETAIL

FED. ROAD DIST. NO.	STATE	PROJ. NO.	FISCAL YEAR	SHEET NO.	TOTAL SHEETS
HAWAII	HAW.	93A-01-91M	1991	1	4

STATE OF HAWAII

DEPARTMENT OF TRANSPORTATION

HIGHWAYS DIVISION

HONOLULU, HAWAII

"AS-BUILT"

PLANS FOR

FARRINGTON HIGHWAY

MAIPALAOA BRIDGE REPAIR

PROJECT NO. 93A-01-91M

DISTRICT OF WAIANAE

ISLAND OF OAHU

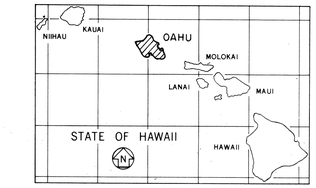

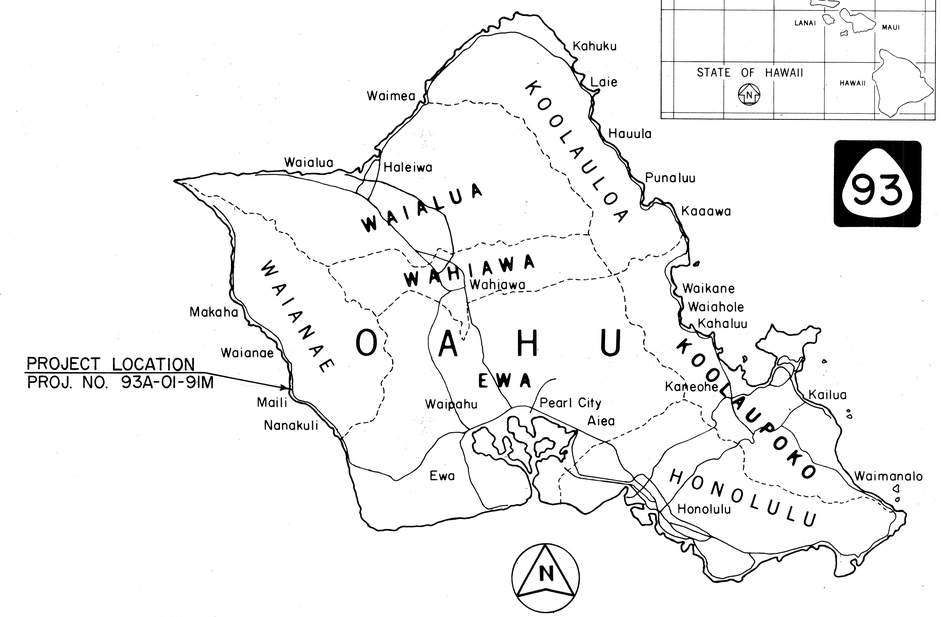

MILE POST 8.32 TO MILE POST ____

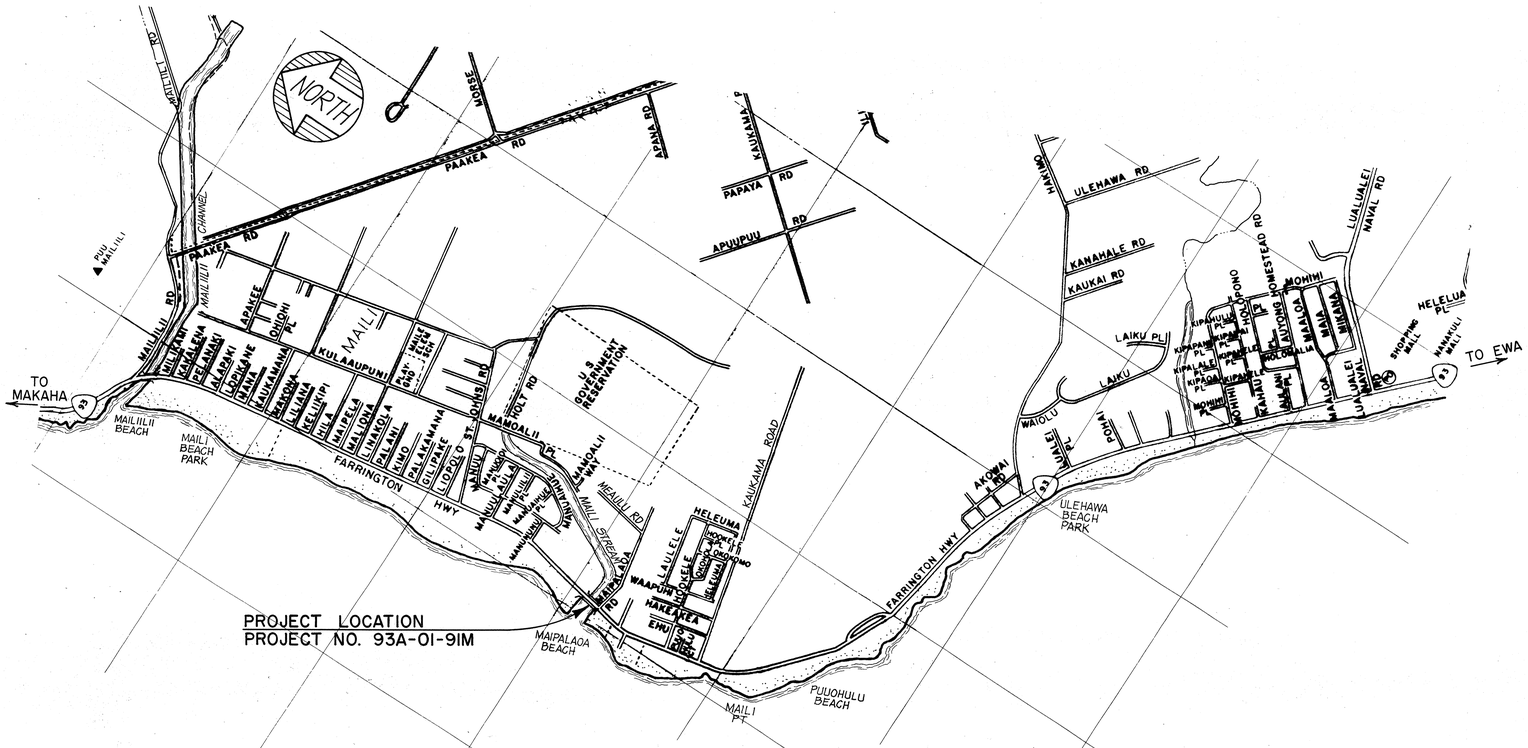

LOCATION PLAN

0 1 2 3

SCALE IN THOUSAND FEET

NO SIGNIFICANT CHANGES WERE MADE DURING CONSTRUCTION ON THESE PLANS EXCEPT CHANGES IN THE ORIGINAL THEORETICAL QUANTITIES. FOR ACTUAL QUANTITIES, REFER TO PROJECT LEDGER AND/OR COMPUTATION BOOK.

Michael Dmiega — RESIDENT ENGINEER — 10/9/91 DATE

HWY-DB	DESIGNED BY
J. KASAMOTO	P. S. & E. BY
548-7537	PHONE
AUG. 1990	DATE

DEPARTMENT OF TRANSPORTATION
STATE OF HAWAII

APPROVED:

Edward Hirata — DIR. OF TRANSPORTATION — 9/4/90 DATE