FED. ROAD DIST. NO.	STATE	FED. AID PROJ. NO.	FISCAL YEAR	SHEET NO.	TOTAL SHEETS
HAWAII	HAW.	STP-093-1(12)	1994	1	41

INDEX TO DRAWINGS

SHEET NO.	DESCRIPTION
1	TITLE SHEET
2	STANDARD PLANS SUMMARY
3	GENERAL NOTES AND LEGEND
4	NPDES GENERAL NOTES
5–7	TYPICAL SECTIONS & DETAILS
8–20	ROADWAY PLANS
21–23	DRAINAGE DETAILS
24	CULVERT EXTENSION AT STA. 1061+80
25	METAL GUARDRAIL ON CULVERT AT STA. 197+45
26–41	TRAFFIC PLANS

STATE OF HAWAII

DEPARTMENT OF TRANSPORTATION

HIGHWAYS DIVISION

HONOLULU, HAWAII

"AS-BUILT"

PLANS FOR

FARRINGTON HIGHWAY RESURFACING

MAKAU ST. TO SATELLITE TRACKING STATION RD.

Federal Aid Project No. STP-093-1(12)

DISTRICT OF WAIANAE

ISLAND OF OAHU

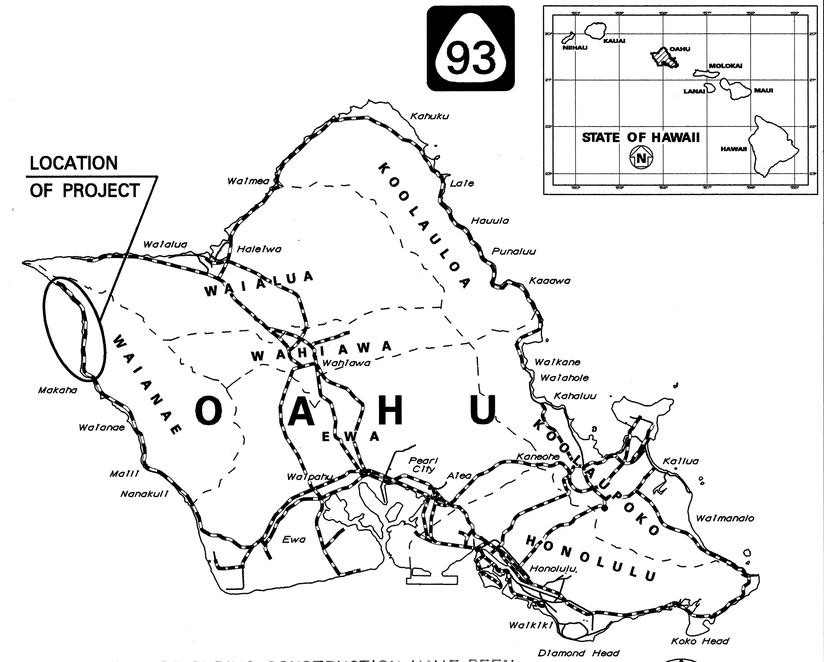

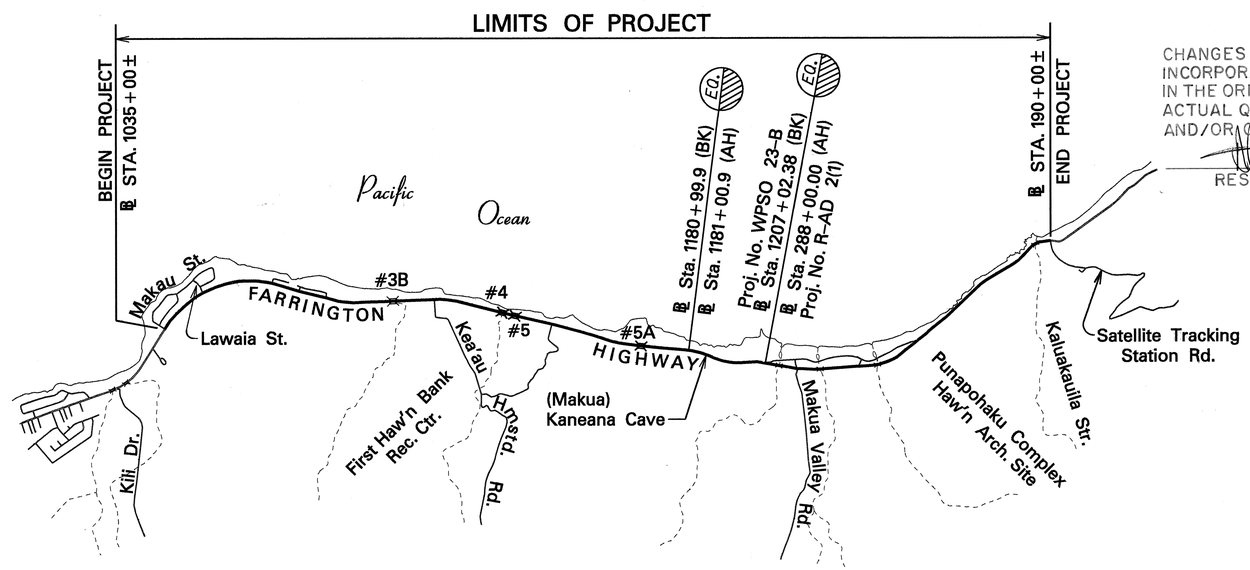

CHANGES MADE DURING CONSTRUCTION HAVE BEEN INCORPORATED ON THESE PLANS EXCEPT CHANGES IN THE ORIGINAL THEORETICAL QUANTITIES. FOR ACTUAL QUANTITIES, REFER TO PROJECT LEDGER AND/OR COMPUTATION BOOK.

RESIDENT ENGINEER — 1/10/00 DATE

SCALE IN MILES: 4 0 4 8

FEDERAL AID PROJECTS PREVIOUSLY CONSTRUCTED OR UNDER CONSTRUCTION

MILE POST 14.49 TO MILE POST 19.56

DESIGN DESIGNATION

ADT (1993) 1,724
ADT (2003) 2,255
DHV 226
D 65/35
T 3%
V ..... 55 M.P.H.

LAYOUT PLAN

GROSS LENGTH OF PROJECT..... 5.07 MILES
NET LENGTH OF PROJECT..... 5.07 MILES

SCALE IN THOUSAND FEET: 2 1 0 2 4 6

DEPARTMENT OF TRANSPORTATION FEDERAL HIGHWAY ADMINISTRATION	
APPROVED:	
for DIVISION ADMINISTRATOR	6/6/94 DATE

DEPARTMENT OF TRANSPORTATION STATE OF HAWAII	
APPROVED:	
FOR DIR. OF TRANSPORTATION	6/3/94 DATE

HWY-DD/UNIT "D"	ALLAN NISHIMURA	587-2244	MAY 1994
DESIGNED BY	P. S. & E. BY	PHONE	DATE