FED. ROAD DIST. NO.	STATE	FED. AID PROJ. NO.	FISCAL YEAR	SHEET NO.	TOTAL SHEETS
HAWAII	HAW.	STP-093-1(15)	1996	1	12

INDEX TO DRAWINGS

SHEET NO.	DESCRIPTION
1	TITLE SHEET
2	STANDARD PLANS SUMMARY
3 – 5	GENERAL NOTES AND LEGEND
6 – 12	DRAINAGE PLAN

STATE OF HAWAII

DEPARTMENT OF TRANSPORTATION

HIGHWAYS DIVISION

HONOLULU, HAWAII

"AS-BUILT"

PLANS FOR

FARRINGTON HIGHWAY

DRAINAGE IMPROVEMENTS

MANUULAULA STREET TO MAILI STREAM

FEDERAL AID PROJ. NO. STP-093-1(15)

DISTRICT OF WAIANAE

ISLAND OF OAHU

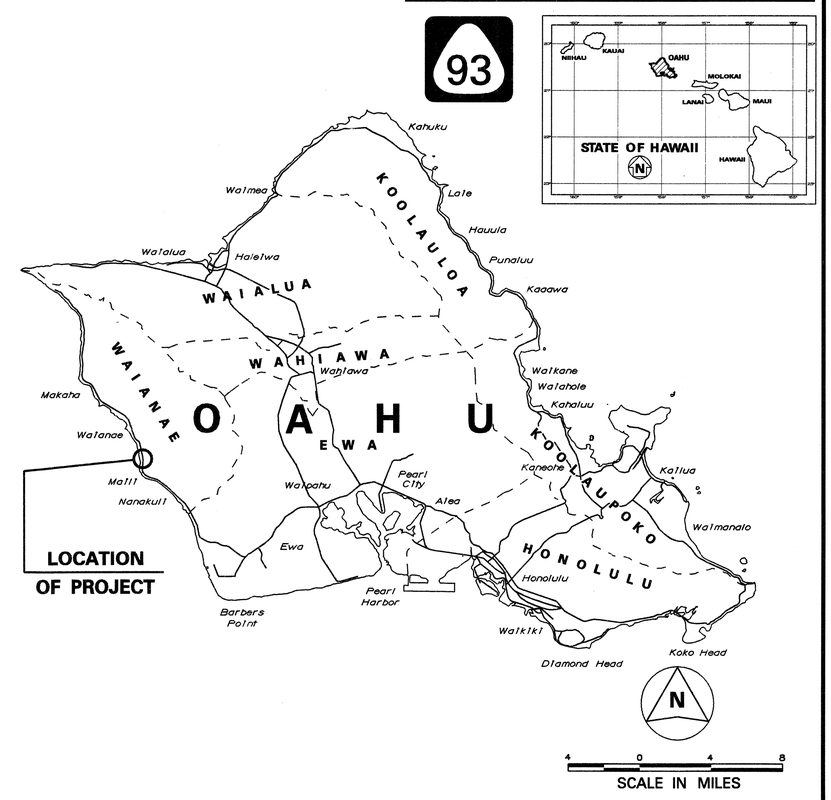

MILE POST 8.670 TO MILE POST 8.320

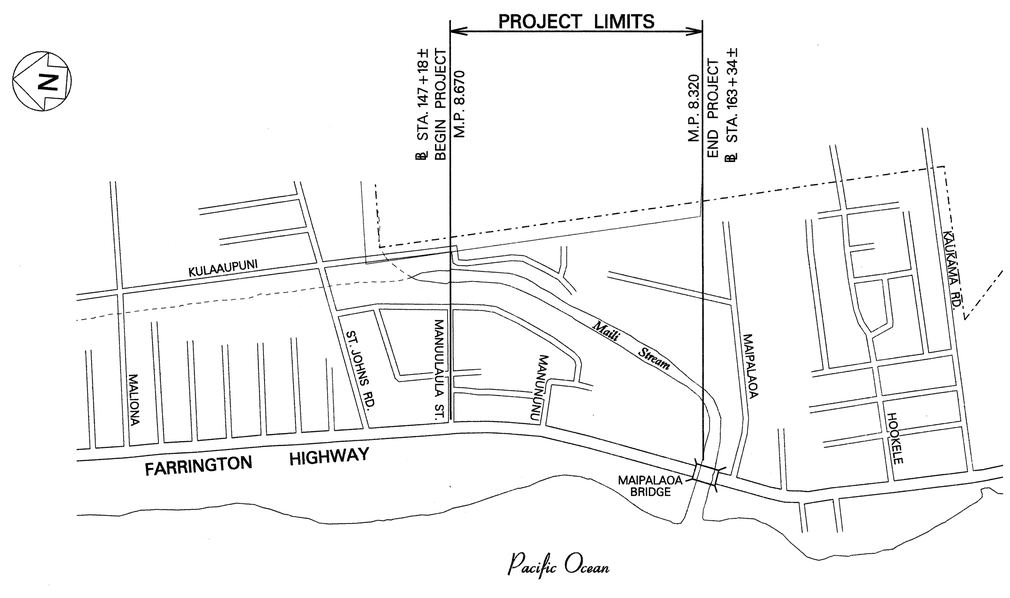

LOCATION PLAN

GROSS LENGTH OF PROJECT..... 0.350 MILES

NET LENGTH OF PROJECT..... 0.350 MILES

5 0 5 10 15

SCALE IN HUNDRED FEET

NO SIGNIFICANT CHANGES WERE MADE DURING CONSTRUCTION ON THESE PLANS EXCEPT CHANGES IN THE ORIGINAL THEORETICAL QUANTITIES. FOR ACTUAL QUANTITIES, REFER TO PROJECT LEDGER AND/OR COMPUTATION BOOK.

RESIDENT ENGINEER — DATE 7/12/99

DESIGN DESIGNATION

ADT (1996).....33,900

ADT (2006).....42,100

DHV 3,400

D 65/35

T_{DES} .....3.5 %

T_{24} .....4.0 %

V ..... 35 M.P.H.

DEPARTMENT OF TRANSPORTATION
STATE OF HAWAII

APPROVED:

DIR. OF TRANSPORTATION — DATE 5/27/96

HWY-DH — DESIGNED BY

J. FUJIMOTO — P. S. & E. BY

587-2249 — PHONE

MARCH, 1996 — DATE

7fsrdfshfdgn lgofrs jason r4-15-96