FED. ROAD DIST. NO.	STATE	FED. AID PROJ. NO.	FISCAL YEAR	SHEET NO.	TOTAL SHEETS
HAWAII	HAW.	93A-01-97M	1997	1	31

93

INDEX TO DRAWINGS

SHEET NO.	DESCRIPTION
1	TITLE SHEET
2	STANDARD PLANS SUMMARY
3	GENERAL NOTES AND LEGEND
4	UTILITY NOTES
5 – 7	TYPICAL SECTIONS AND DETAILS
8 – 17	ROADWAY PLAN
ⓘ18 – 31	PAVEMENT MARKINGS AND SIGNING PLANS

Plan Sht. Nos. ⓘ28S-1 and 28S-2 & 30S-1 and 31S-1 are supplemental sheets to this project. TOTAL SHEET COUNT after "AS-BUILT" posting 35 Sheets.

STATE OF HAWAII

DEPARTMENT OF TRANSPORTATION

HIGHWAYS DIVISION

HONOLULU, HAWAII

"AS-BUILT"

PLANS FOR

FARRINGTON HIGHWAY RESURFACING

HOOKELE STREET TO PILIOKOE BRIDGE

PROJECT NO. 93A-01-97M

DISTRICTS OF EWA AND WAIANAE

ISLAND OF OAHU

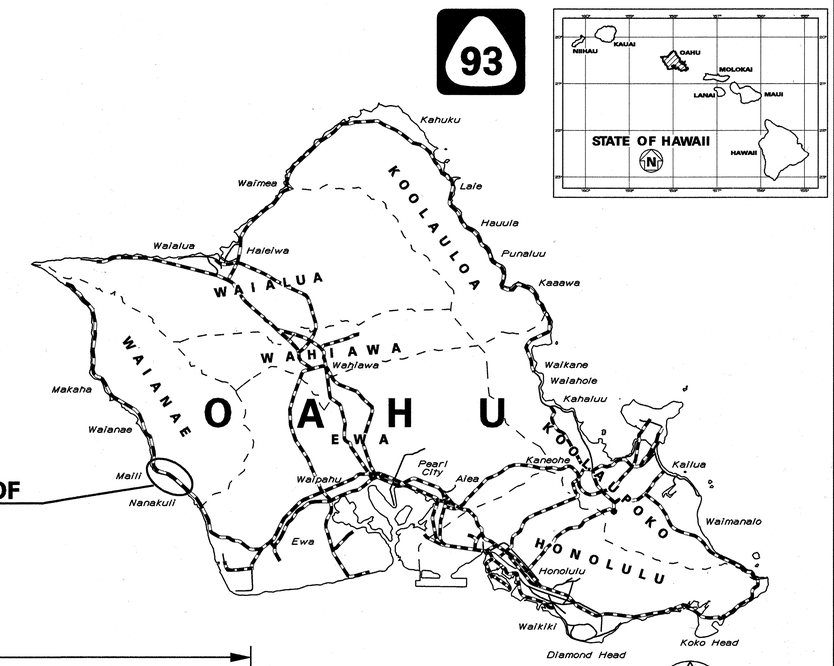

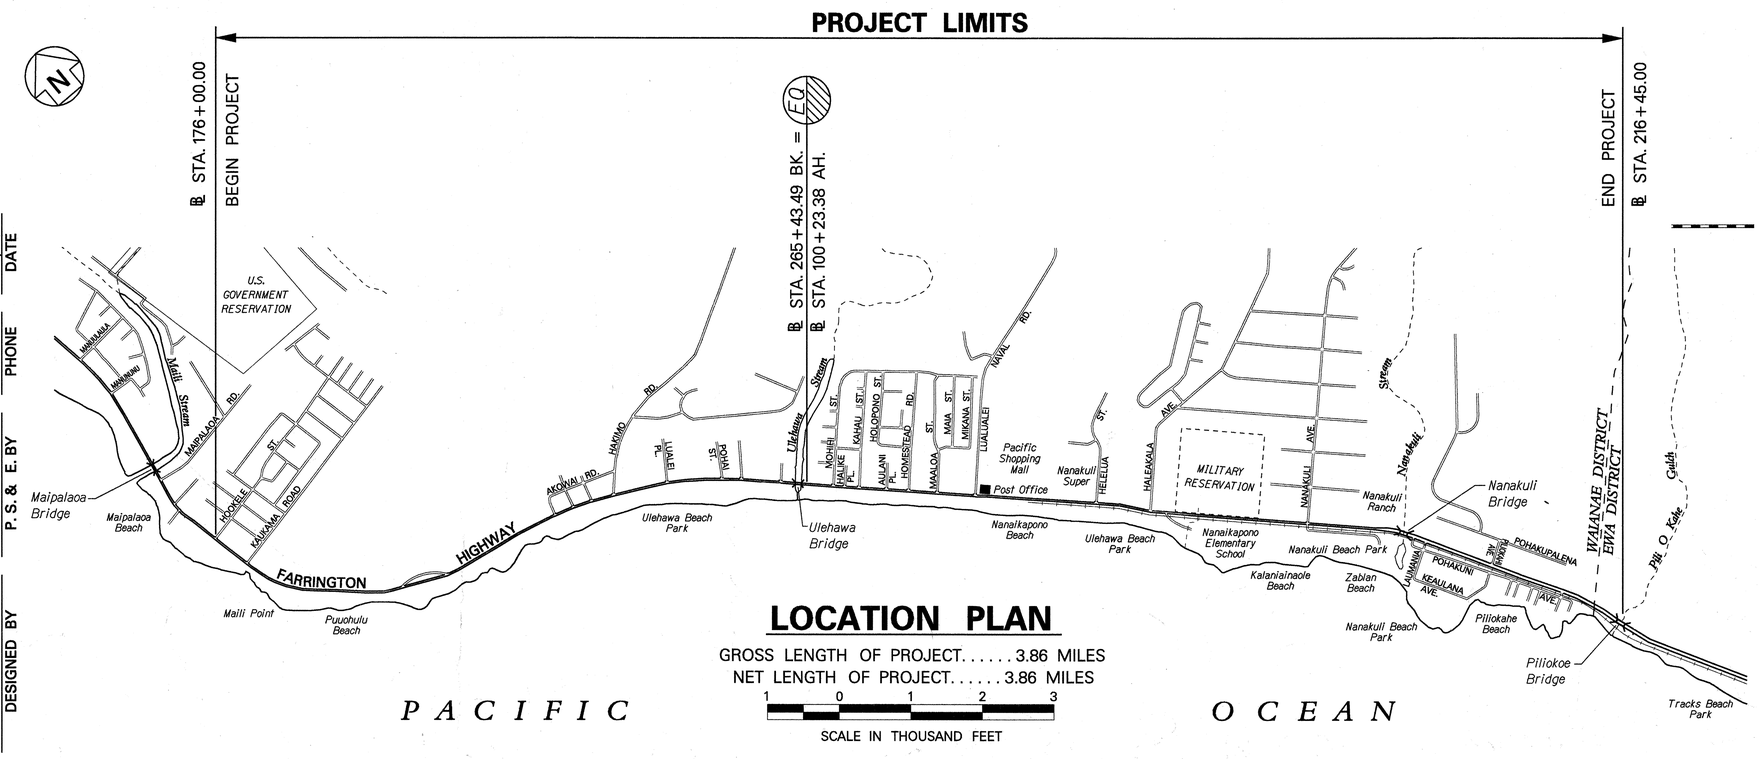

LOCATION PLAN

GROSS LENGTH OF PROJECT.....3.86 MILES

NET LENGTH OF PROJECT.....3.86 MILES

1 0 1 2 3

SCALE IN THOUSAND FEET

N

4 0 4 8

SCALE IN MILES

FEDERAL AID PROJECTS PREVIOUSLY CONSTRUCTED OR UNDER CONSTRUCTION

MILE POST 8.06 TO MILE POST 4.20

CHANGES MADE DURING CONSTRUCTION HAVE BEEN INCORPORATED ON THESE PLANS EXCEPT CHANGES IN THE ORIGINAL THEORETICAL QUANTITIES. FOR ACTUAL QUANTITIES, REFER TO PROJECT LEDGER AND/OR COMPUTATION BOOK.

RESIDENT ENGINEER — DATE 4/6/99

DEPARTMENT OF TRANSPORTATION
STATE OF HAWAII

APPROVED:

DIR. OF TRANSPORTATION — DATE 6/2/97

UNIT "C" — DESIGNED BY R. HIRONAKA, P. S. & E. BY — 587-2250 PHONE — JAN. 1997 DATE

afardtshdgn logfile jason 11-30-97