FED. ROAD DIST. NO.	STATE	PROJ. NO.	FISCAL YEAR	SHEET NO.	TOTAL SHEETS
HAWAII	HAW.	93A-08-98	2000	1	18

93

STATE OF HAWAII

DEPARTMENT OF TRANSPORTATION

HIGHWAYS DIVISION

HONOLULU, HAWAII

"AS-BUILT" PLANS FOR

FARRINGTON HIGHWAY DRAINAGE IMPROVEMENTS

AUYONG HOMESTEAD ROAD TO NANAIKEOLA STREET

PROJECT NO. 93A-08-98

DISTRICTS OF EWA AND WAIANAE

ISLAND OF OAHU

INDEX TO DRAWINGS	
SHEET NO.	DESCRIPTION
1	TITLE SHEET
2	STANDARD PLANS SUMMARY
3	GENERAL NOTES AND LEGEND
4	CONSTRUCTION PHASE NOTES
5	RAILROAD DETAILS & NOTES
6 – 9	DRAINAGE PLANS
10	DRAINAGE PROFILES
(A) 11 – 15	DRAINAGE DETAILS
16	TRAFFIC SIGNAL PLAN
17	TRAFFIC SIGNAL DETAILS
18	PULLBOX & COVER DETAILS

Plan Sheet No. (A) C.O.11S-1 is a supplemental sheet to the original contract plans. New Total Sheet Count after As-Built Posting is 19 sheets.

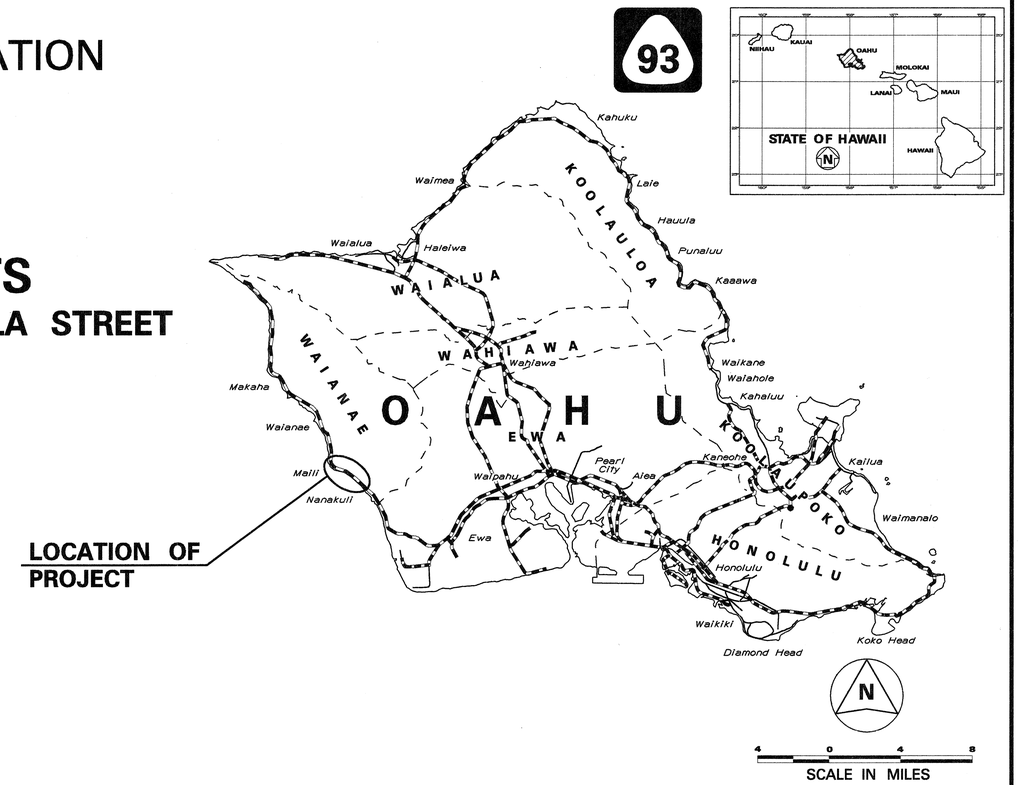

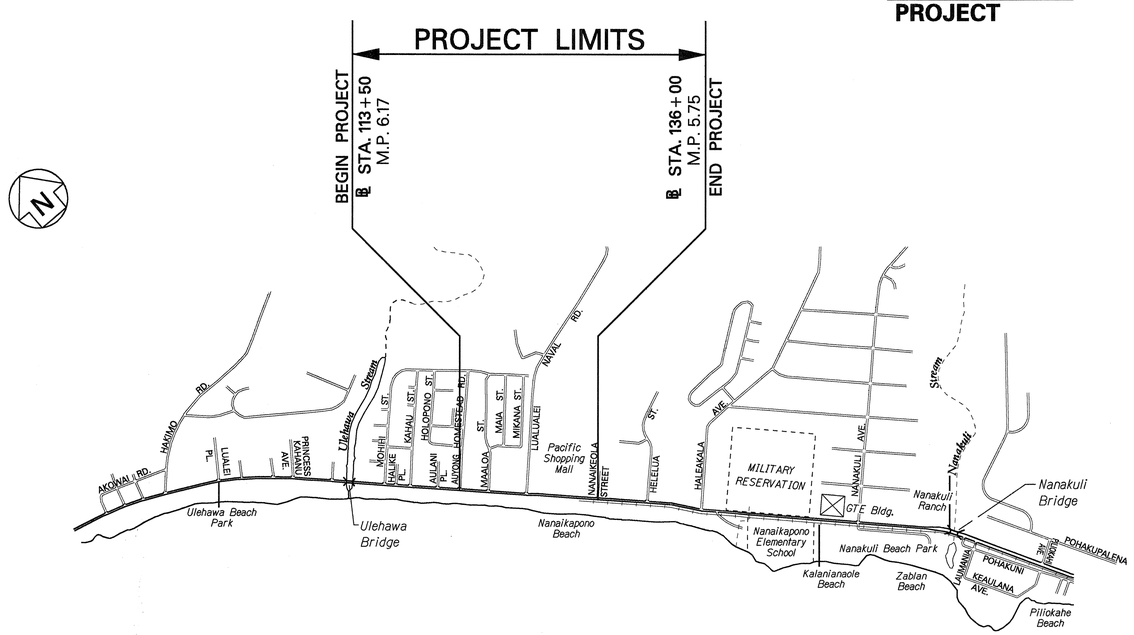

LOCATION PLAN

GROSS LENGTH OF PROJECT..... 0.42 MILES

NET LENGTH OF PROJECT..... 0.42 MILES

1 0 1 2 3

SCALE IN THOUSAND FEET

P A C I F I C O C E A N

FEDERAL AID PROJECTS PREVIOUSLY CONSTRUCTED OR UNDER CONSTRUCTION

MILE POST 5.75 TO MILE POST 6.17

NO SIGNIFICANT CHANGES WERE MADE DURING CONSTRUCTION ON THESE PLANS EXCEPT CHANGES IN THE ORIGINAL THEORETICAL QUANTITIES. FOR ACTUAL QUANTITIES, REFER TO PROJECT LEDGER AND/OR COMPUTATION BOOK.

RESIDENT ENGINEER — DATE 7/23/02

DEPARTMENT OF TRANSPORTATION STATE OF HAWAII	
APPROVED: Kazu Hayashida 3/2/00	
DIR. OF TRANSPORTATION	DATE

UNIT "E" — DESIGNED BY S. HIRAOKA — P.S. & E. BY 692-7581 — PHONE DEC., 1999 — DATE

k:\ardish\dgn logific green r1-10-00