FED. ROAD DIST. NO.	STATE	PROJ. NO.	FISCAL YEAR	SHEET NO.	TOTAL SHEETS
HAWAII	HAW.	93A-06-98	2001	1	68

93

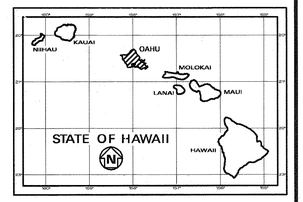

STATE OF HAWAII

DEPARTMENT OF TRANSPORTATION

HIGHWAYS DIVISION

HONOLULU, HAWAII

"AS-BUILT"

PLANS FOR

FARRINGTON HIGHWAY

INTERSECTION IMPROVEMENTS AT WAIOMEA STREET

PROJECT NO. 93A-06-98

DISTRICT OF EWA

ISLAND OF OAHU

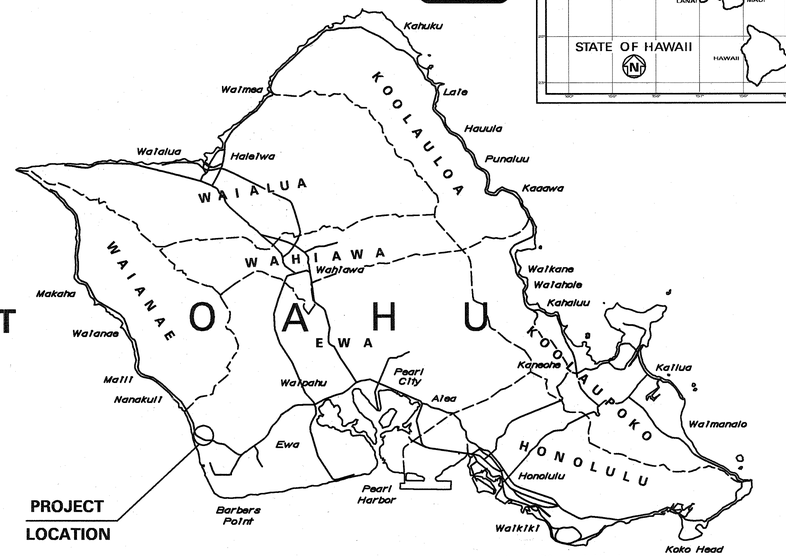

SCALE IN MILES

4 0 4 8

MILE POST 1.25 TO MILE POST 1.85

INDEX TO DRAWINGS	
SHEET NO.	DESCRIPTION
1	TITLE SHEET
2	STANDARD PLANS SUMMARY
3	GENERAL SITE PLAN
4–7	NOTES & LEGEND
8	TYPICAL SECTIONS
① 9–10	MISCELLANEOUS DETAILS
11–15	GUARDRAIL DETAILS & NOTES
16	DEMOLITION PLAN
17–19	INTERSECTION IMPROVEMENT PLAN
20–21	PROFILE – DRAINLINE
22–24	MEDIAN BARRIER MODIFICATION
25	CRASH TERMINAL DETAILS
26–27	BUS SHELTER PLAN & DETAILS
28–30	SIGNING & STRIPING PLAN
31	SIGNING & STRIPING DETAILS
32–34	TRAFFIC CONTROL PLAN
35	EROSION CONTROL PLAN
36	SIGN MOUNTING DETAIL
37–38	MEDIAN BARRIER SECTIONS & DETAILS
39	STREET LIGHT AND TRAFFIC SIGNAL SITE PLAN
40	TRAFFIC SIGNAL LEGEND & NOTES
41–47	TRAFFIC SIGNAL PLAN
② 48–54	TRAFFIC SIGNAL DETAILS
55	LOOP DETECTOR DETAILS
56	PULLBOX & COVER DETAILS
57	TYPICAL BACKFILL SECTION DETAILS
58	STREET LIGHT LEGEND & DETAILS
59–61	STREET LIGHT PLAN
62	ONE-LINE DIAGRAM AND MISCELLANEOUS DETAILS
63	STREET LIGHT CONNECTION DIAGRAM
64	METER & EQUIPMENT CABINET DETAILS
65–68	STREET LIGHT DETAILS

Plan Sheet Nos. ①C.O.9S-I and ②C.O.ADD.54S-I are supplements to this project.
TOTAL SHEET COUNT after "AS-BUILT" posting: 70 Sheets

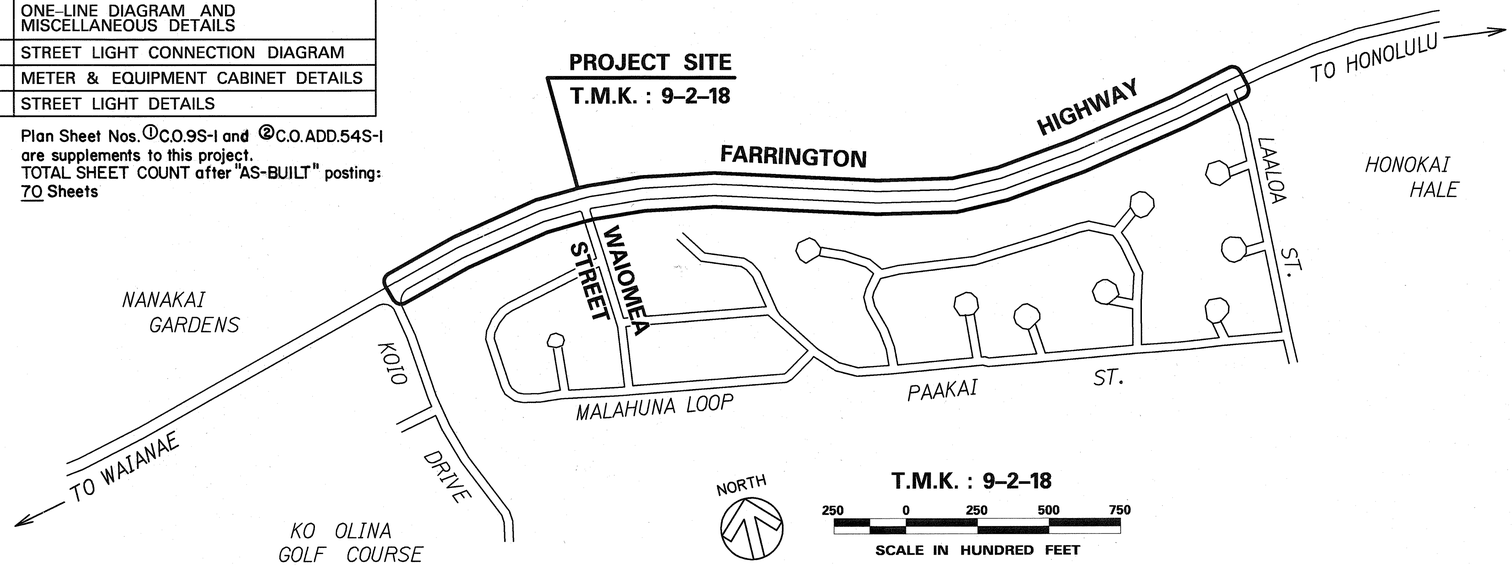

CHANGES MADE DURING CONSTRUCTION HAVE BEEN INCORPORATED ON THESE PLANS EXCEPT CHANGES IN THE ORIGINAL THEORETICAL QUANTITIES. FOR ACTUAL QUANTITIES, REFER TO PROJECT LEDGER AND/OR COMPUTATION BOOK.

RESIDENT MANAGER — DATE 7/28/08

DEPARTMENT OF TRANSPORTATION
STATE OF HAWAII

APPROVED:

DIR. OF TRANSPORTATION — DATE 8/23/00

RON HO & ASSOC. — DESIGNED BY
KARL KUNISHIGE P. S. & E. BY
692-7679 PHONE
AUG 2000 DATE